


218-85

218-85

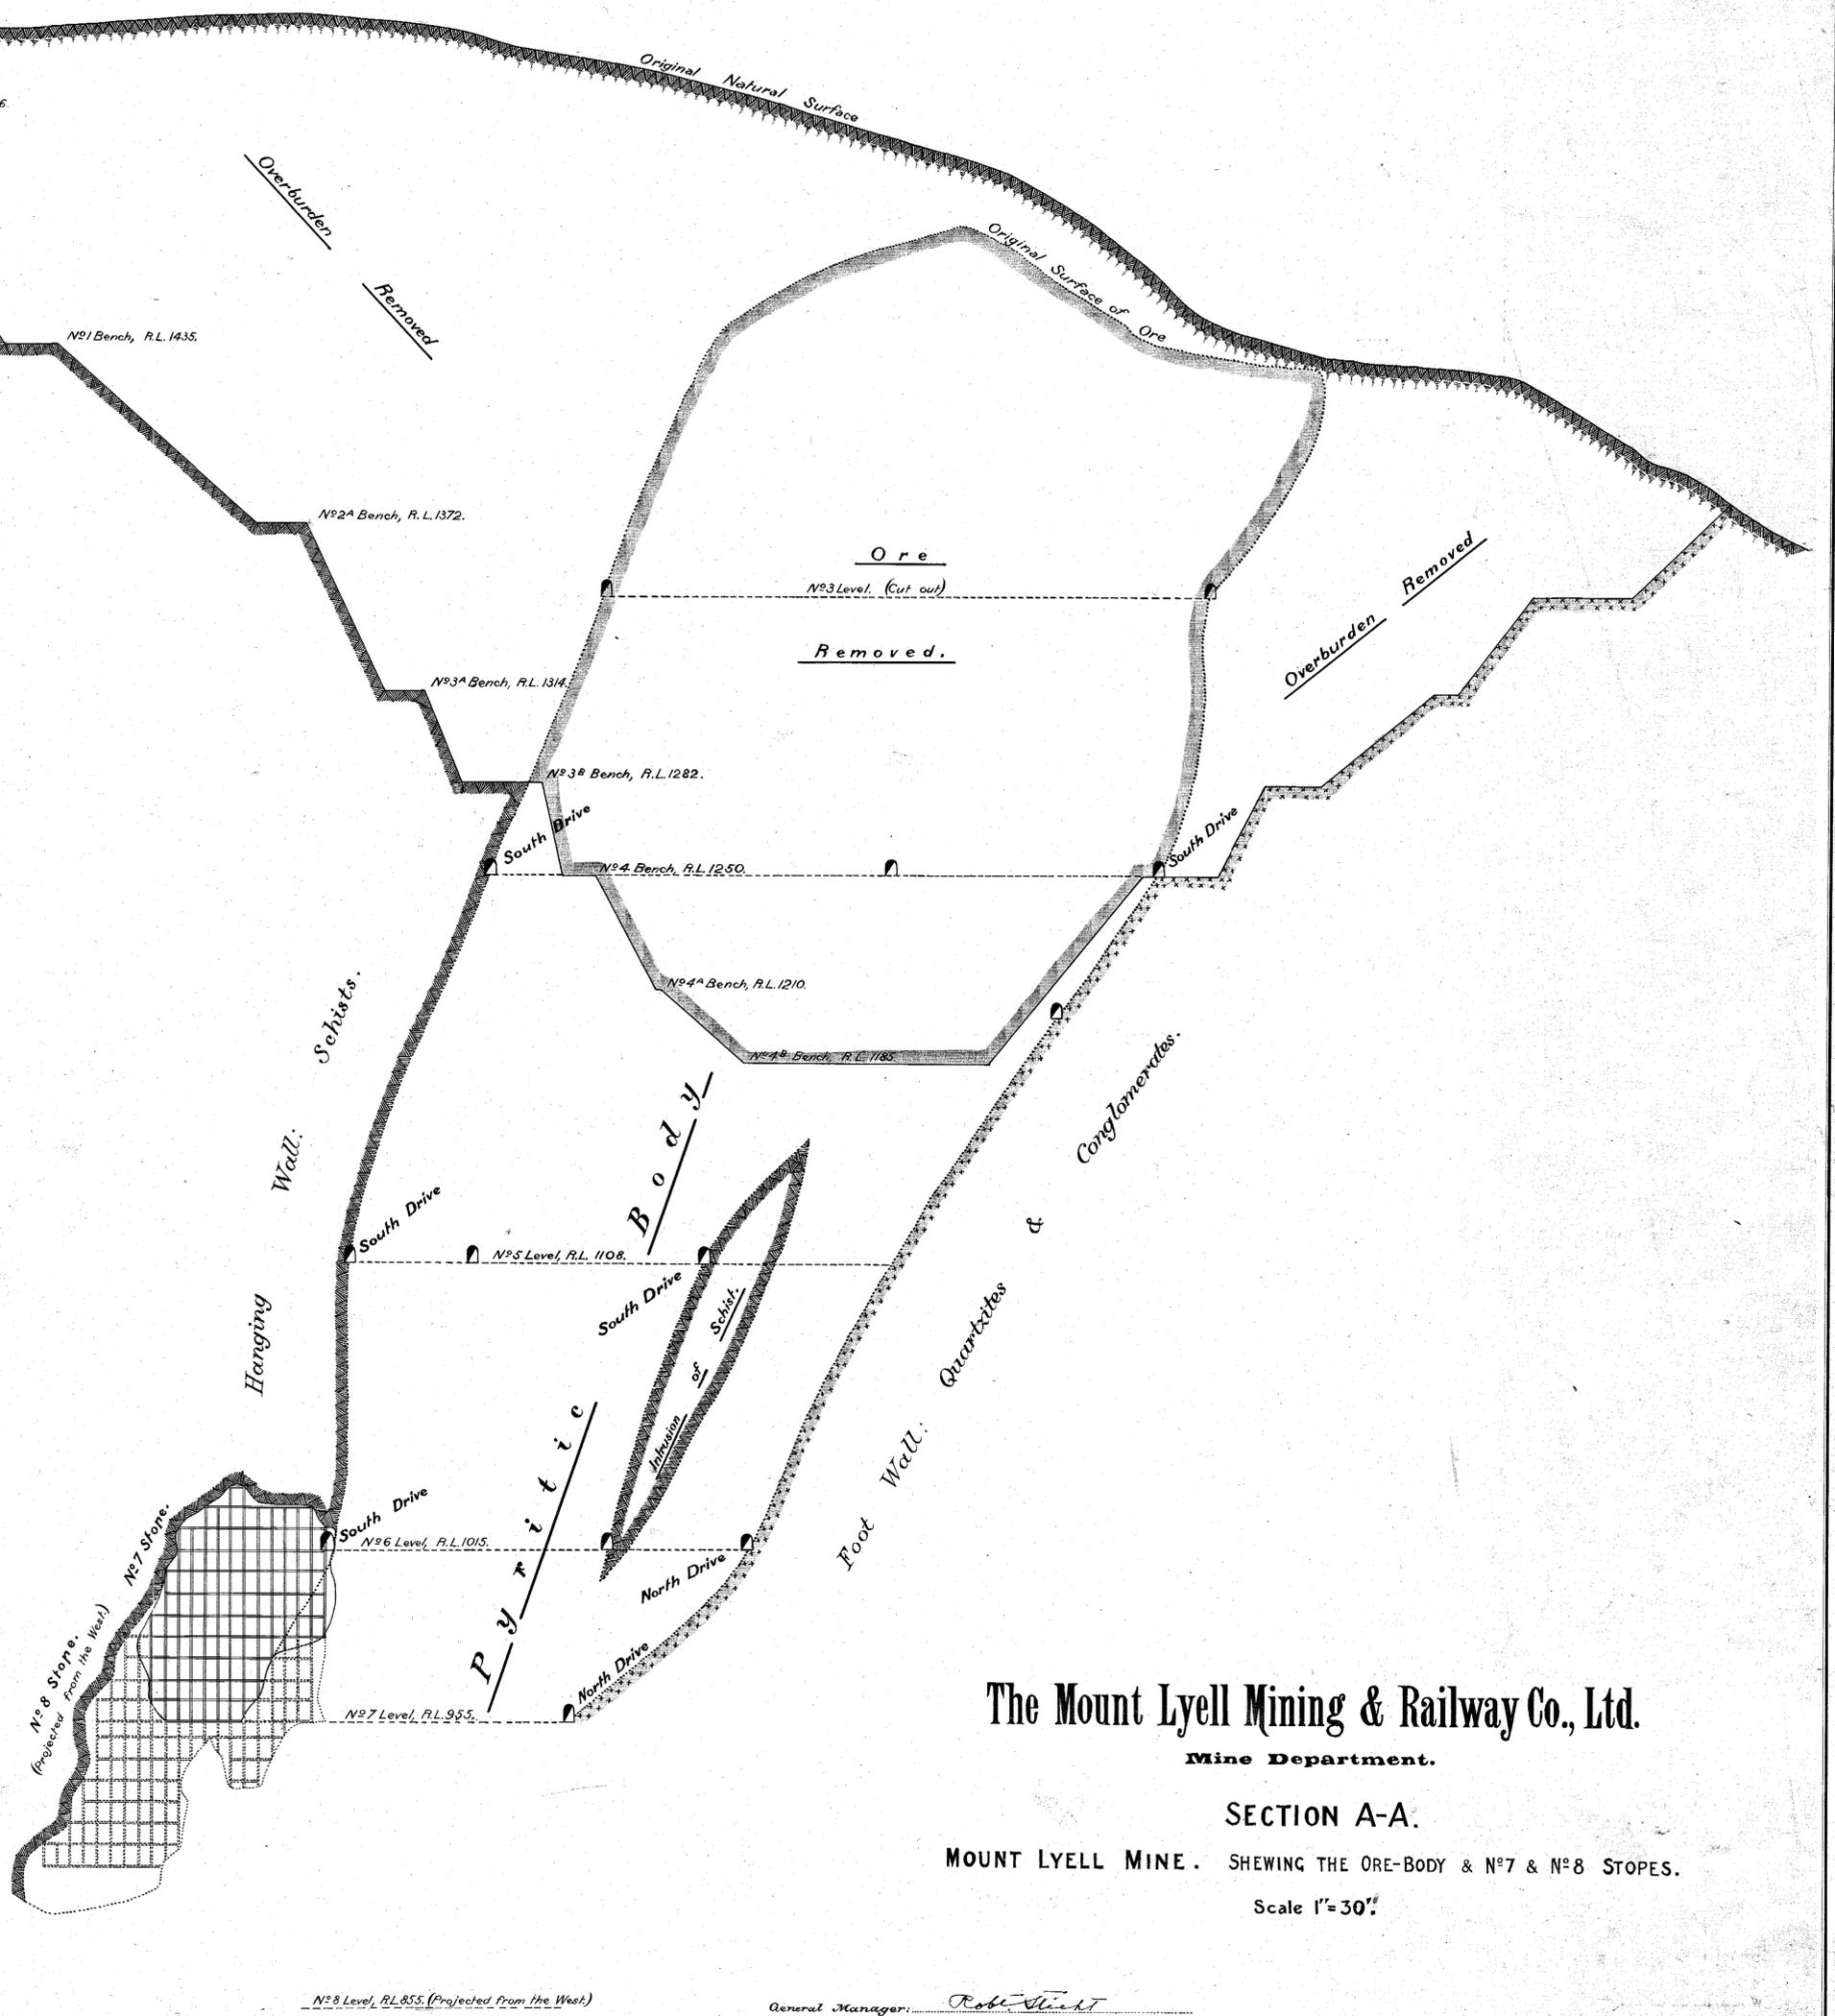

The Mount Lyell Mining & Railway Co., Ltd.

Mine Department.

SECTION A-A.

MOUNT LYELL MINE. SHEWING THE ORE-BODY & Nº 7 & Nº 8 STOPES.

Scale 1"=30'

General Manager: *Rose*

Engineer-in-Charge: *R. B. Murray*

5 cm