


218-86

218-86

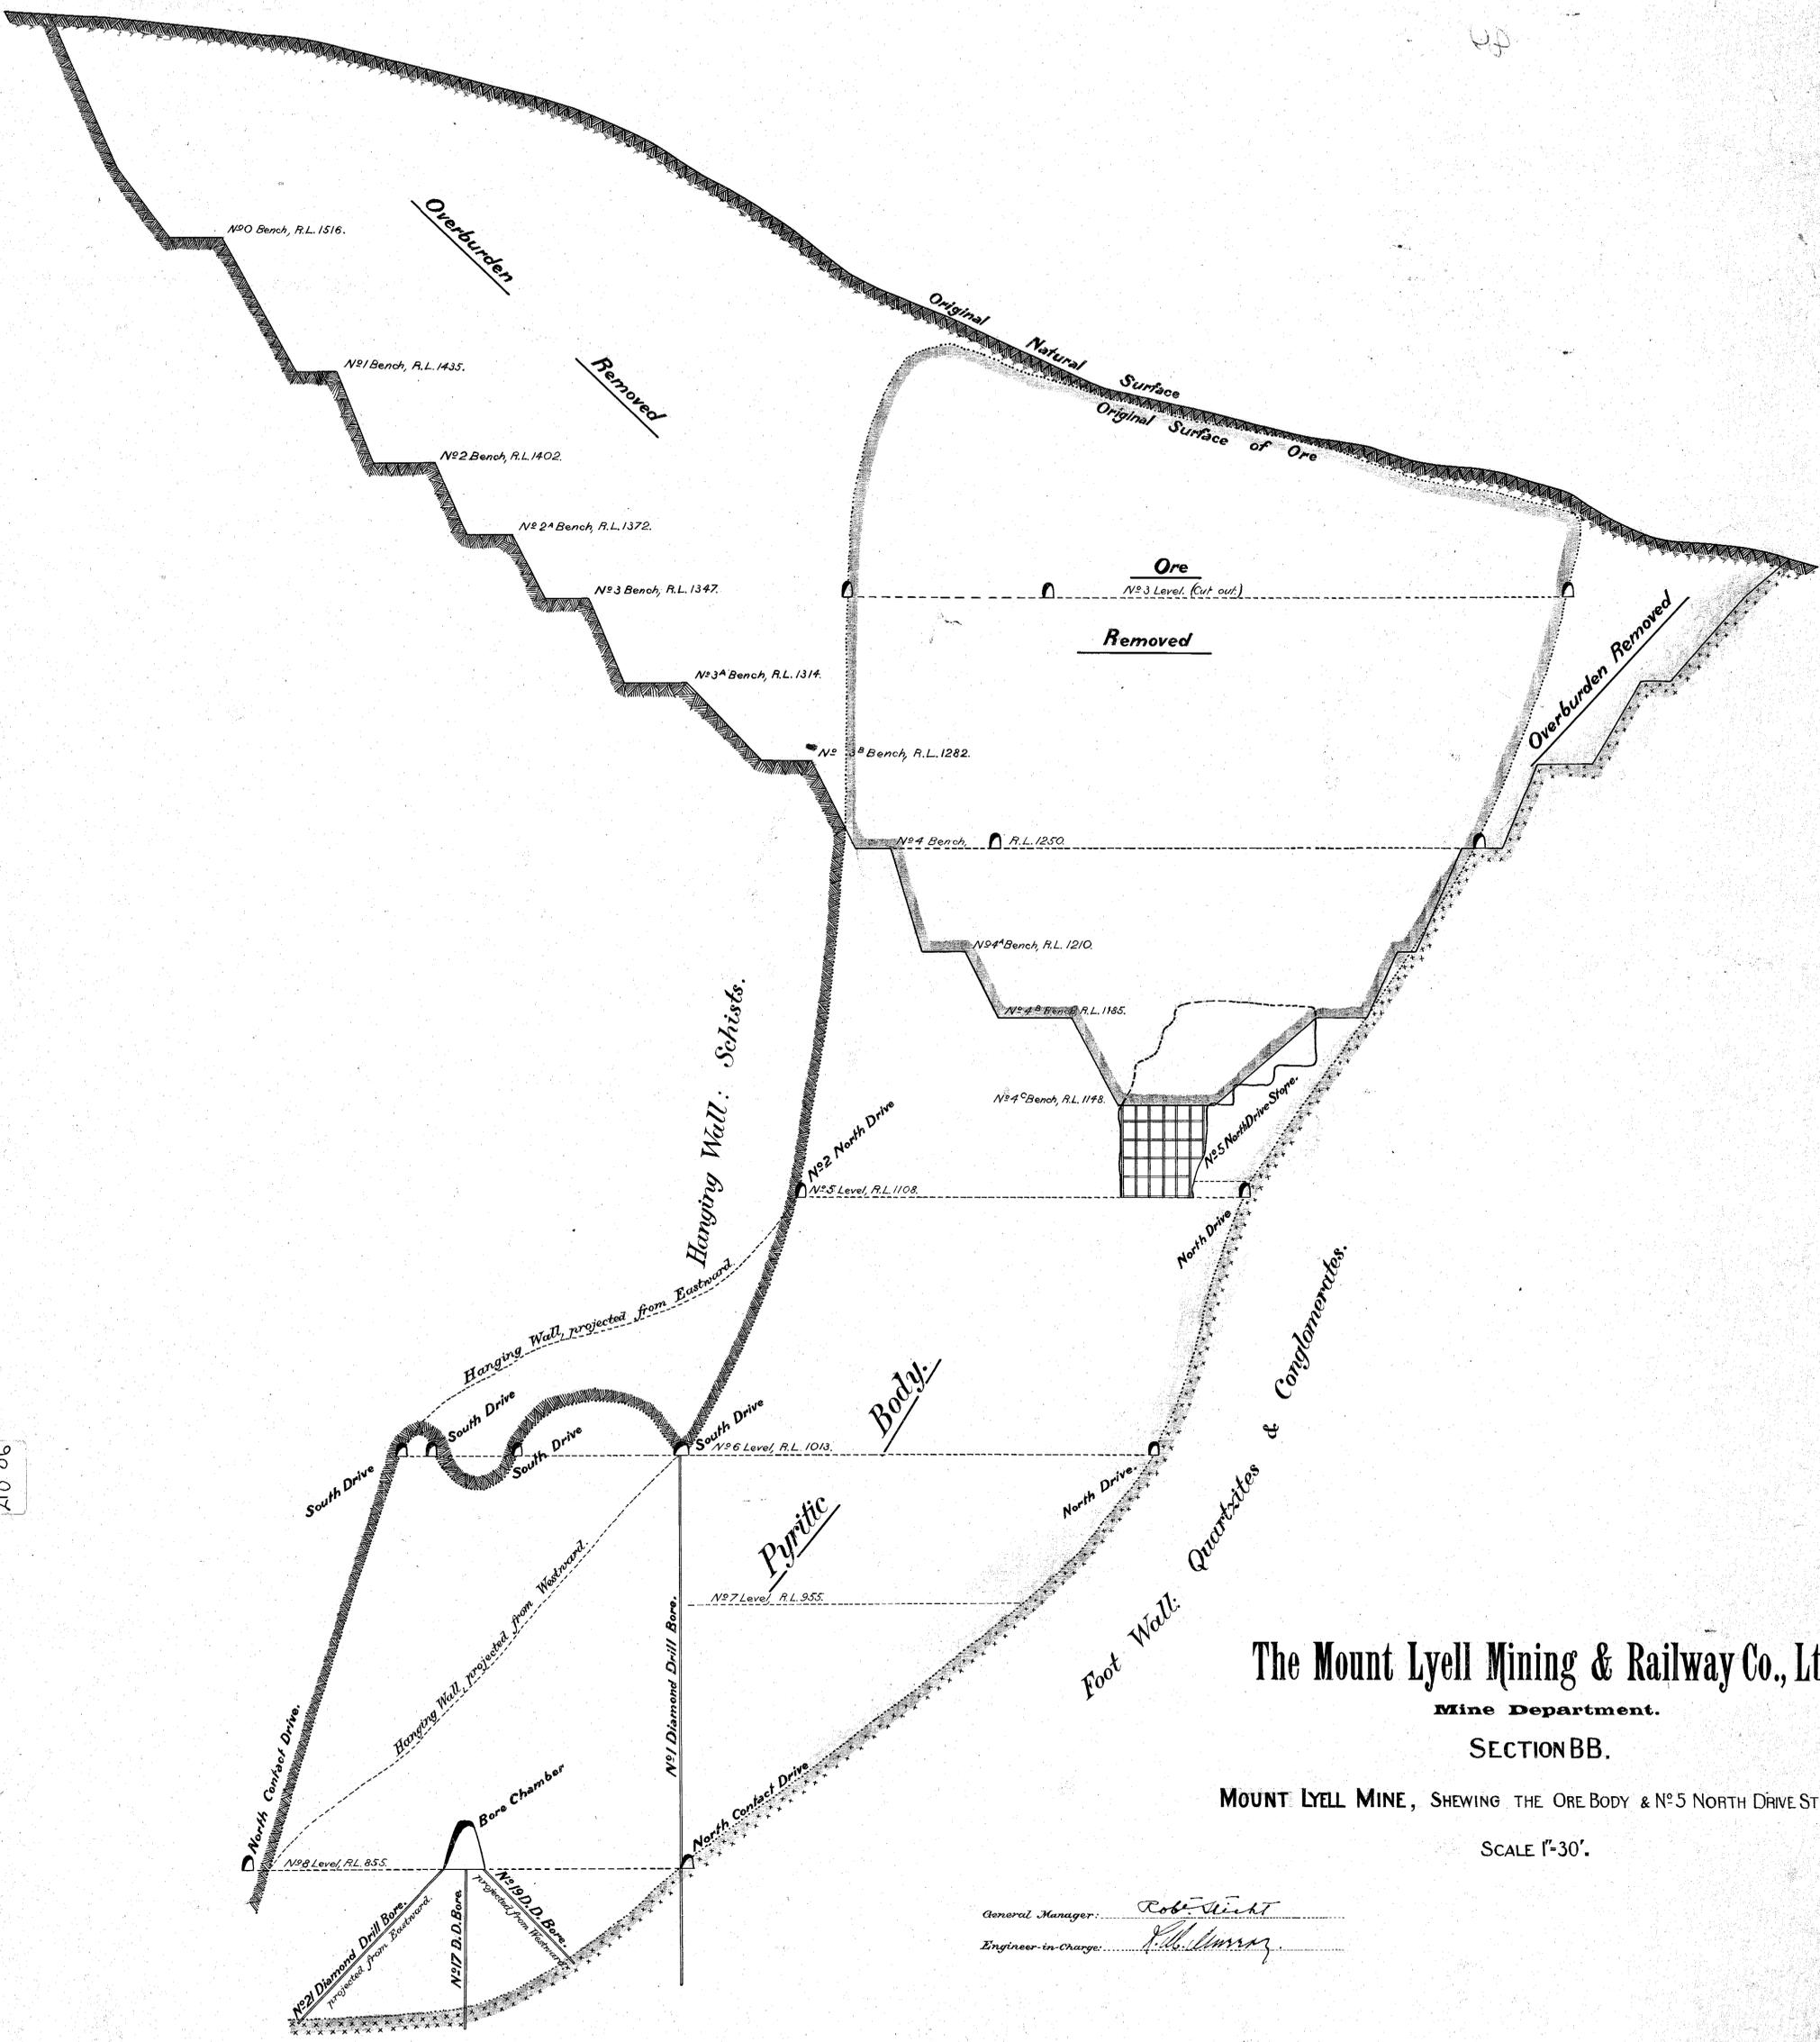

**The Mount Lyell Mining & Railway Co., Ltd.**  
 Mine Department.  
 SECTION BB.

MOUNT LYELL MINE, SHOWING THE ORE BODY & N°5 NORTH DRIVE STOPE.

SCALE 1"=30'.

General Manager: *Robert Licht*  
 Engineer-in-Charge: *R. H. Murray*