


5 cm

218-89

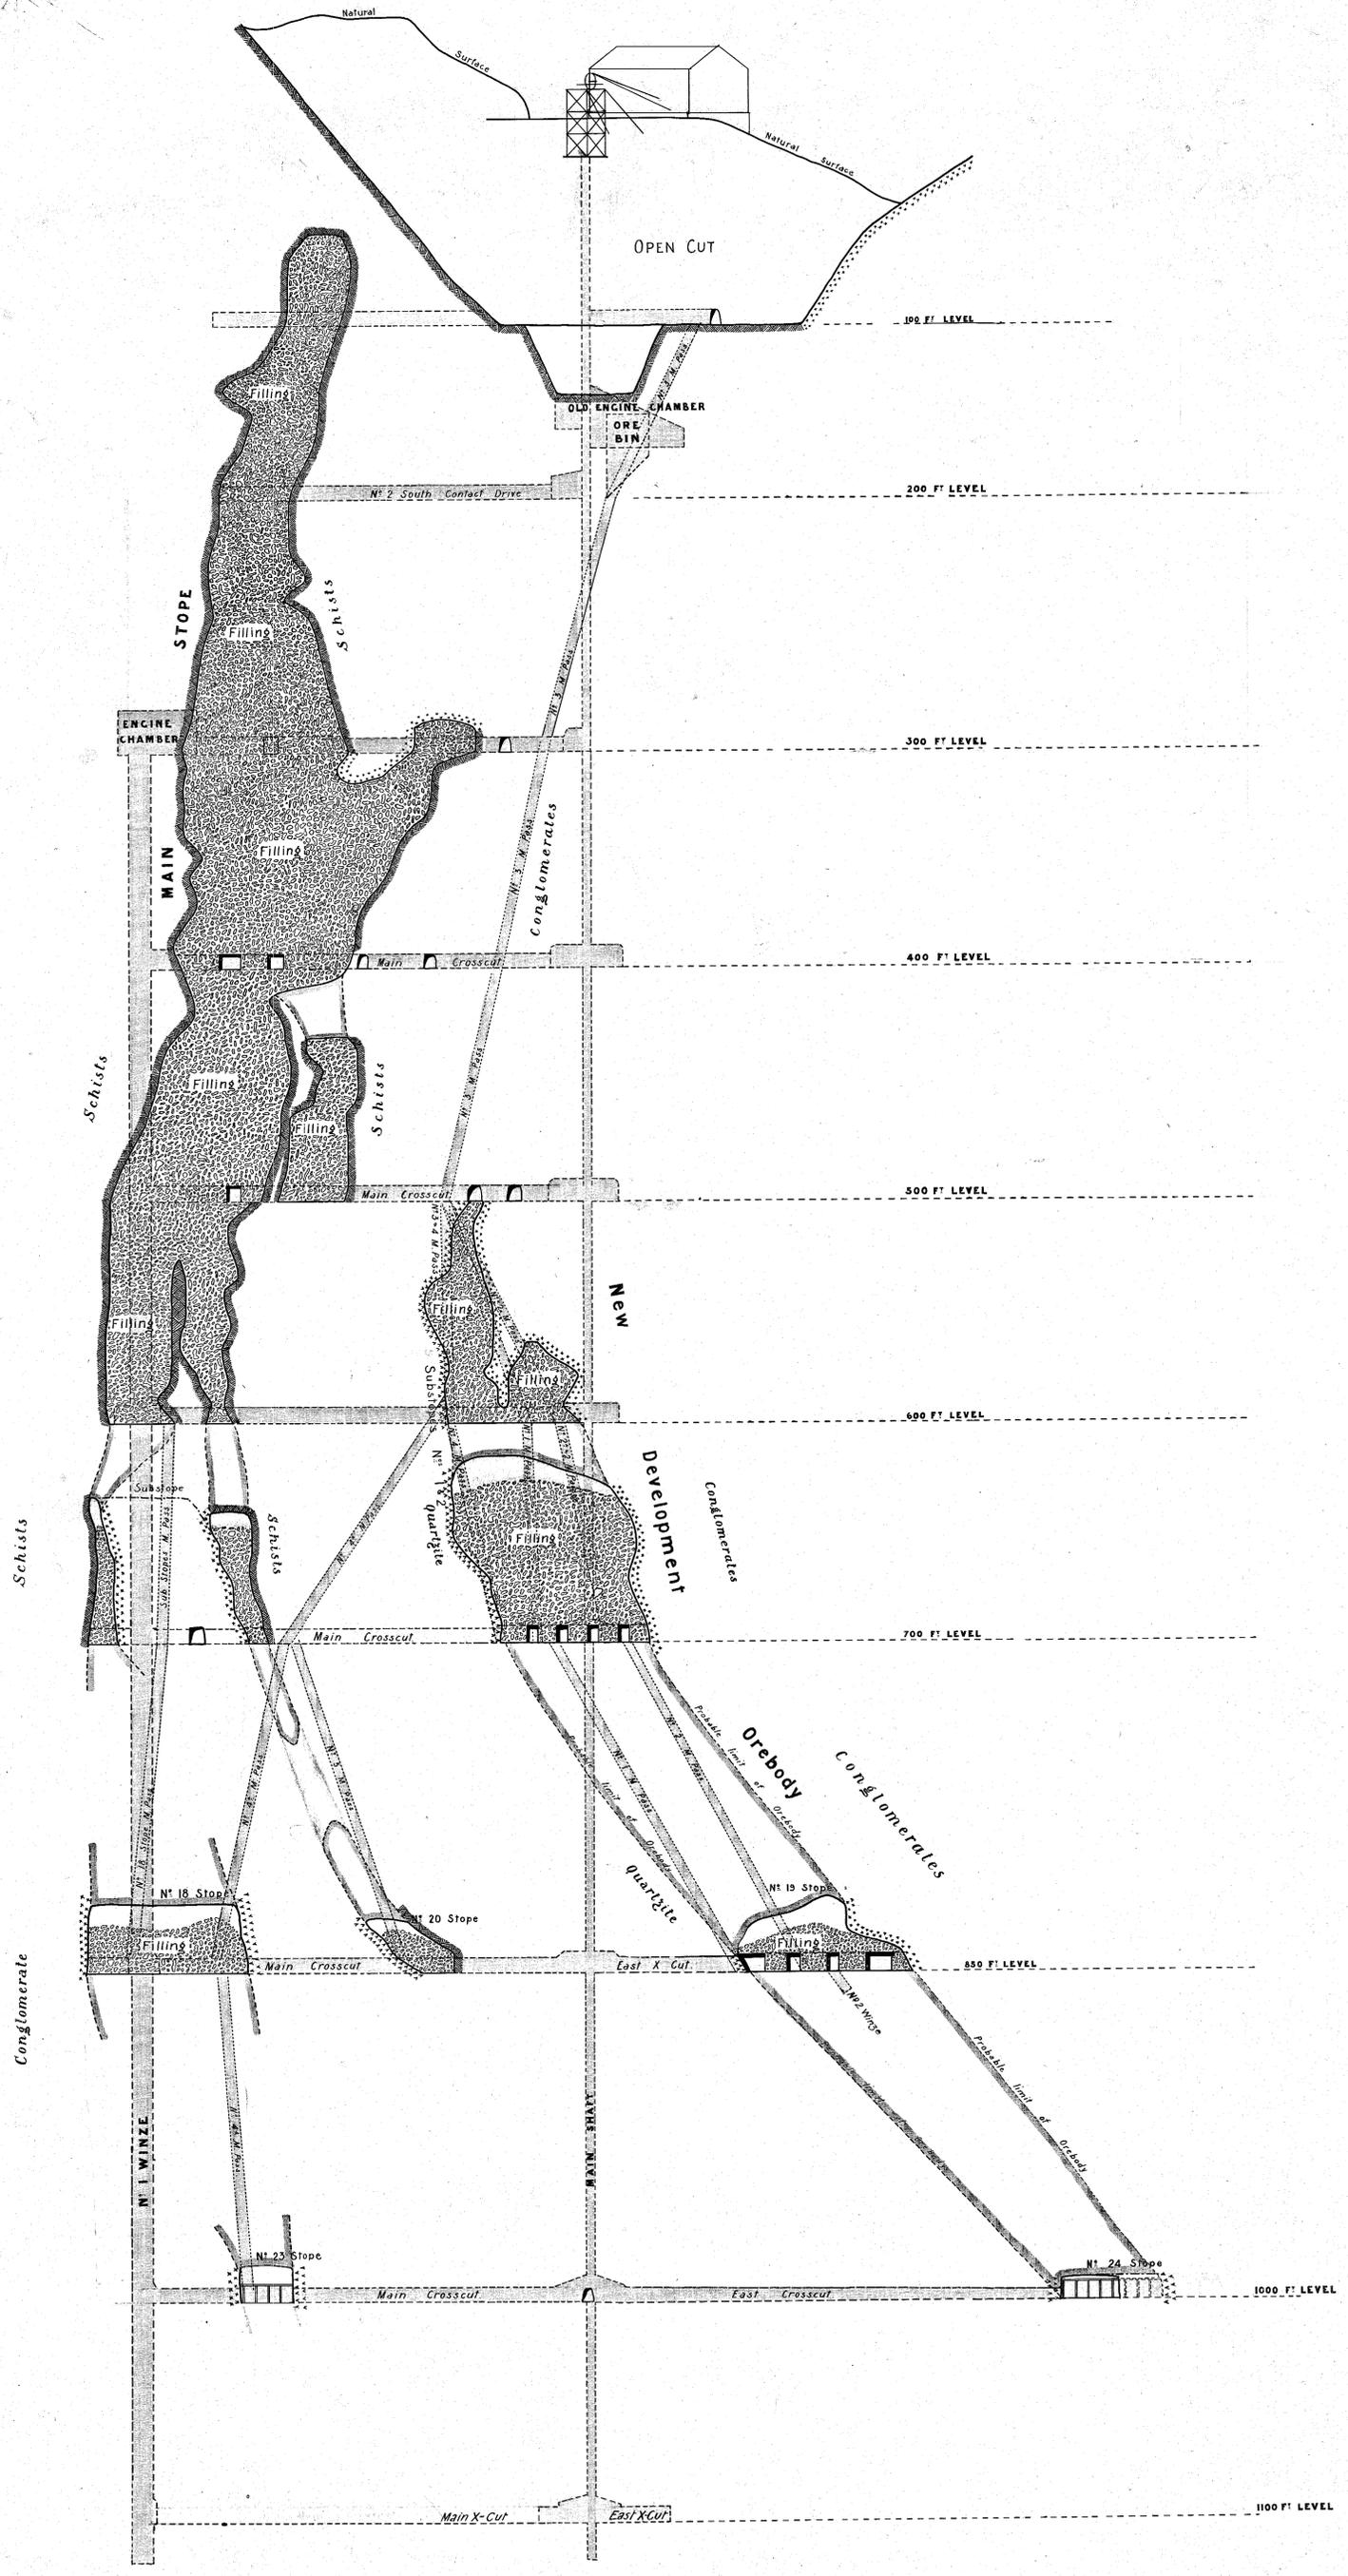

The Mount Lyell Mining & Railway Co., Ltd.

Mine Department.

NORTH LYELL MINE.

SECTION ON LINE BB LOOKING NORTH

SCALE: 1 INCH = 30 FEET.

Brought up to 30th Dec^r 1908.

General Manager *R. H. Smith*
 Engineer in Charge *R. H. Smith*