


600 FT LEVEL

400 FT LEVEL

500 FT LEVEL

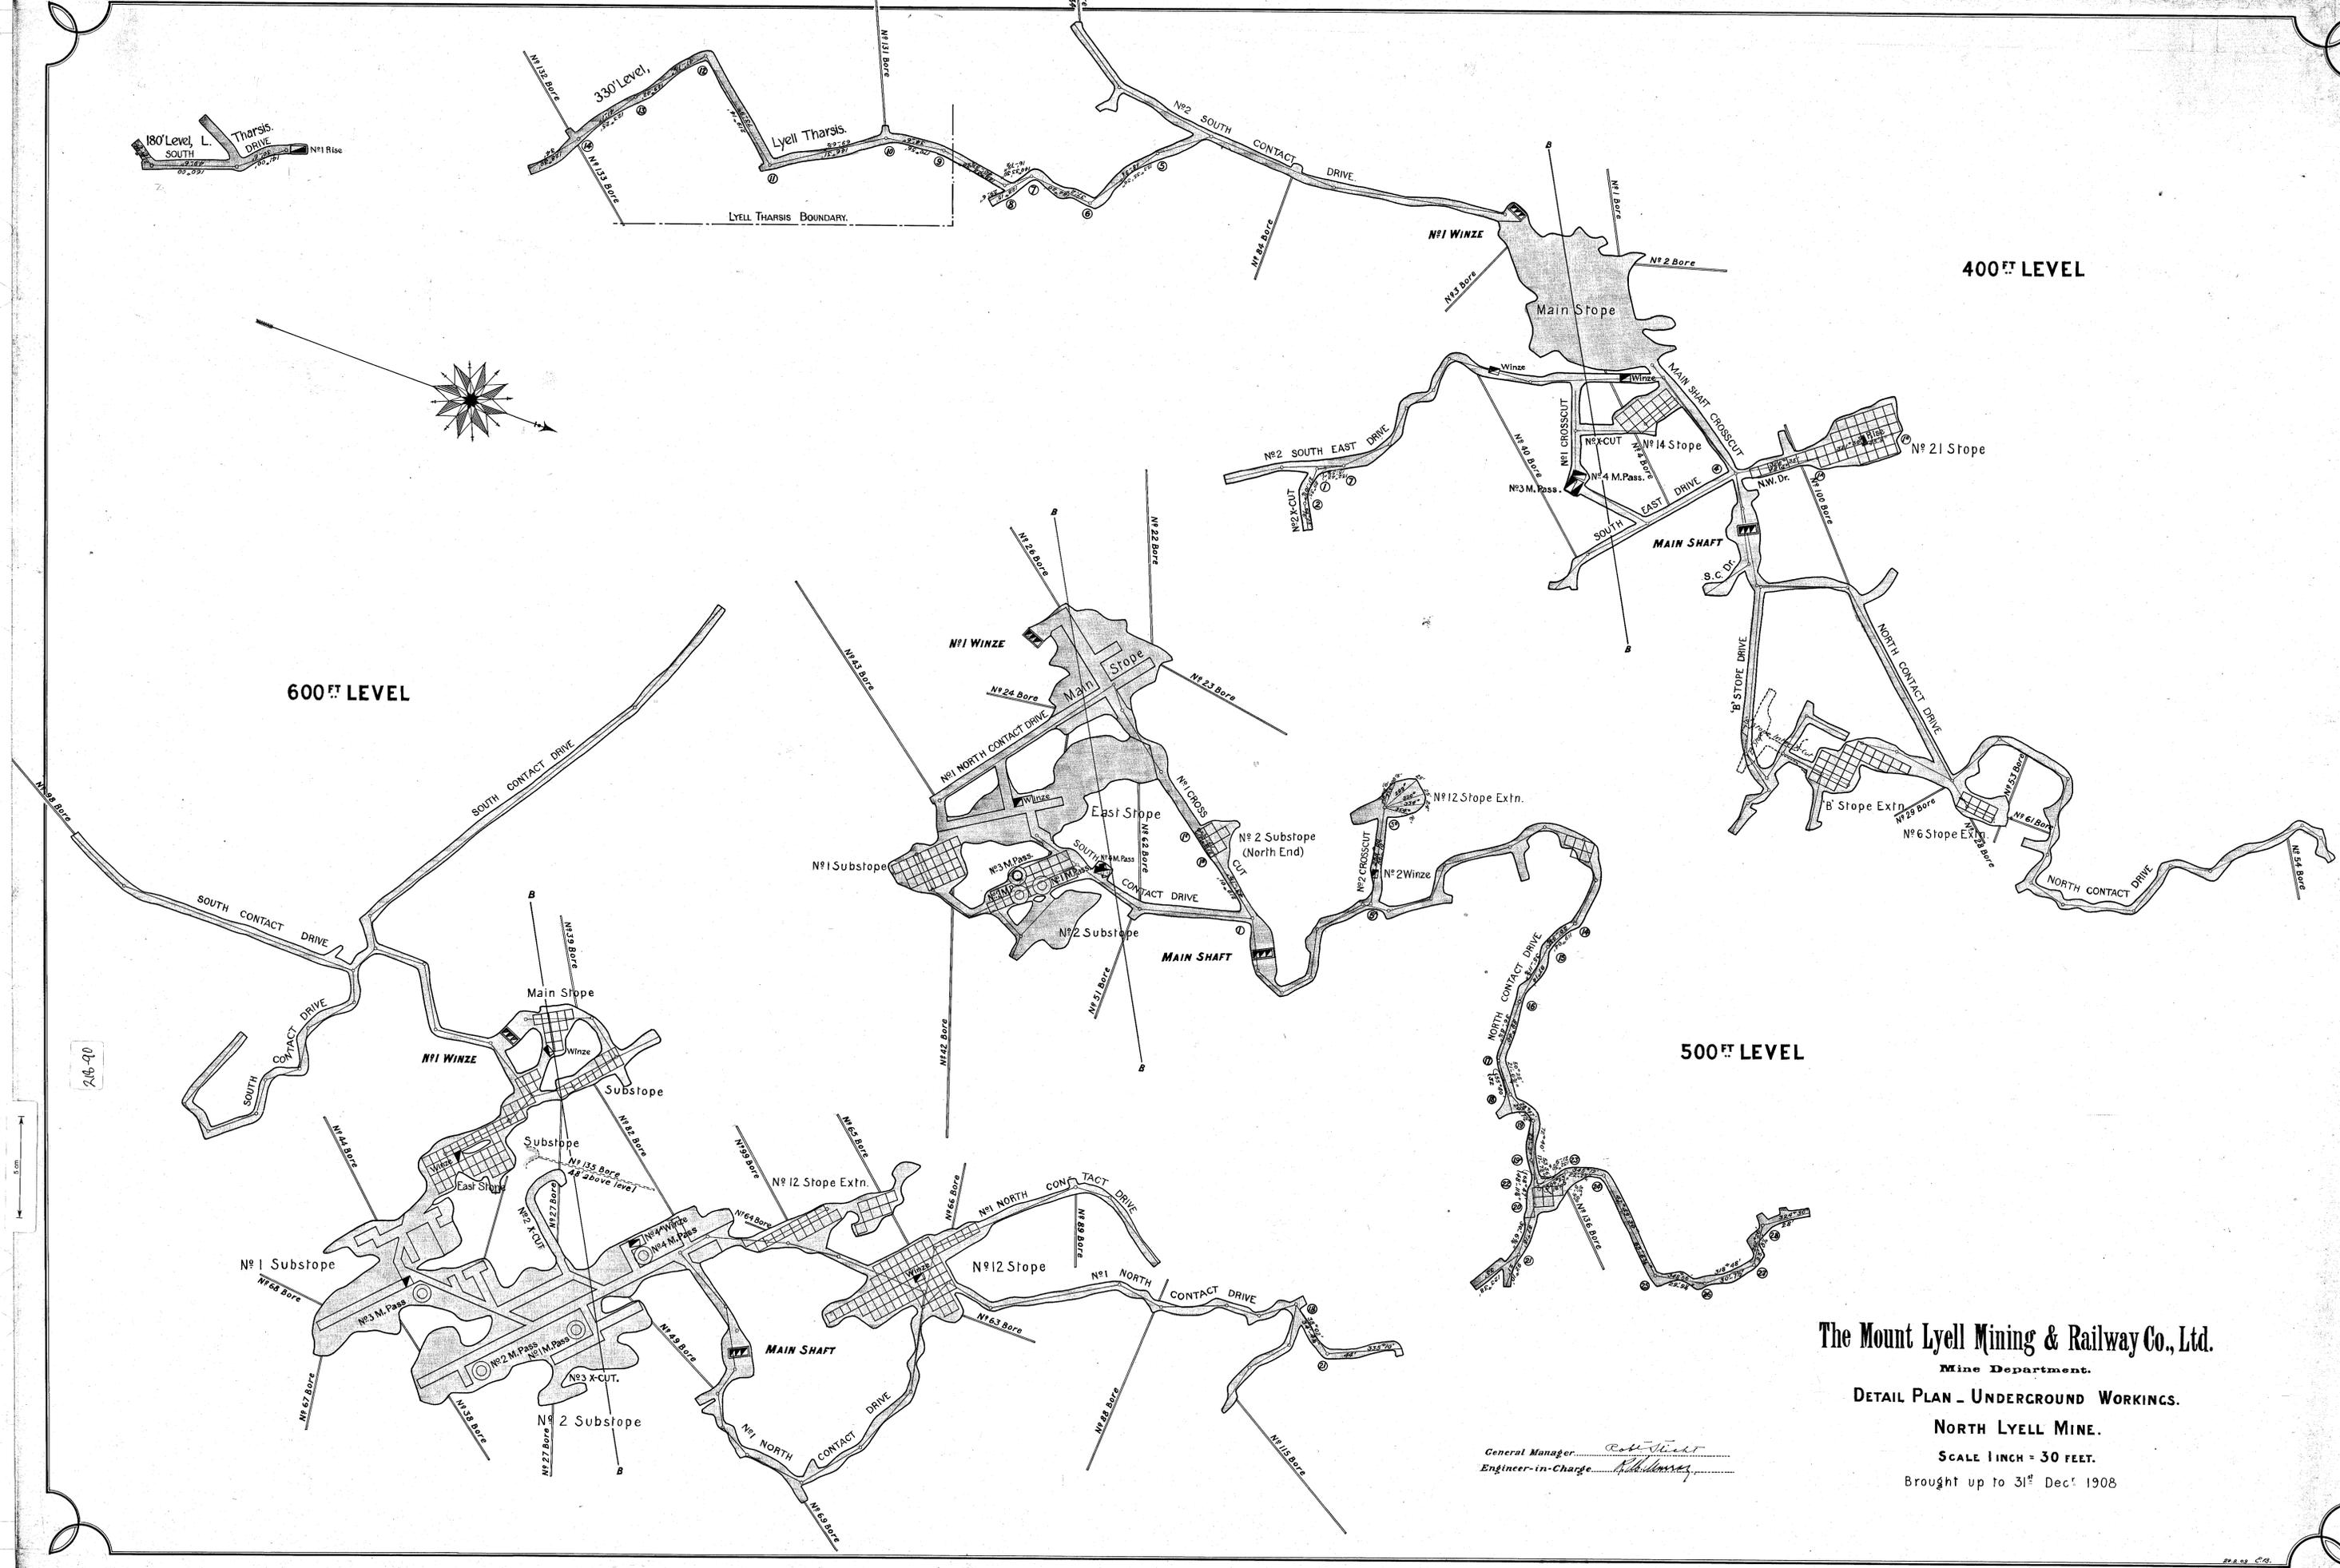

215-90

5 cm

The Mount Lyell Mining & Railway Co., Ltd.

Mine Department.
DETAIL PLAN - UNDERGROUND WORKINGS.

NORTH LYELL MINE.

SCALE 1 INCH = 30 FEET.

Brought up to 31st Dec^r 1908

General Manager *Robt. Smith*
Engineer-in-Charge *A. Williams*