



14 of plan of mine workings  
shown to the public  
1909. 10. 23. 1909

215-94

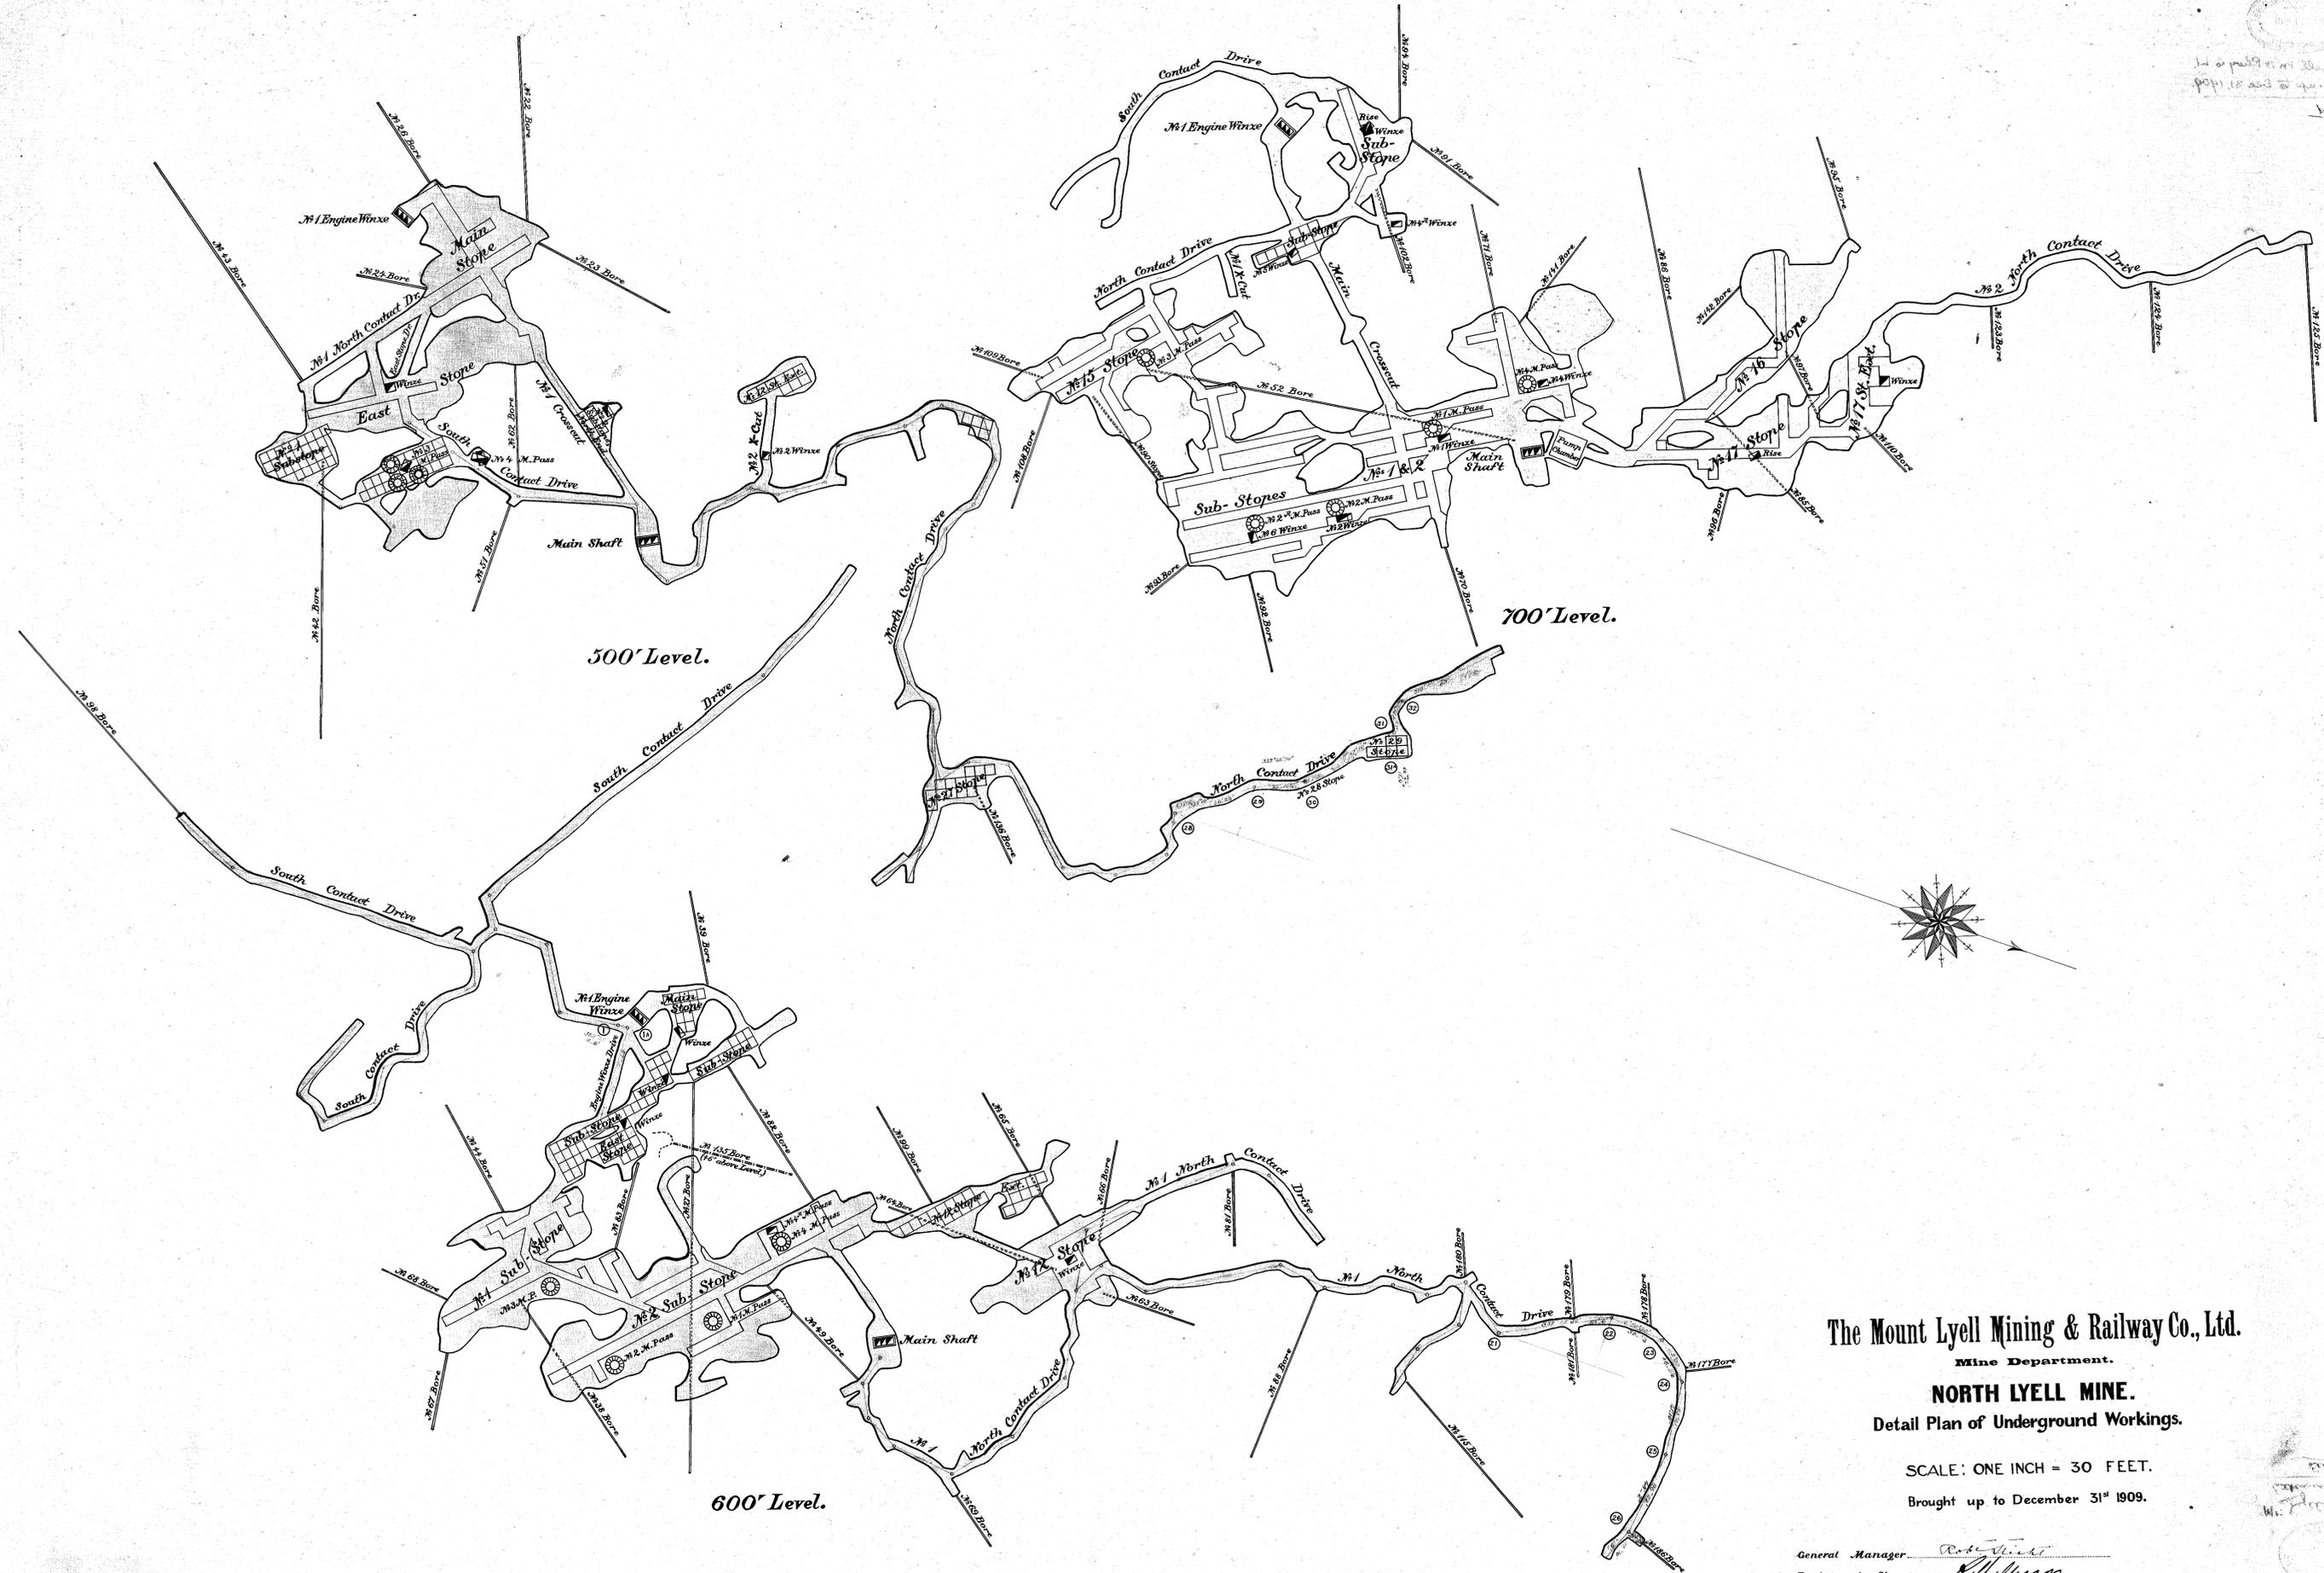

5 cm

215-94

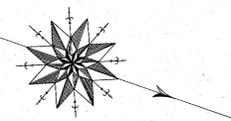

The Mount Lyell Mining & Railway Co., Ltd.  
 Mine Department.  
**NORTH LYELL MINE.**  
 Detail Plan of Underground Workings.

SCALE: ONE INCH = 30 FEET.  
 Brought up to December 31<sup>st</sup> 1909.

General Manager *Rose*  
 Engineer-in-Charge *Williamson*