


218-95

218-95

5 cm

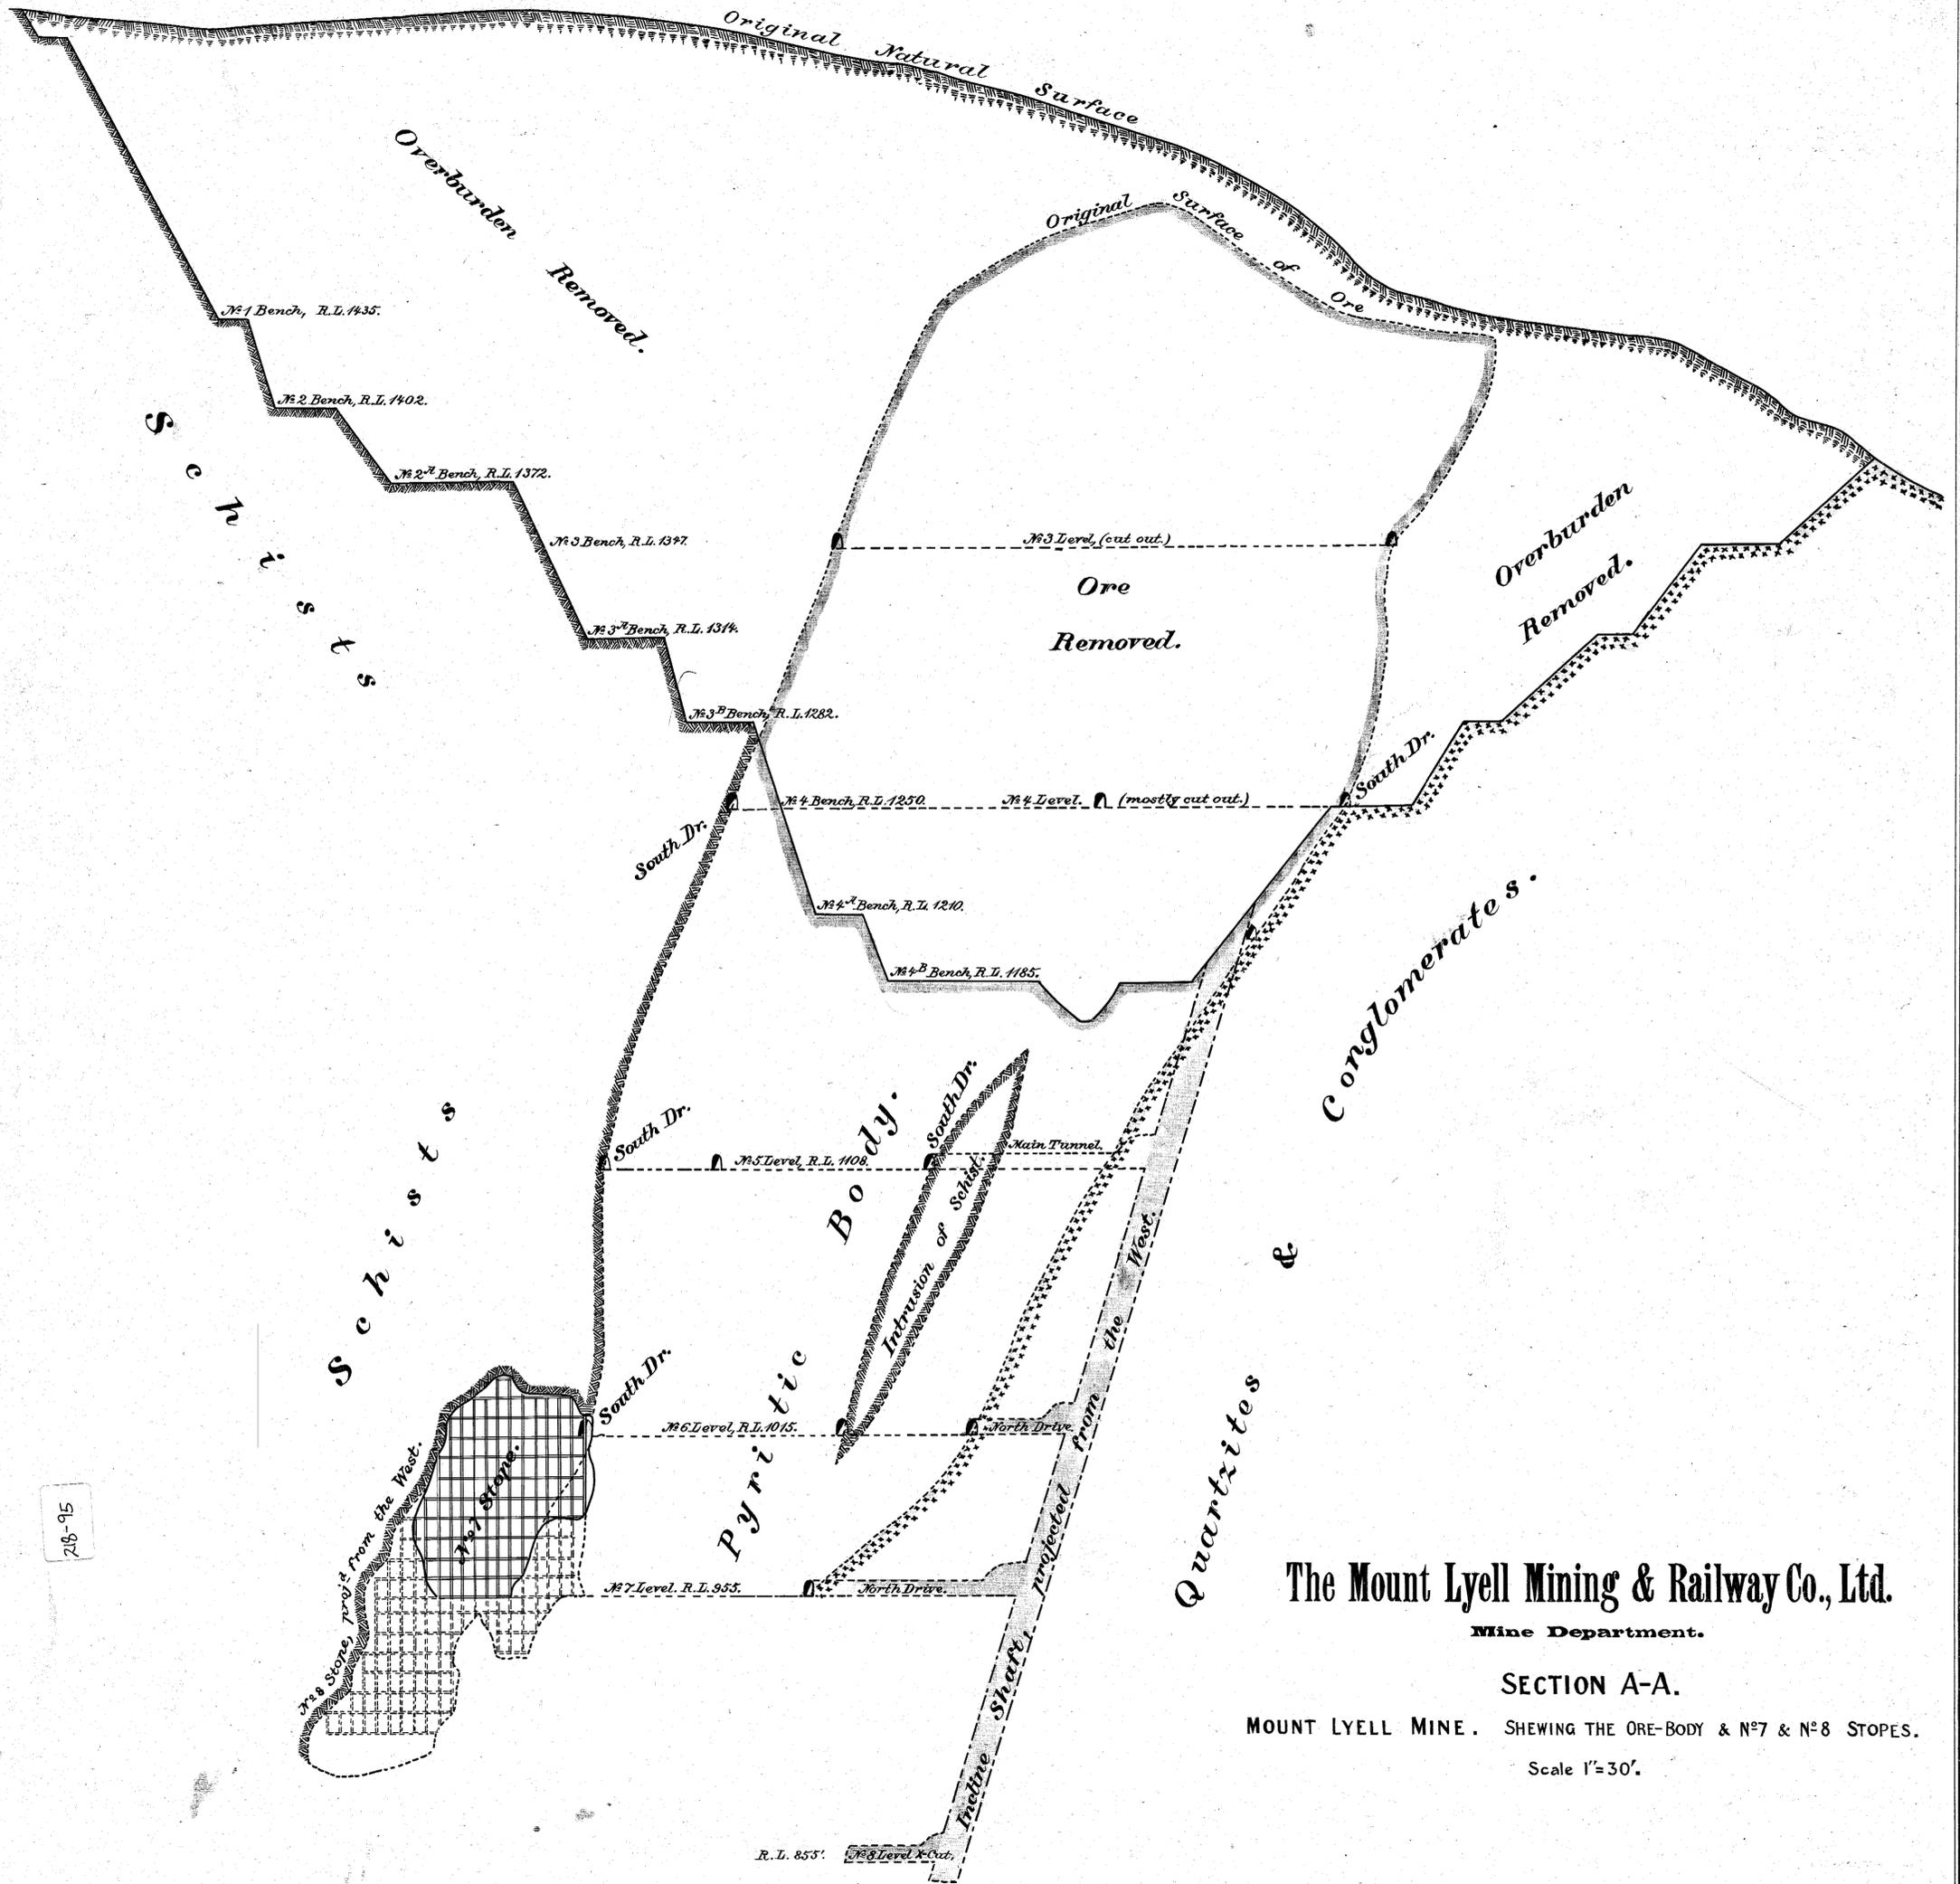

The Mount Lyell Mining & Railway Co., Ltd.

Mine Department.

SECTION A-A.

MOUNT LYELL MINE. SHEWING THE ORE-BODY & N°7 & N°8 STOPES.

Scale 1"=30'.

General Manager..... *Robt. Nicht*
 Engineer-in-Charge..... *W. Murray*