


218-96

218-96

5 cm

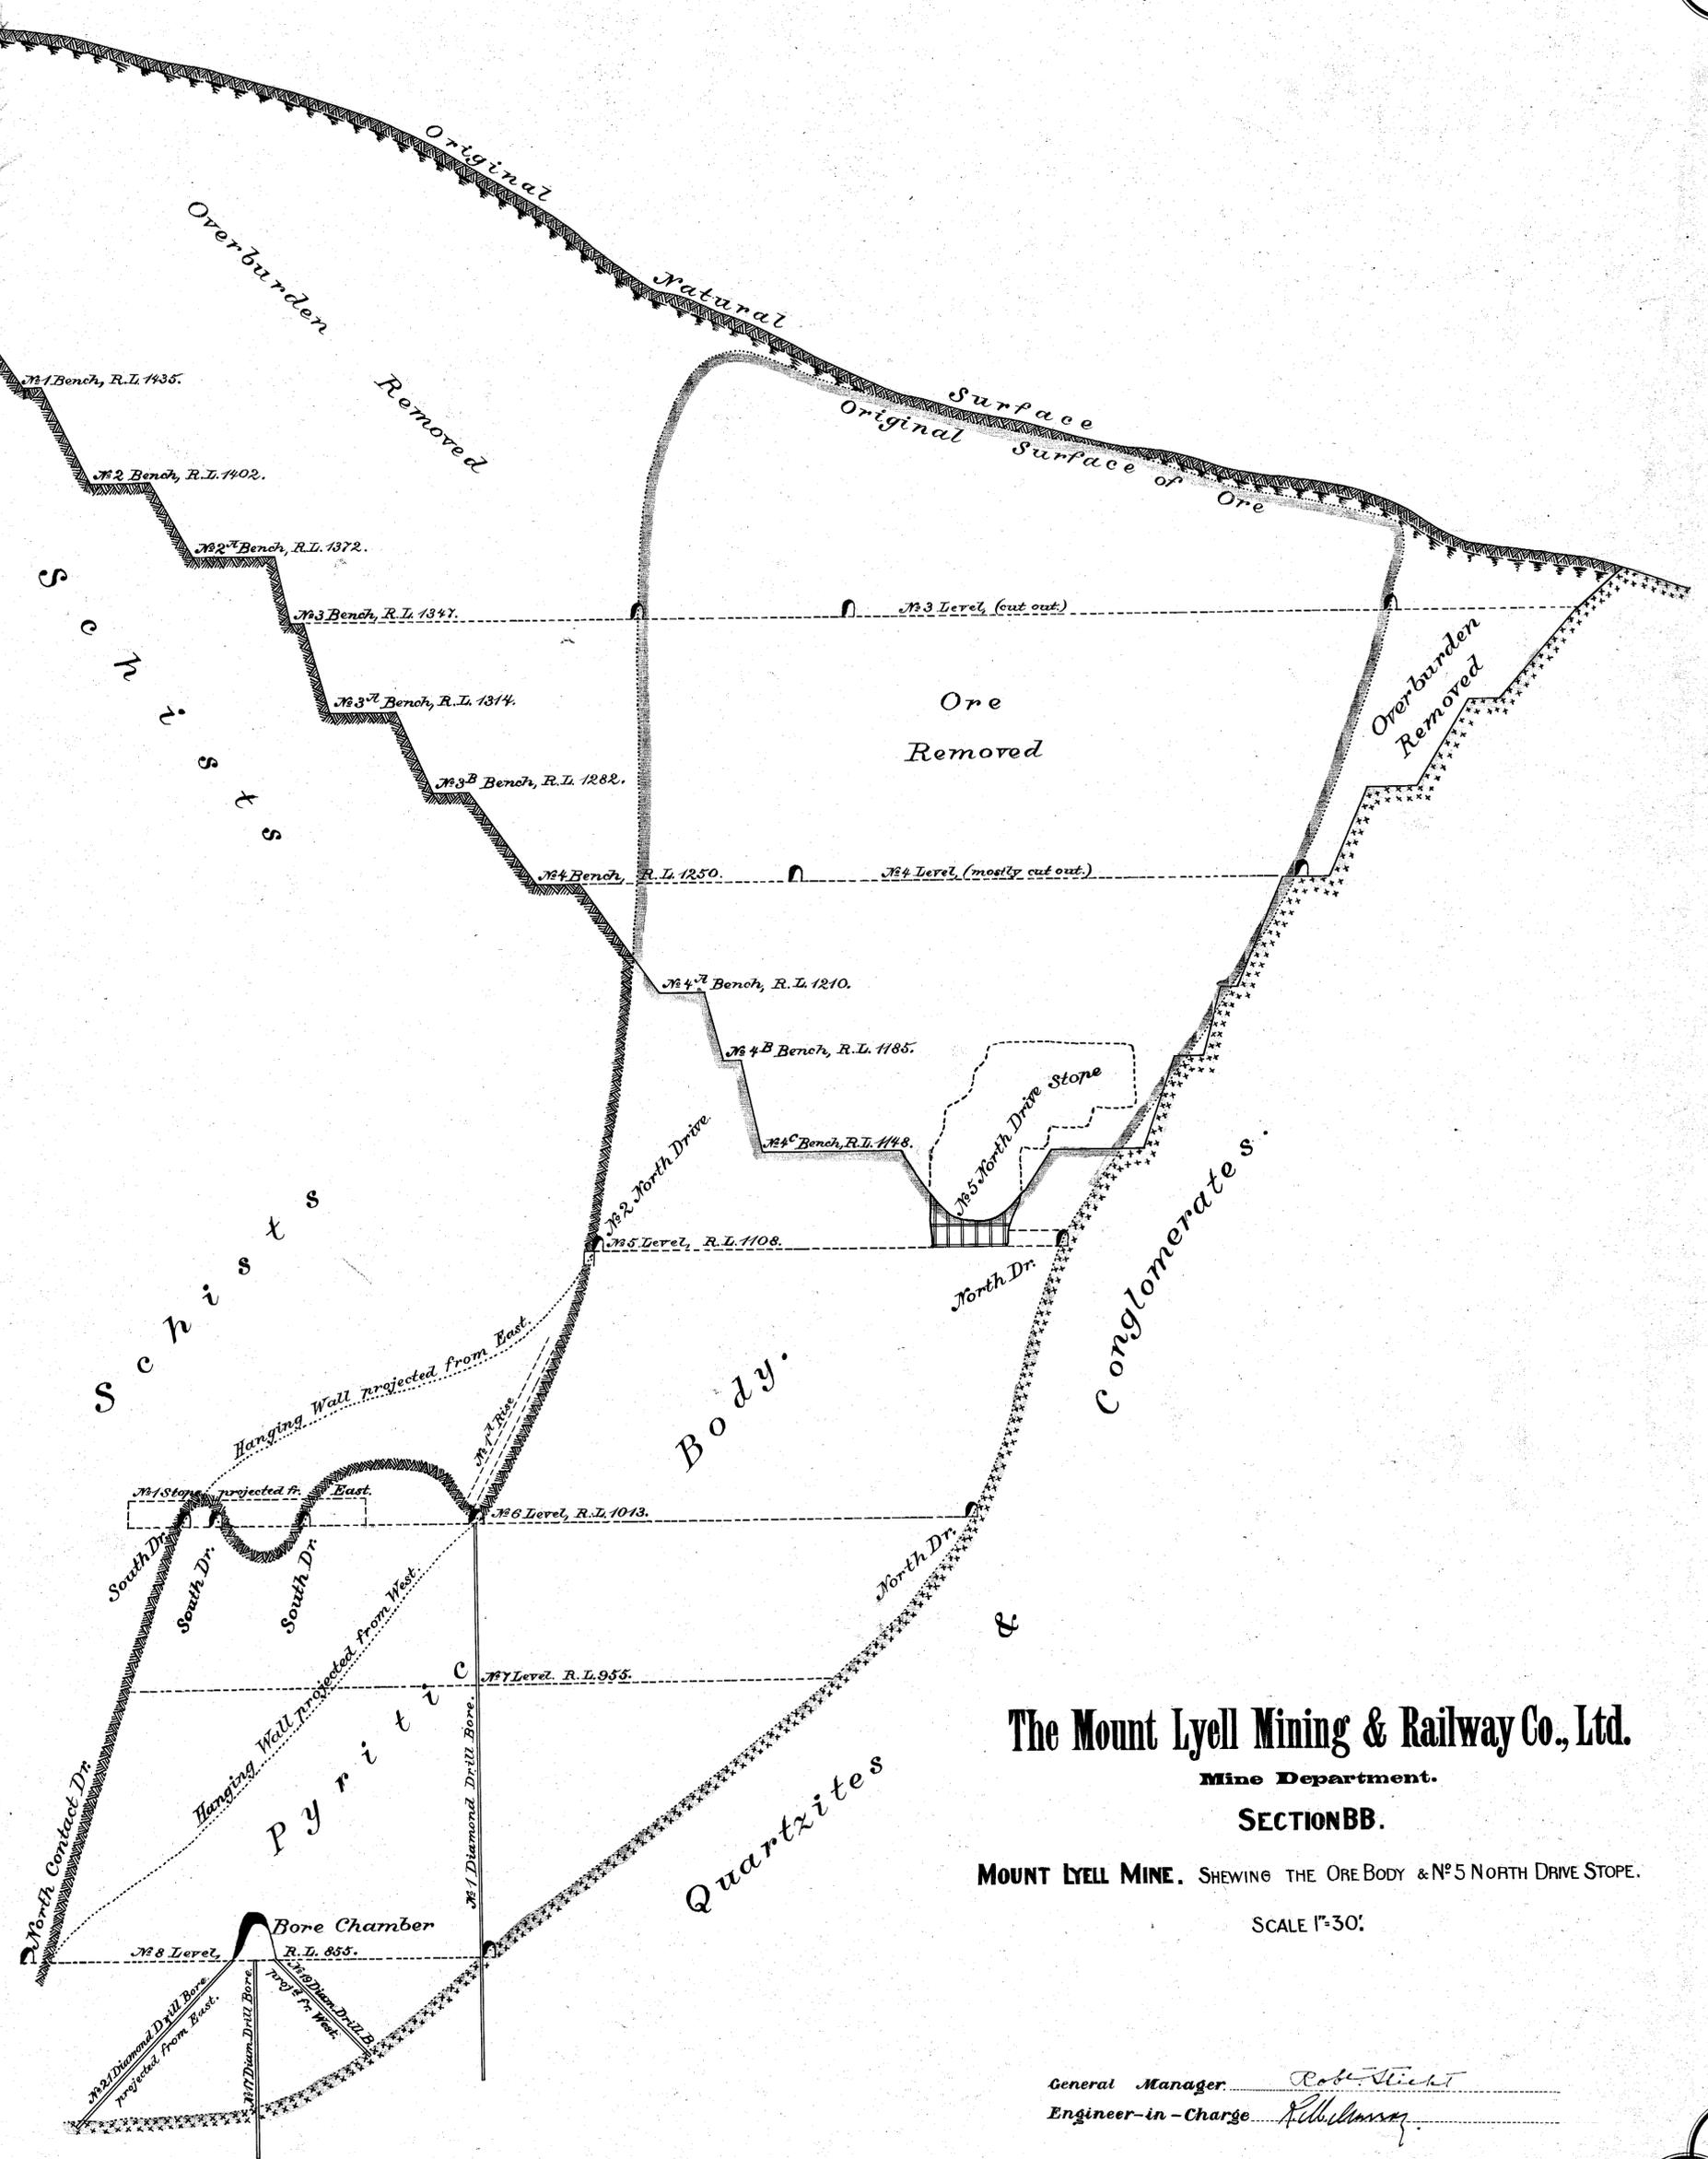

The Mount Lyell Mining & Railway Co., Ltd.

Mine Department.

SECTION BB.

MOUNT LYELL MINE. SHOWING THE ORE BODY & #5 NORTH DRIVE STOPE.

SCALE 1"=30'

General Manager *Robt. Slicht*

Engineer-in-Charge *A. H. Murray*