




218-97

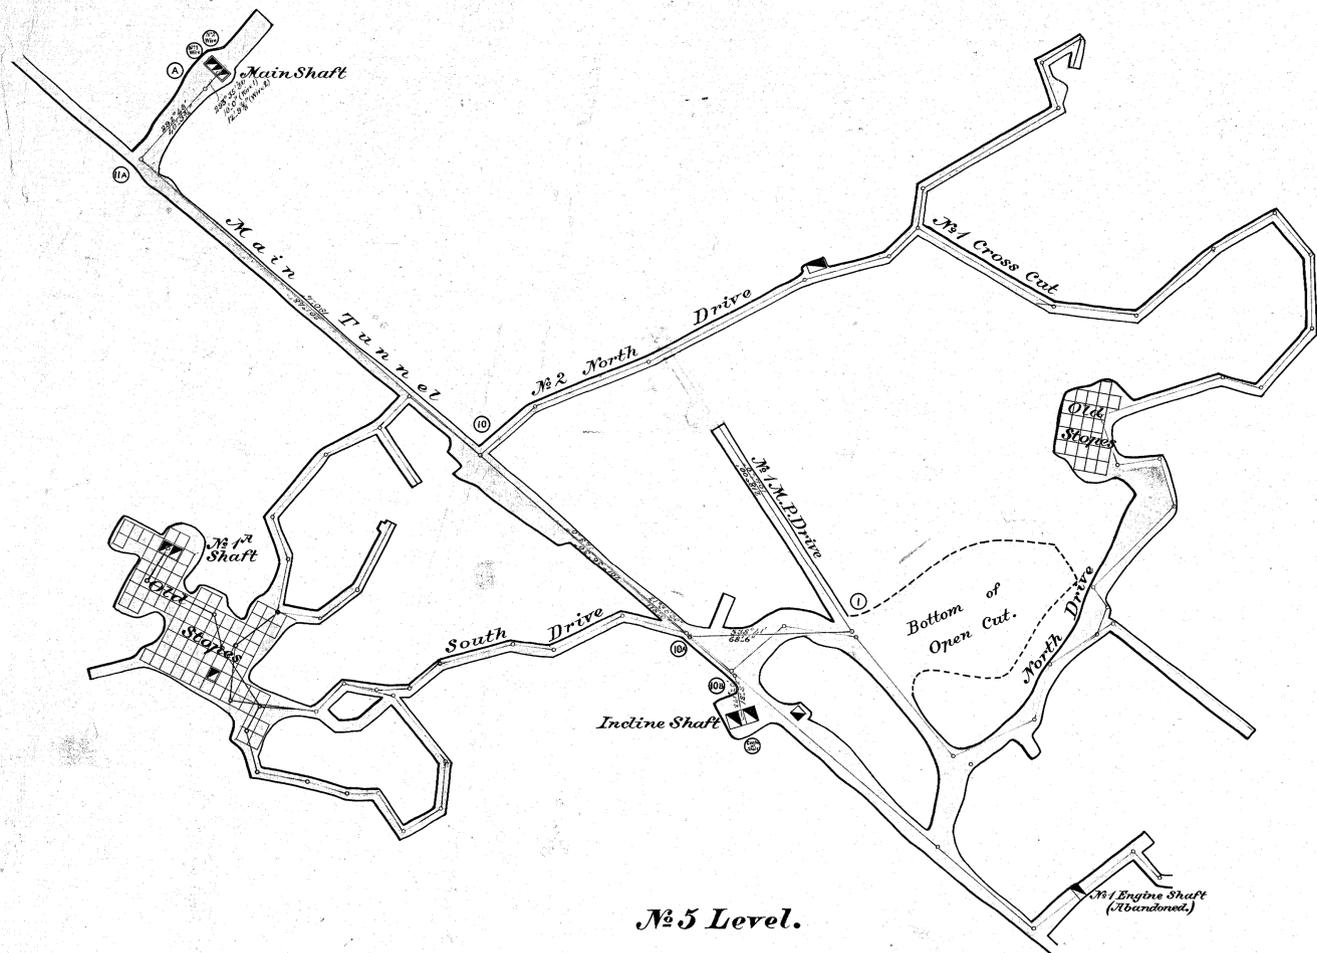

No. 5 Level.

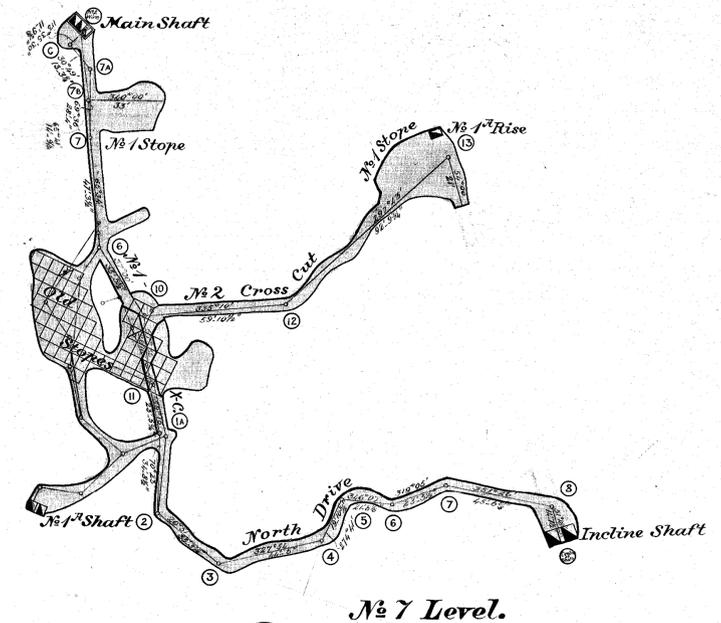


No. 7 Level.

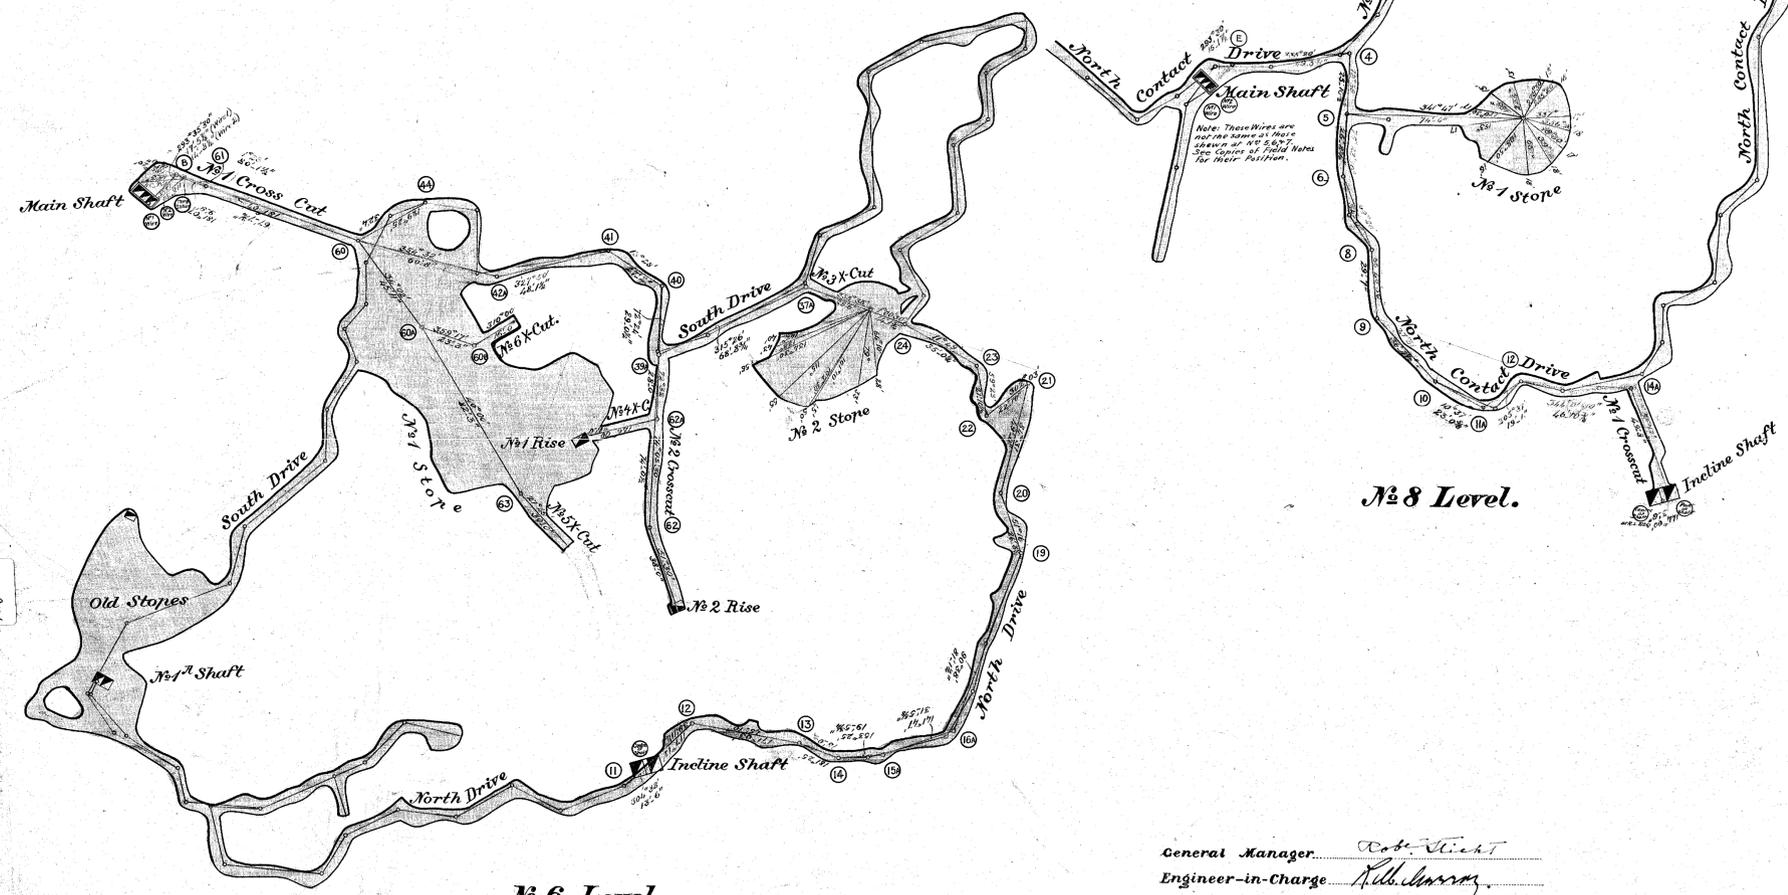

No. 6 Level.

No. 8 Level.

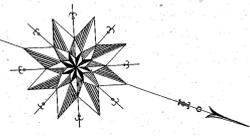

The Mount Lyell Mining & Railway Co., Ltd.  
 Mine Department.

DETAIL PLAN - UNDERGROUND WORKINGS.

MOUNT LYELL MINE.

Brought up to 31<sup>st</sup> Dec. 1909.

SCALE: 1 INCH = 30 FEET.

General Manager... *Robt. Licht*  
 Engineer-in-Charge... *H. W. Amory*

218-97

