
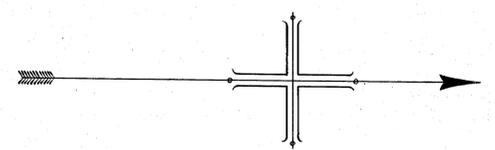
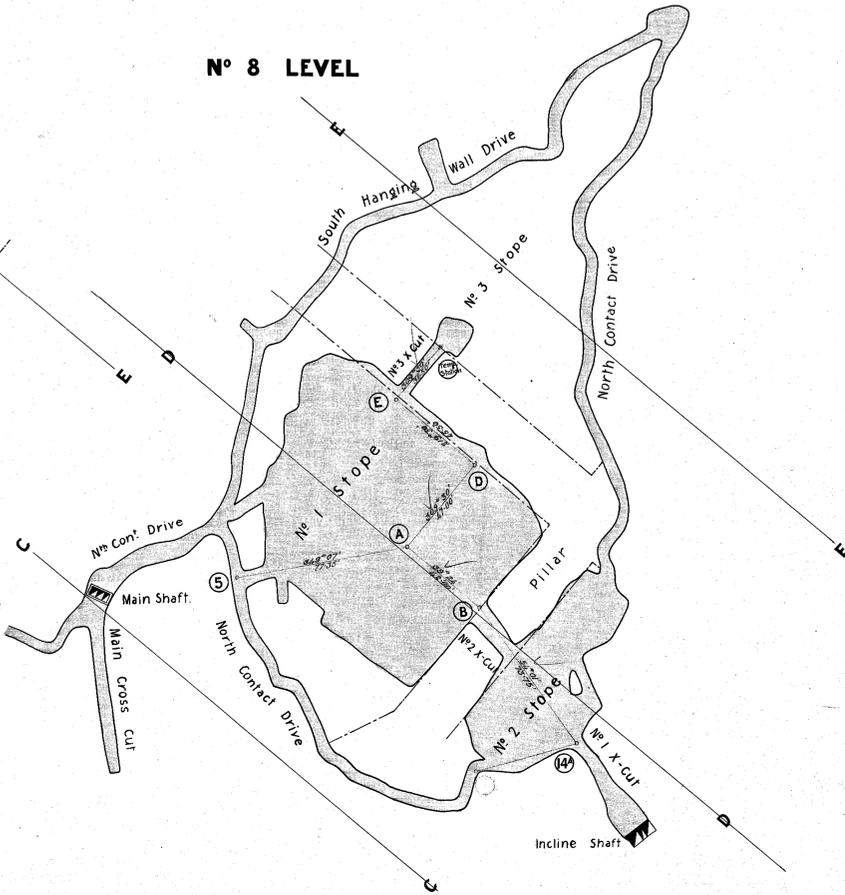
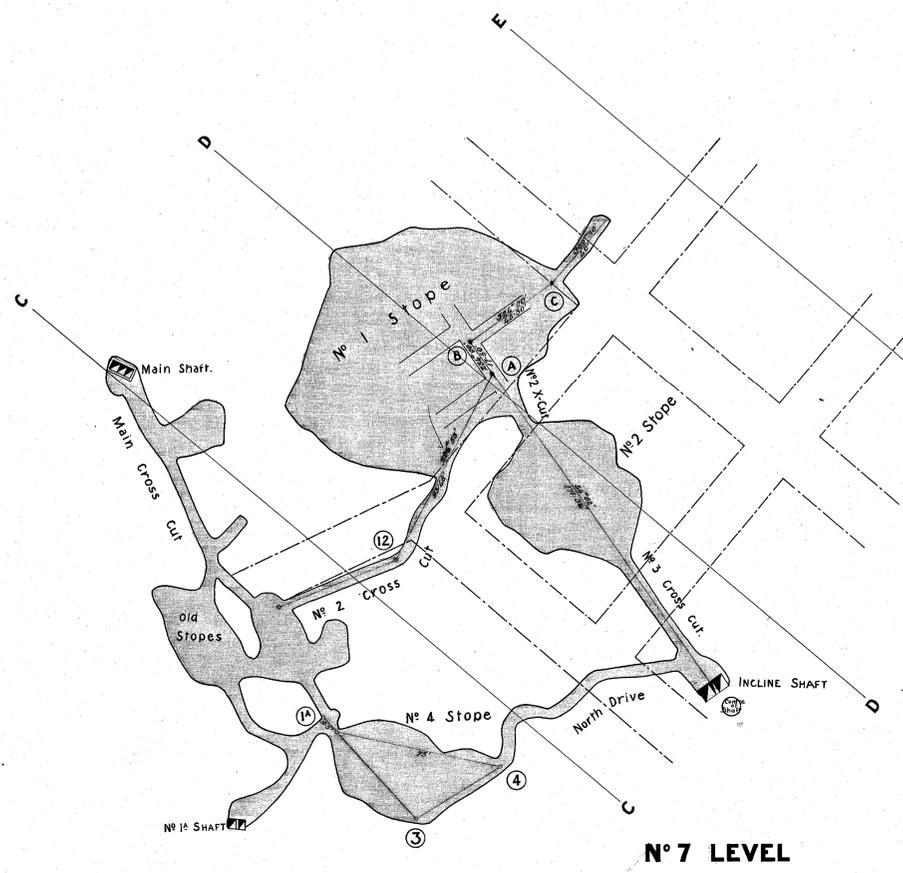
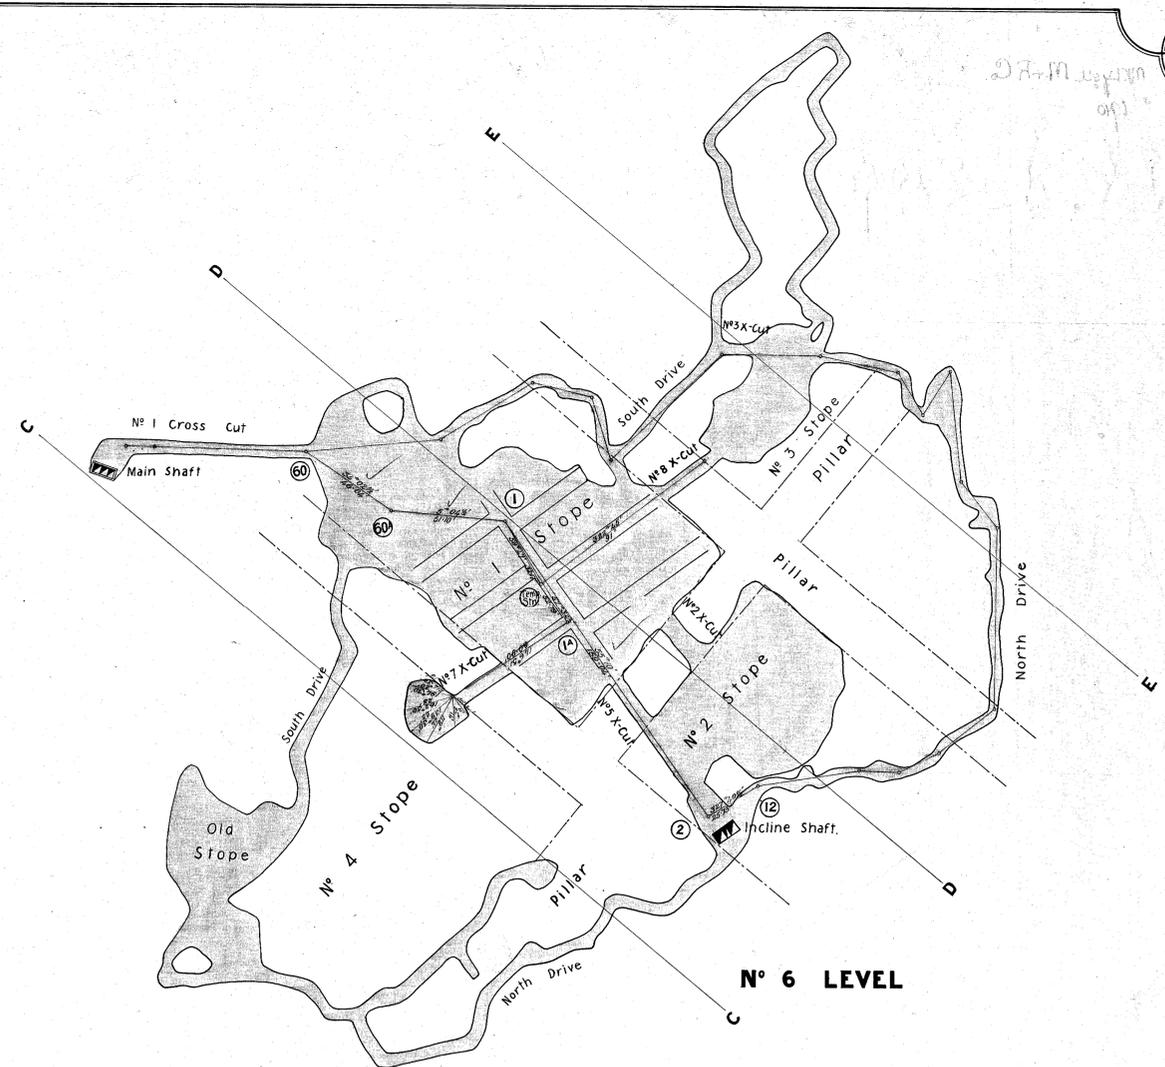


218-99

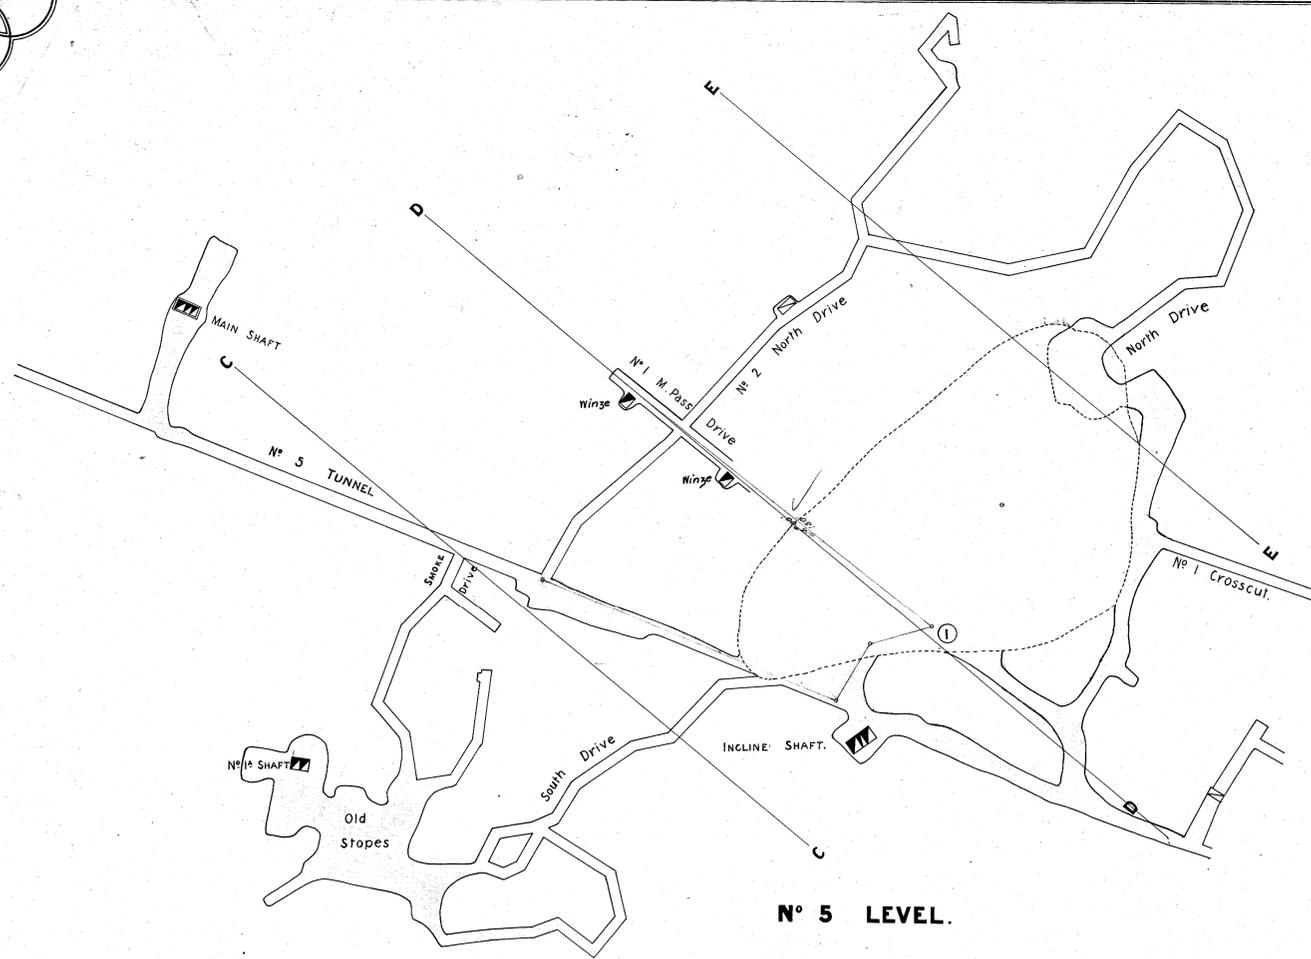

The Mount Lyell Mining & Railway Co., Ltd.

Mine Department.

DETAIL PLAN UNDERGROUND WORKINGS.

MOUNT LYELL MINE.

Brought up to Dec'r 31st 1910.

Scale 1 inch = 30 feet.

General Manager *Robert Lyell*
 Engineer-in-Charge *W. B. Murray*

5 cm

218-99