


218-100

218-100

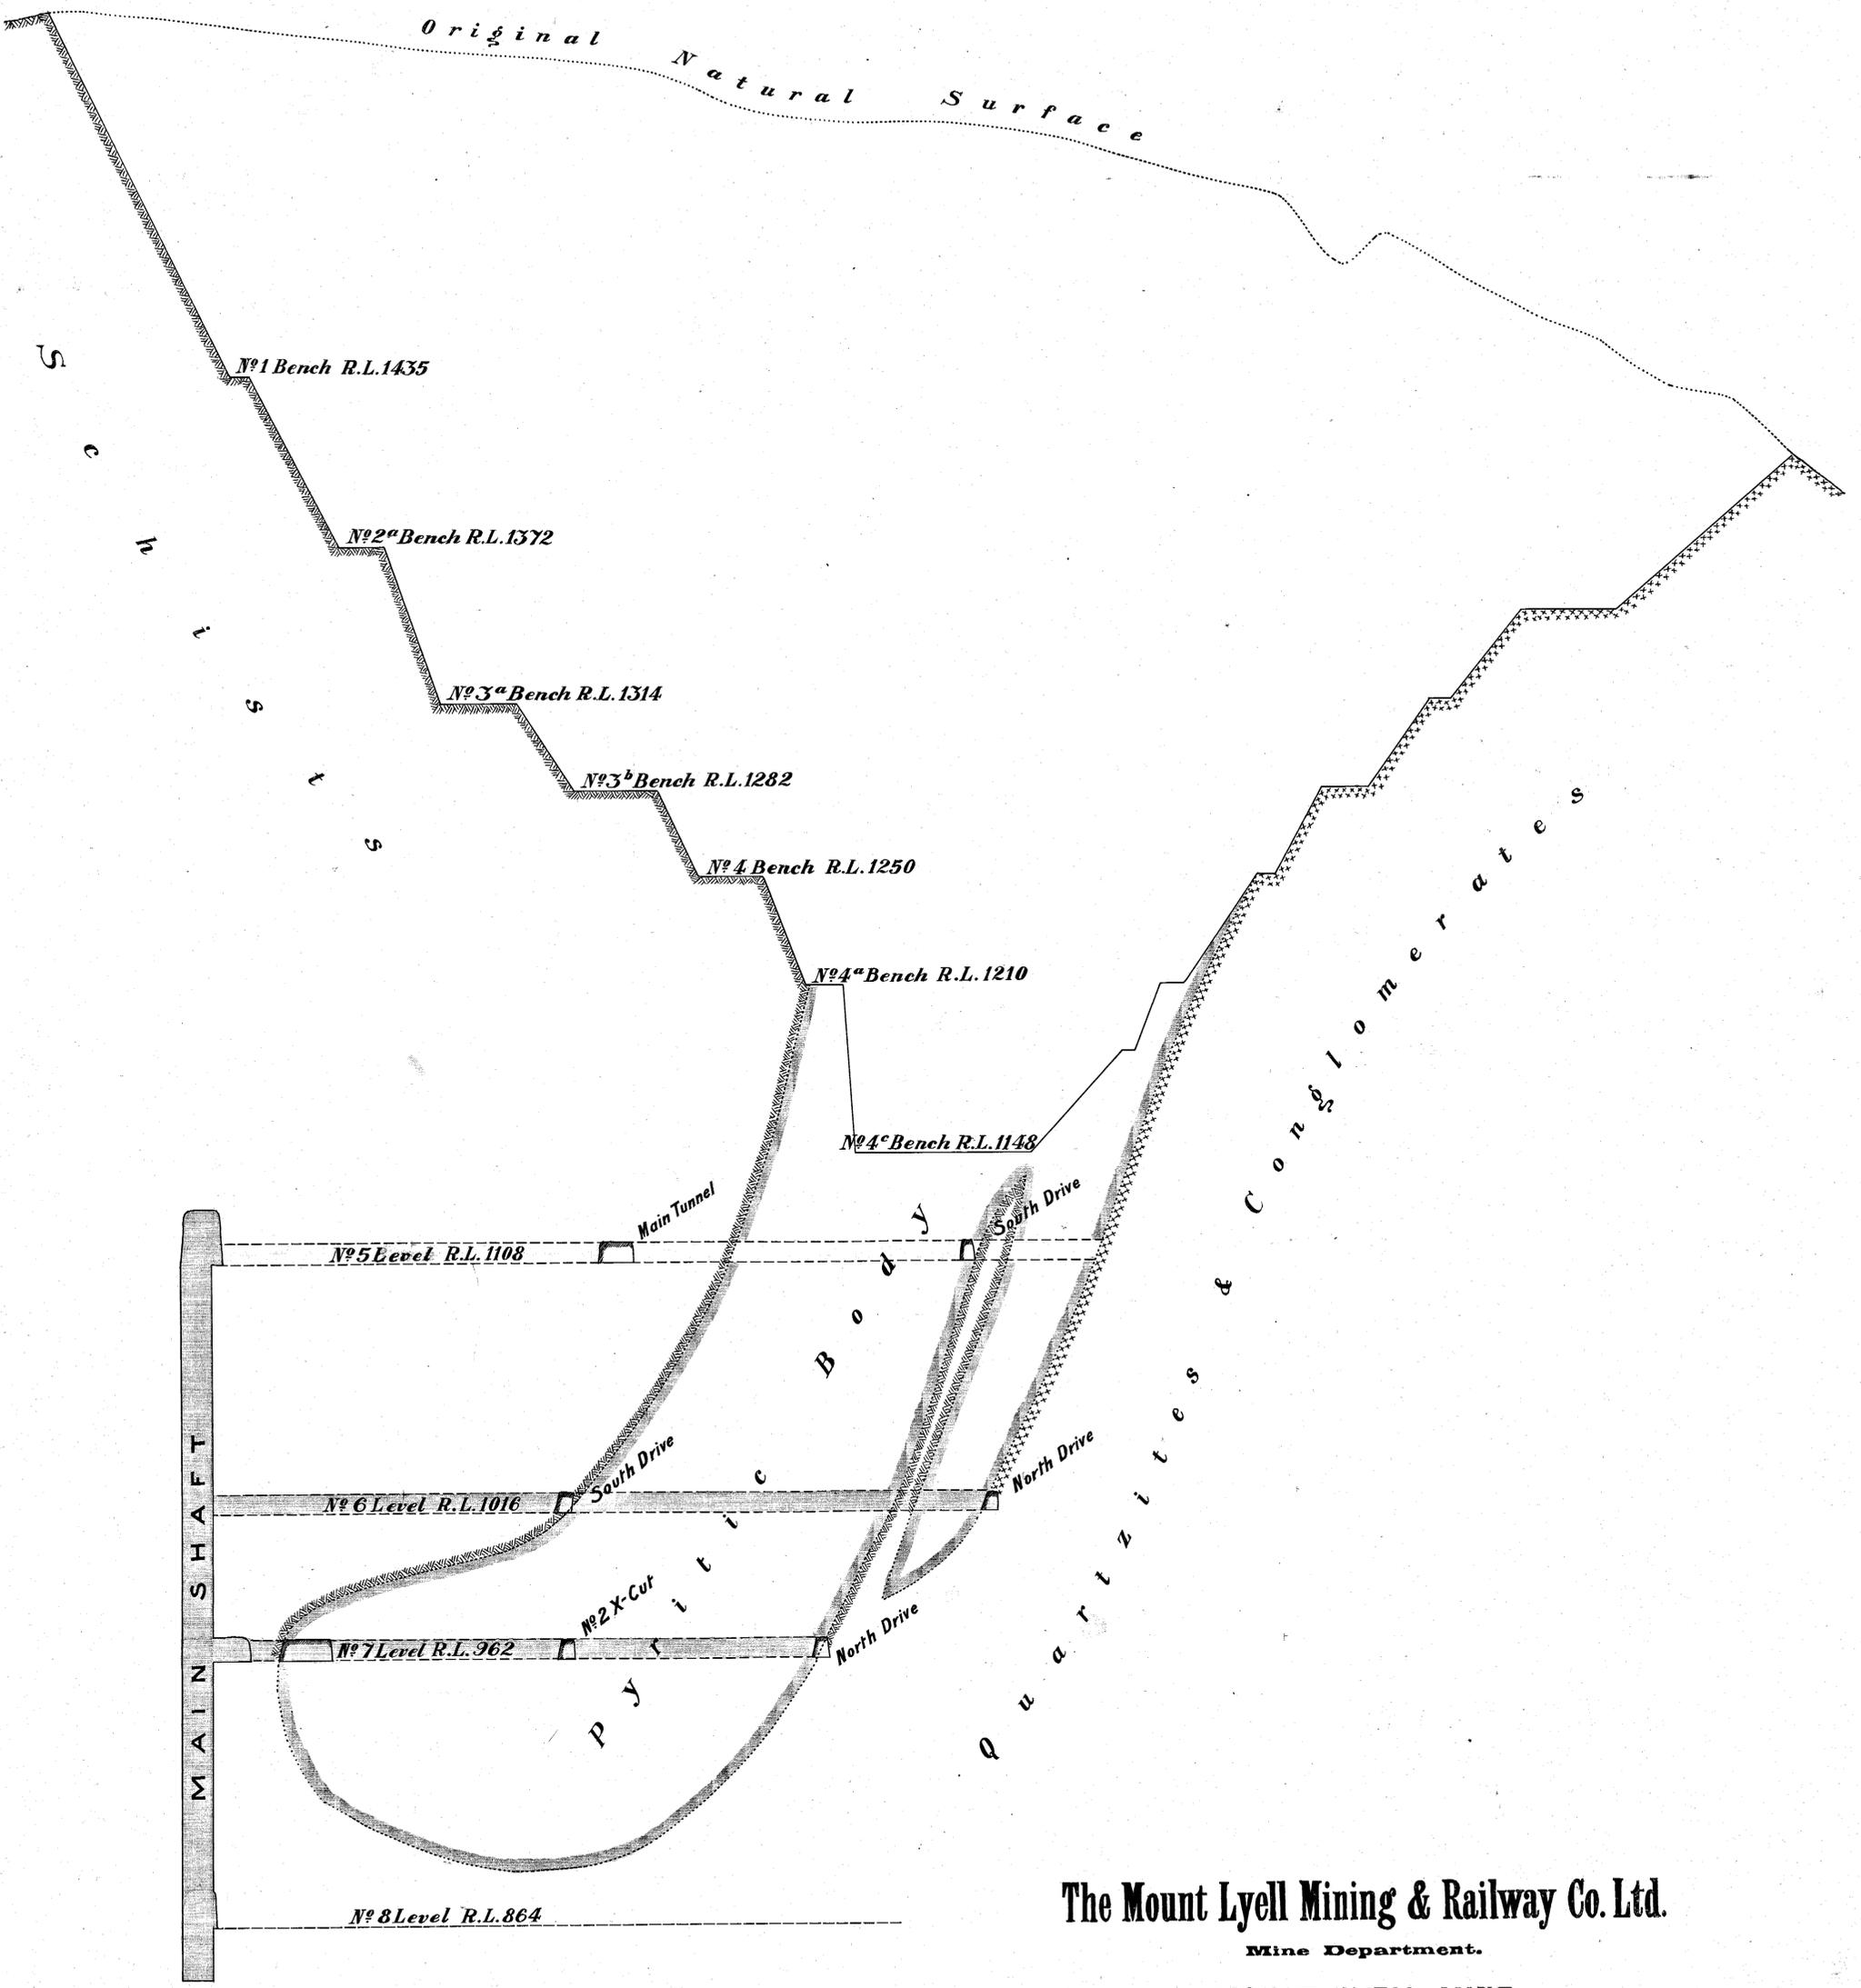

The Mount Lyell Mining & Railway Co. Ltd.

Mine Department.

MOUNT LYELL MINE

SECTION C-C

Scale 1"=30'

Ed. W.P.

General Manager *Robt. Dick*
Engineer-in-Charge *R. Williams*