


218-102

218-102

5 cm

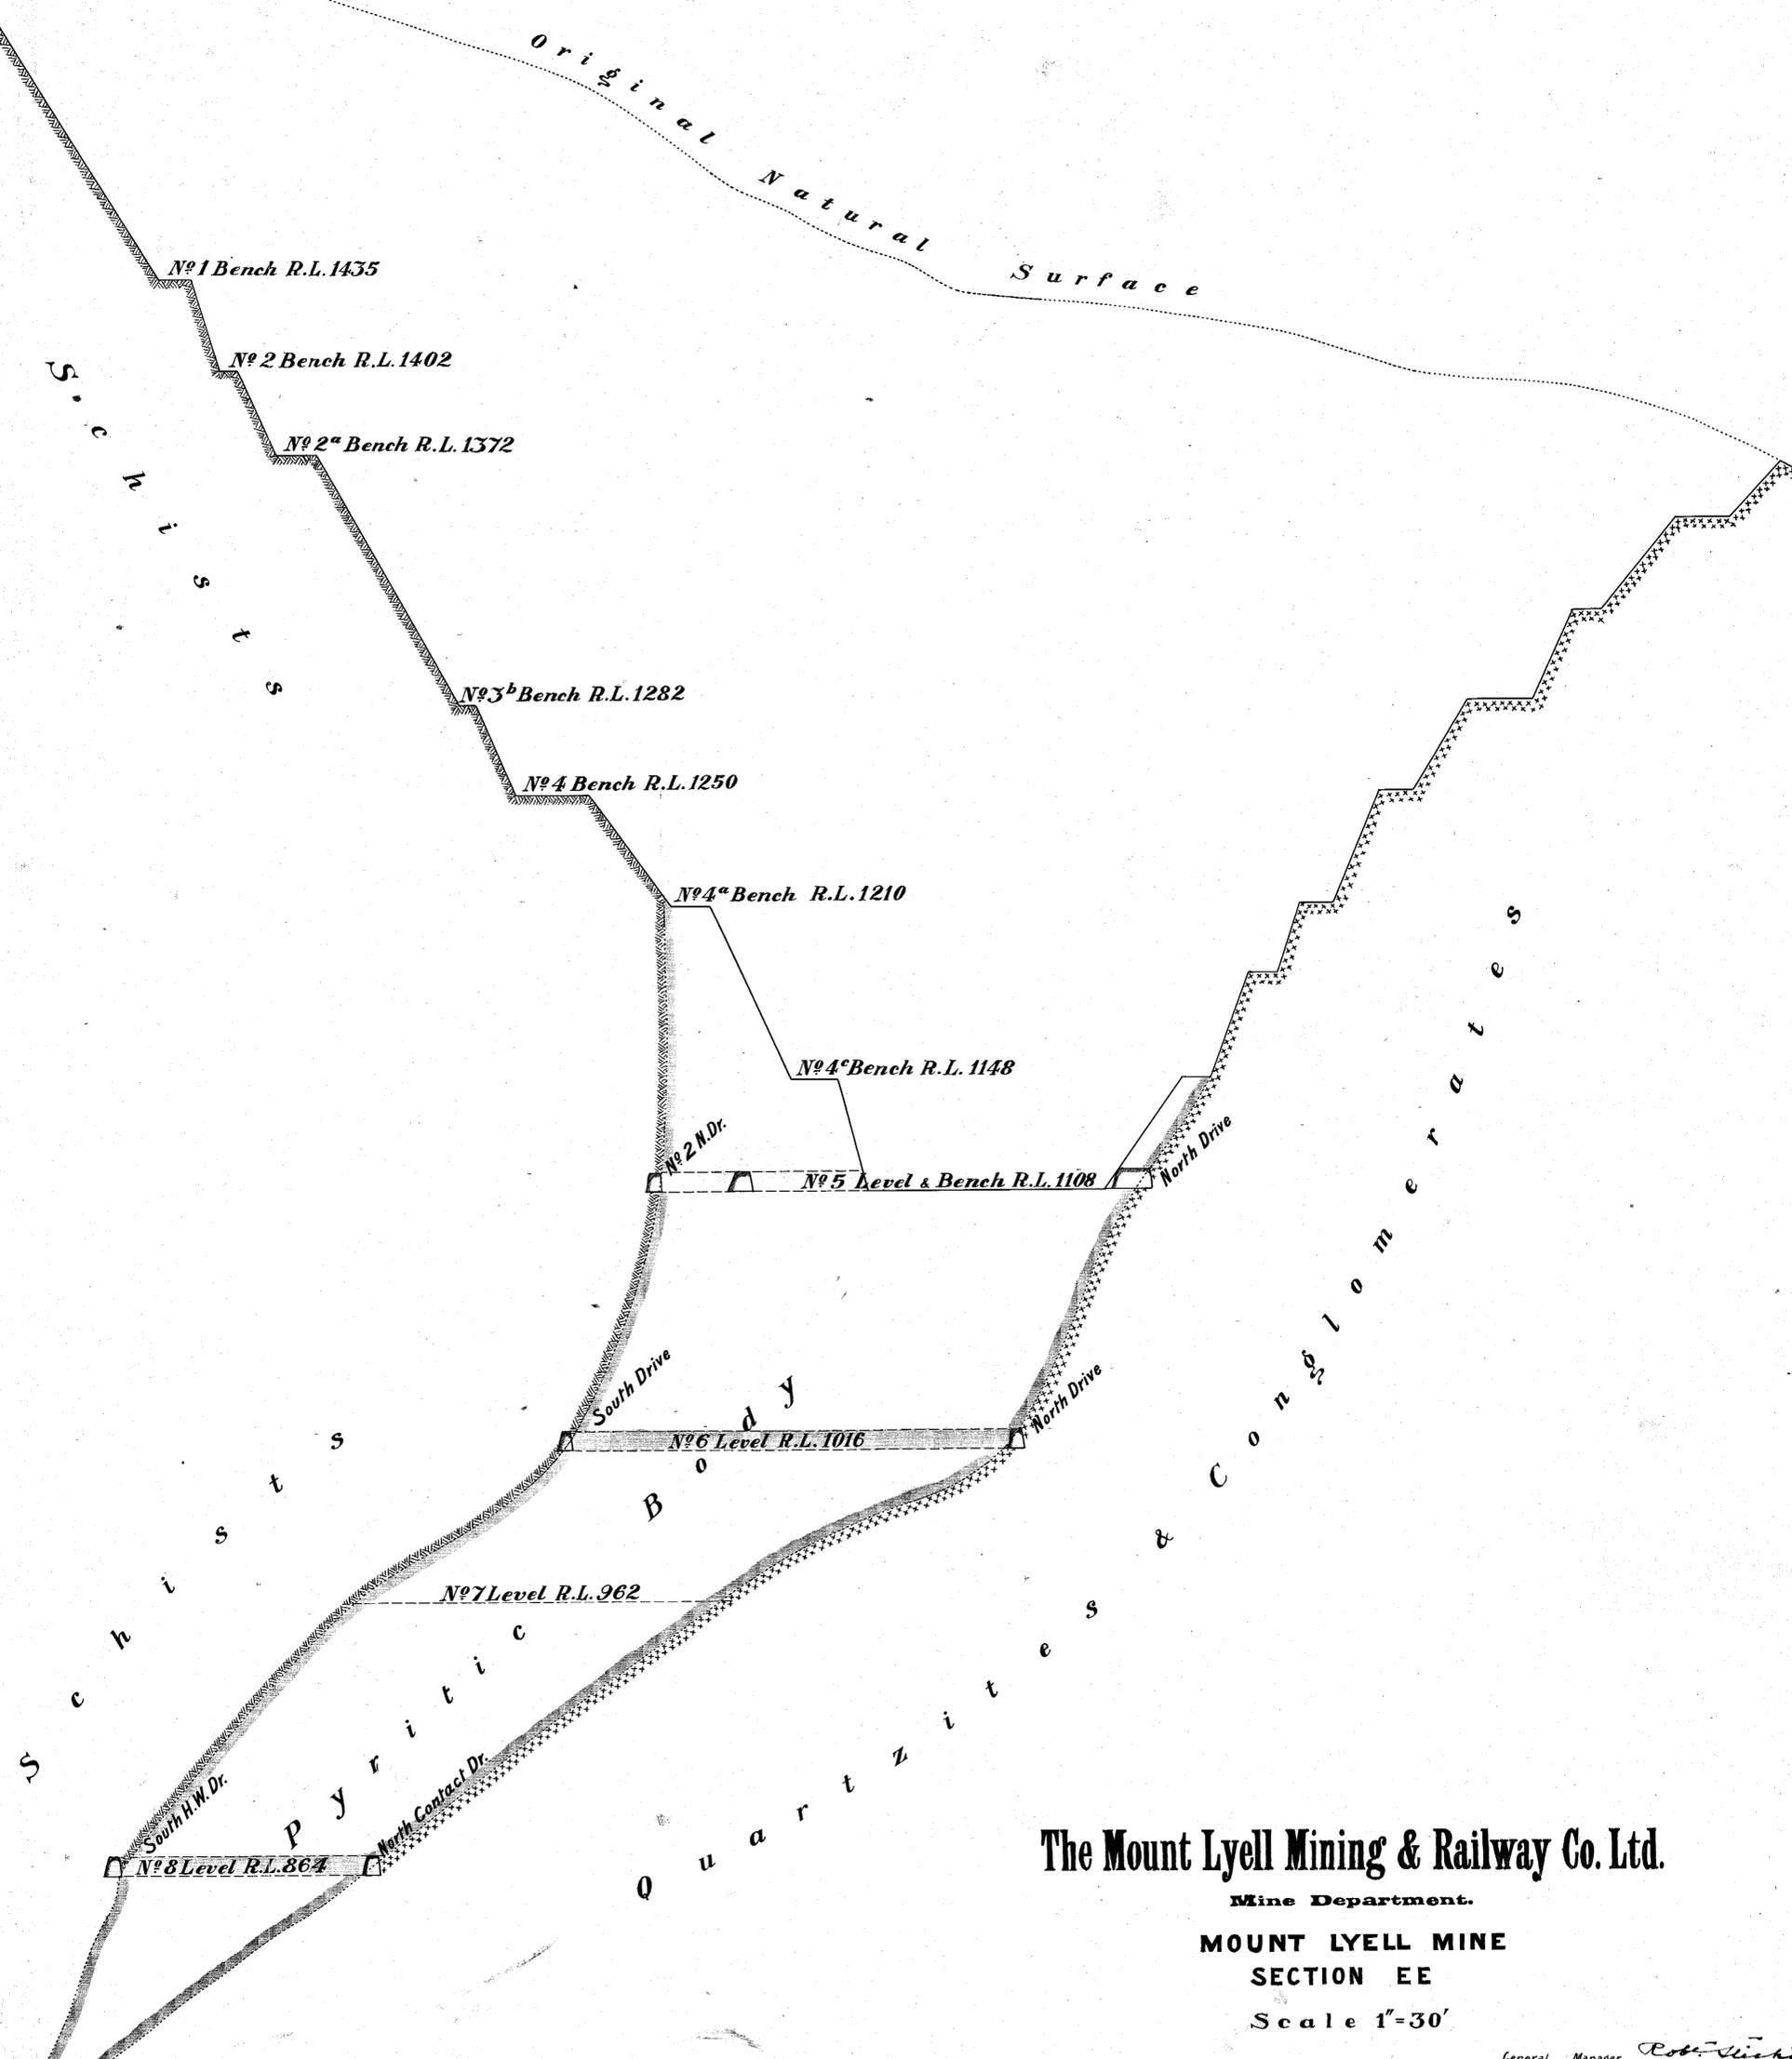

The Mount Lyell Mining & Railway Co. Ltd.

Mine Department.
MOUNT LYELL MINE
 SECTION EE
 Scale 1"=30'

General Manager *Robt. Smith*
 Engineer-in-Charge *W. Murray*