


1050' LEVEL

850' LEVEL

1100' LEVEL

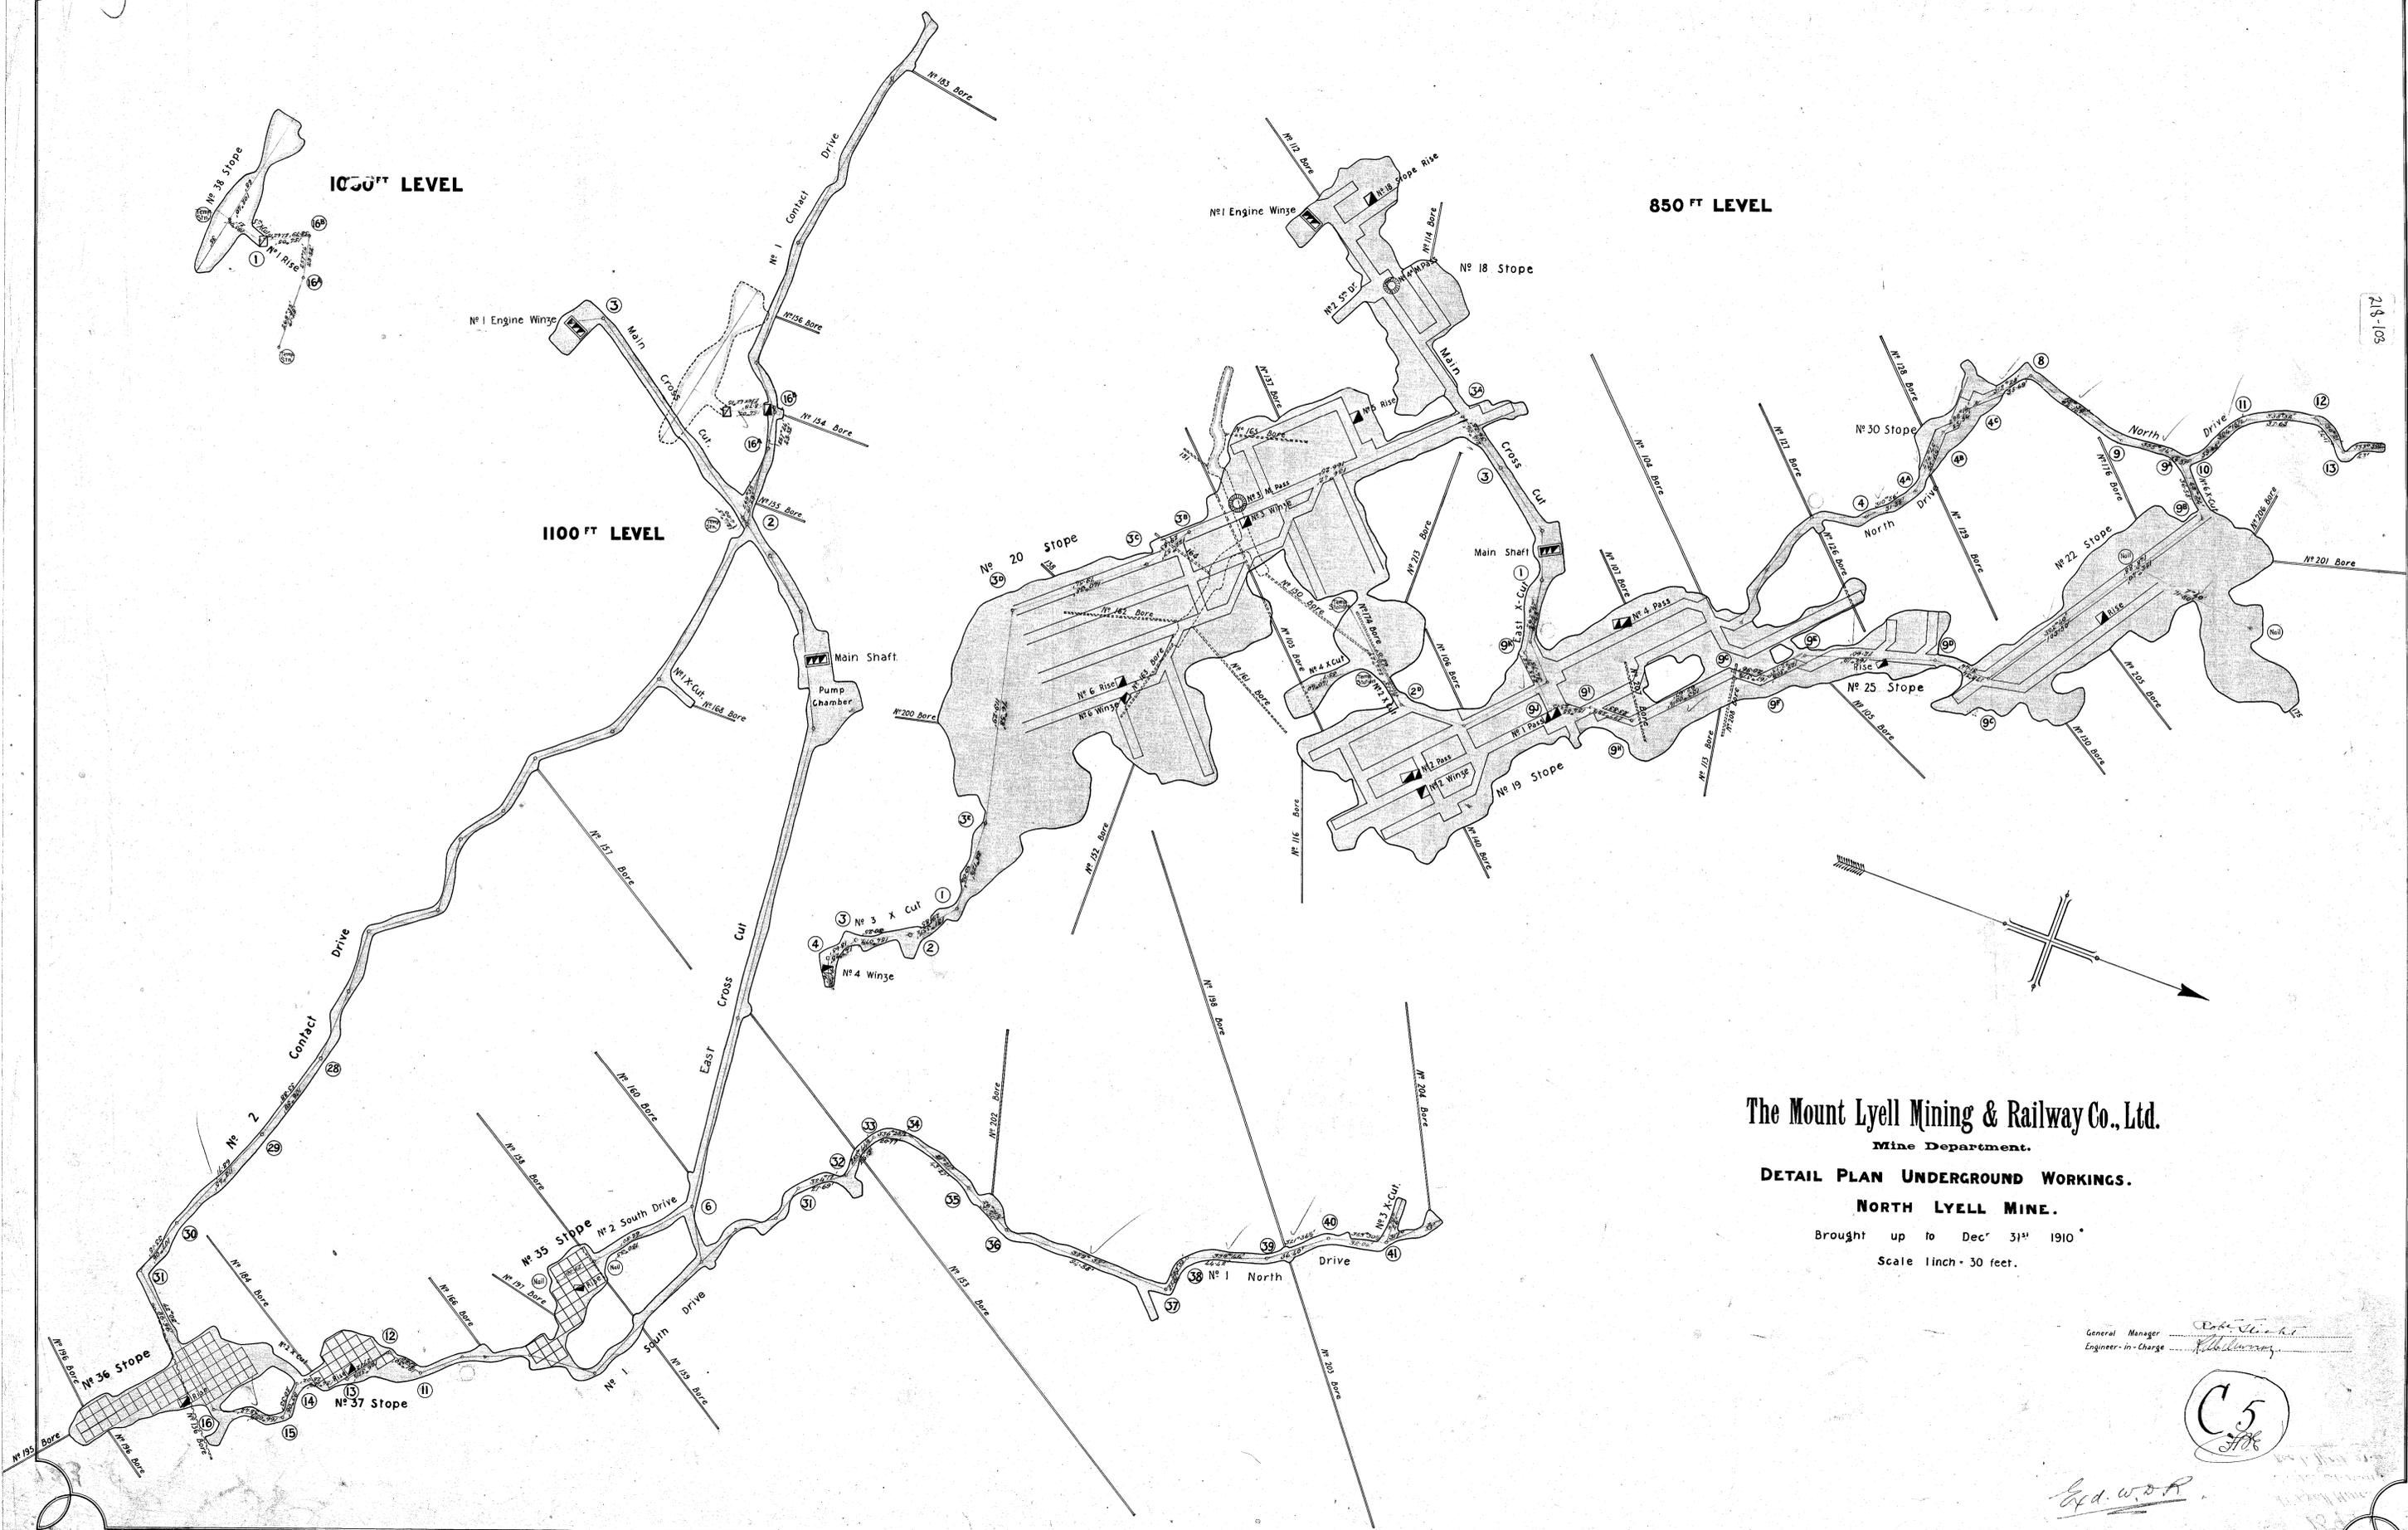

The Mount Lyell Mining & Railway Co., Ltd.

Mine Department.

DETAIL PLAN UNDERGROUND WORKINGS.

NORTH LYELL MINE.

Brought up to Dec 31st 1910

Scale 1 inch = 30 feet.

General Manager *Robert G. ...*
 Engineer-in-Charge *...*

C5
 3786

E. J. ...