


5 cm

218-104

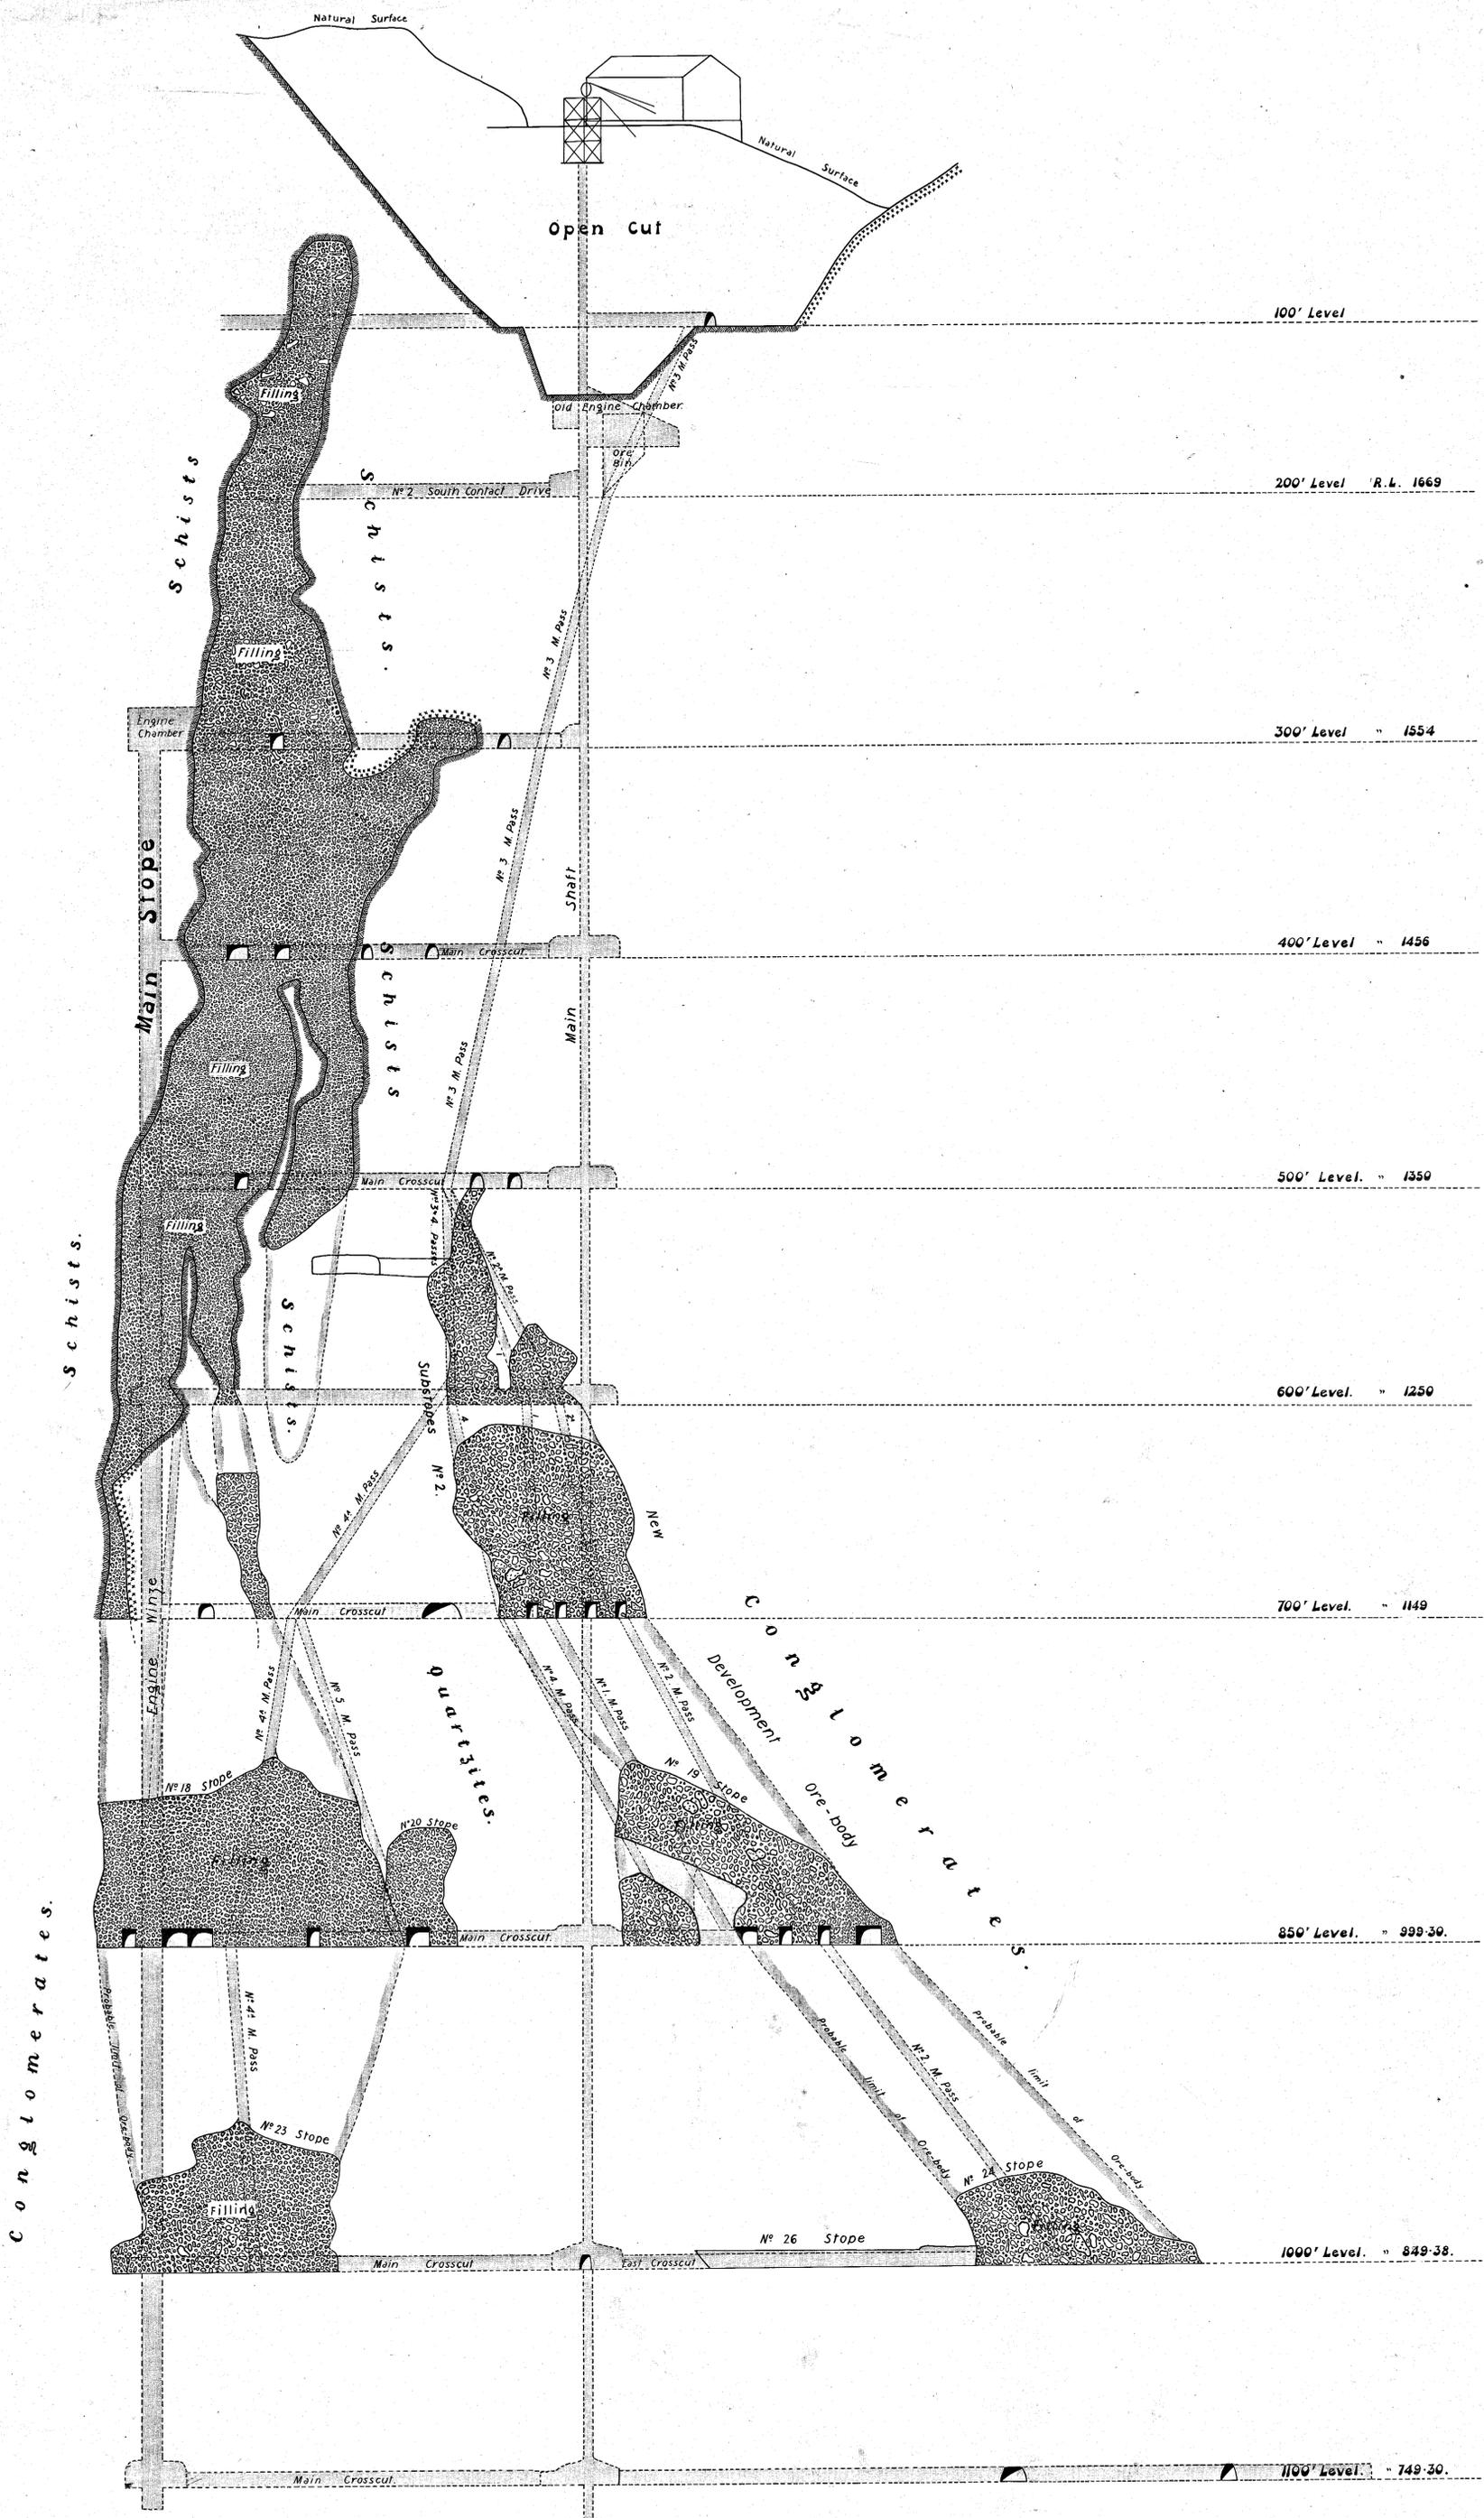

# The Mount Lyell Mining & Railway Co., Ltd.

Mine Department.

NORTH LYELL MINE.

SECTION ON LINE BB LOOKING NORTH

Scale 1 inch 30 feet.

General Manager *Robert Light*  
Engineer-in-Charge *William*

C7

218-104