


ES1

19

28-105

218-105


5 cm

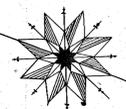

1100' LEVEL.

850' LEVEL.

200' LEVEL.

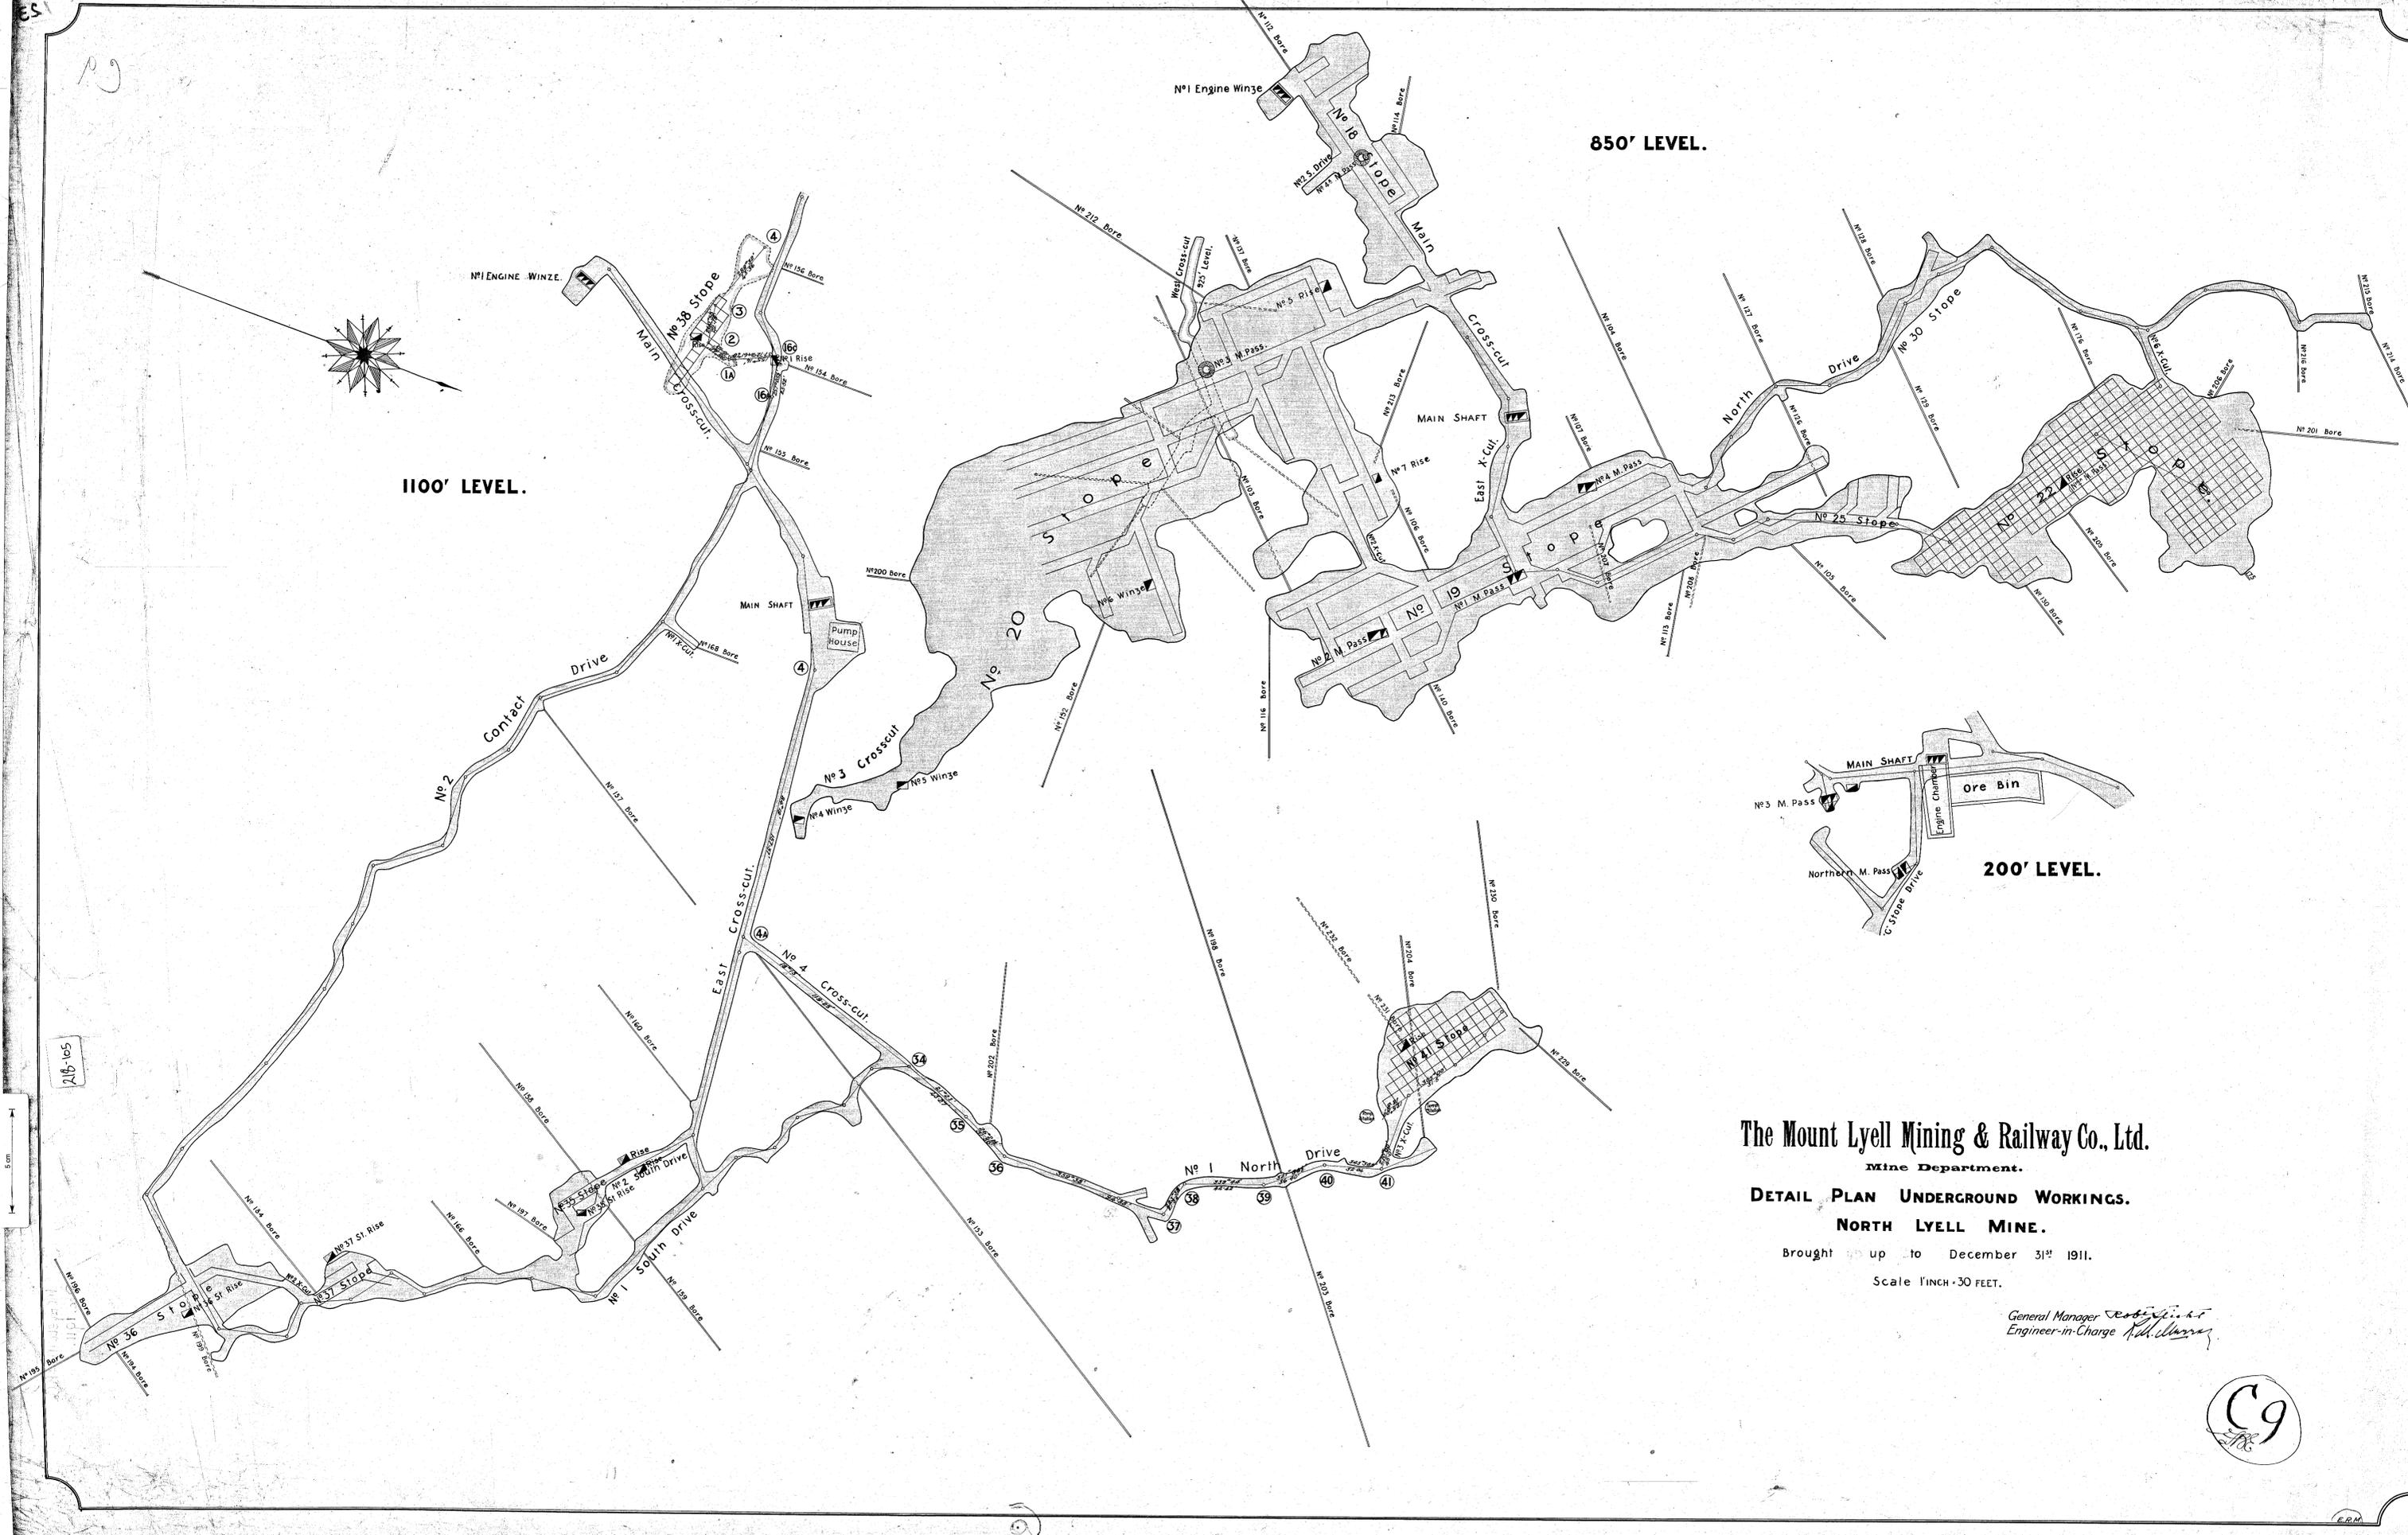

The Mount Lyell Mining & Railway Co., Ltd.

Mine Department.
DETAIL PLAN UNDERGROUND WORKINGS.
NORTH LYELL MINE.

Brought up to December 31st 1911.
Scale 1 inch = 30 FEET.

General Manager *Robt. J. ...*
Engineer-in-Charge *A. H. ...*

C9

E.M.