


5 cm

218-110

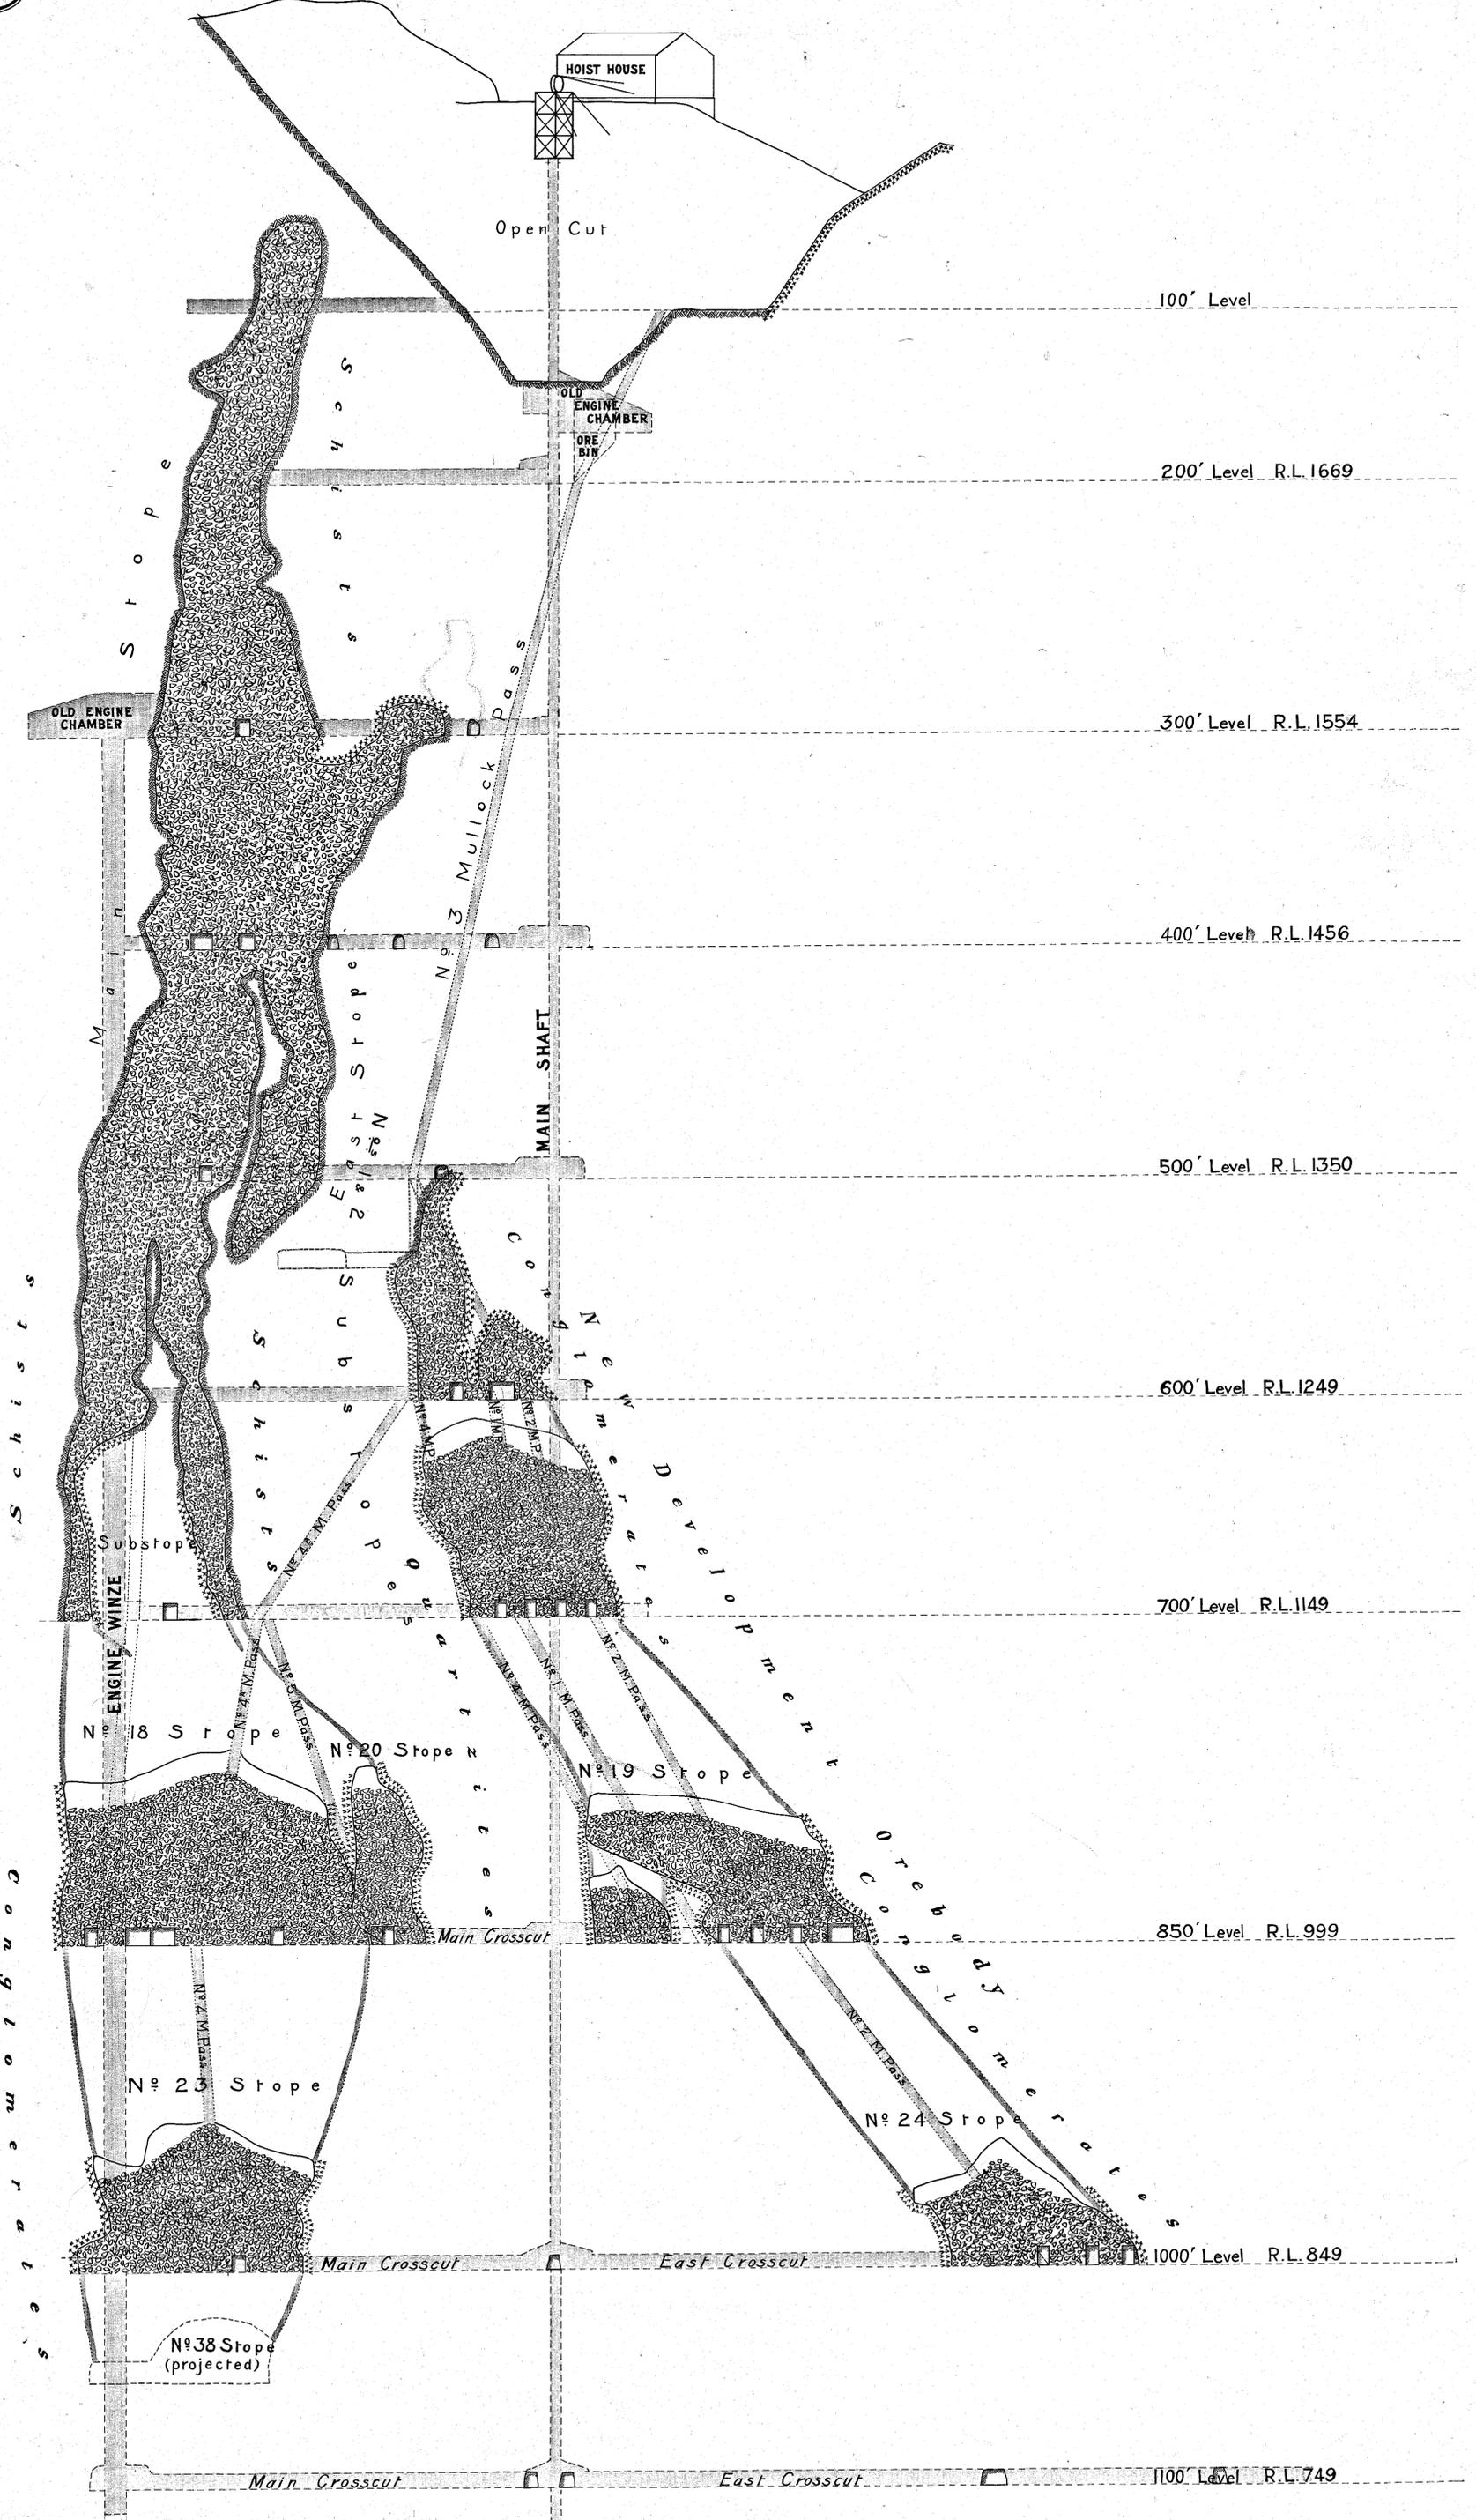

The Mount Lyell Mining & Railway Co. Ltd.

Mine Department.

NORTH LYELL MINE

Section on Line BB looking North

Brought up to Dec. 31st 1911

Scale 1" = 30'

General Manager *Edmund*
Engineer-in-Charge *R. W. Murray*

C8
7798
2706.