

The Mount Lyell Mining & Railway Co., Ltd.


Mine Department.
DETAIL PLAN UNDERGROUND WORKINGS

MOUNT LYELL MINE.

Brought up to December 31st 1911.

Scale 1 Inch = 30 feet.

General Manager *Robt. Smith*
 Engineer-in-Charge *R. W. Murray*

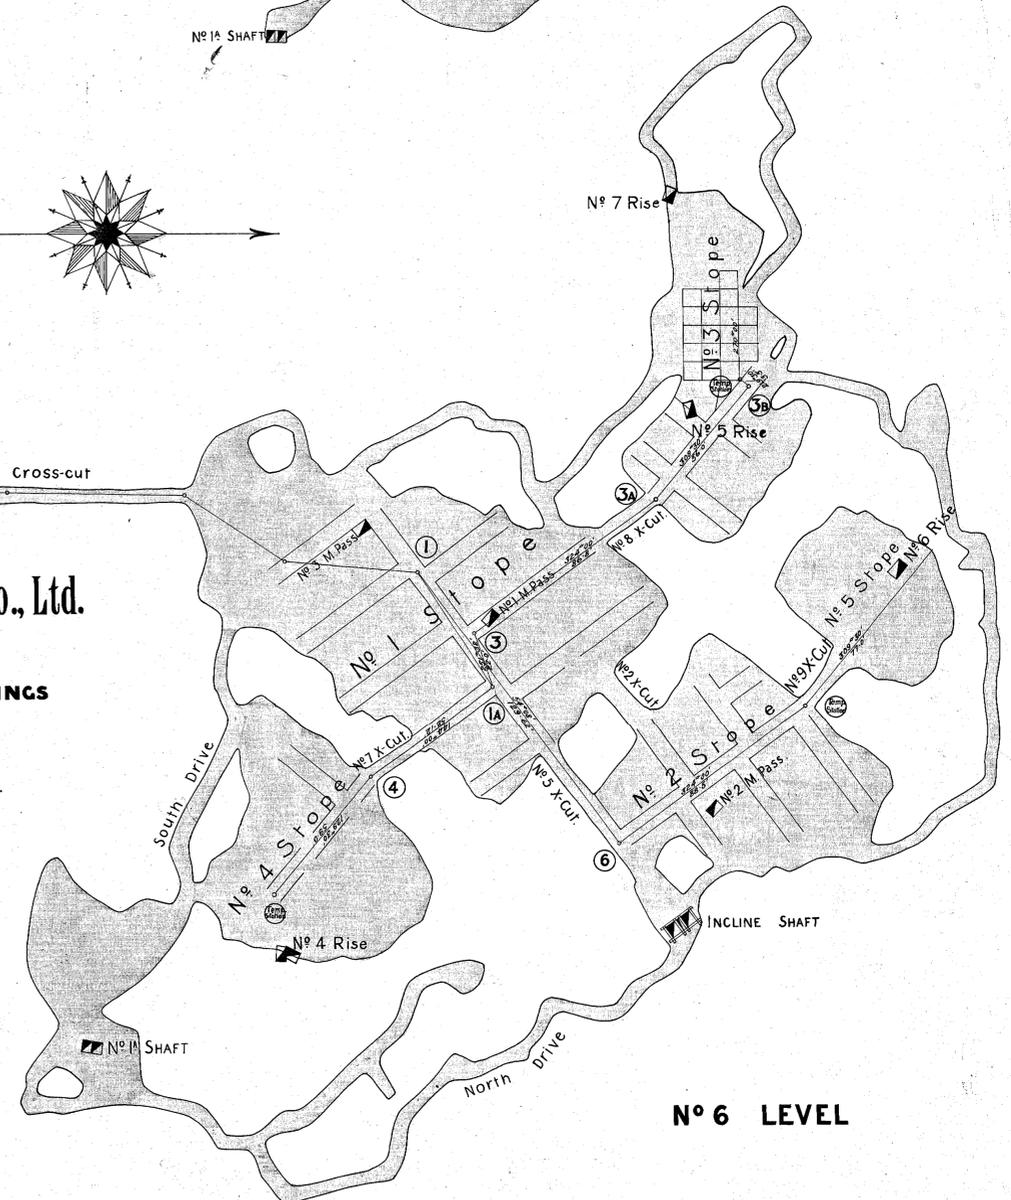

218-111



218-111

153

E.C.M.