


218-112

218-112

5 cm

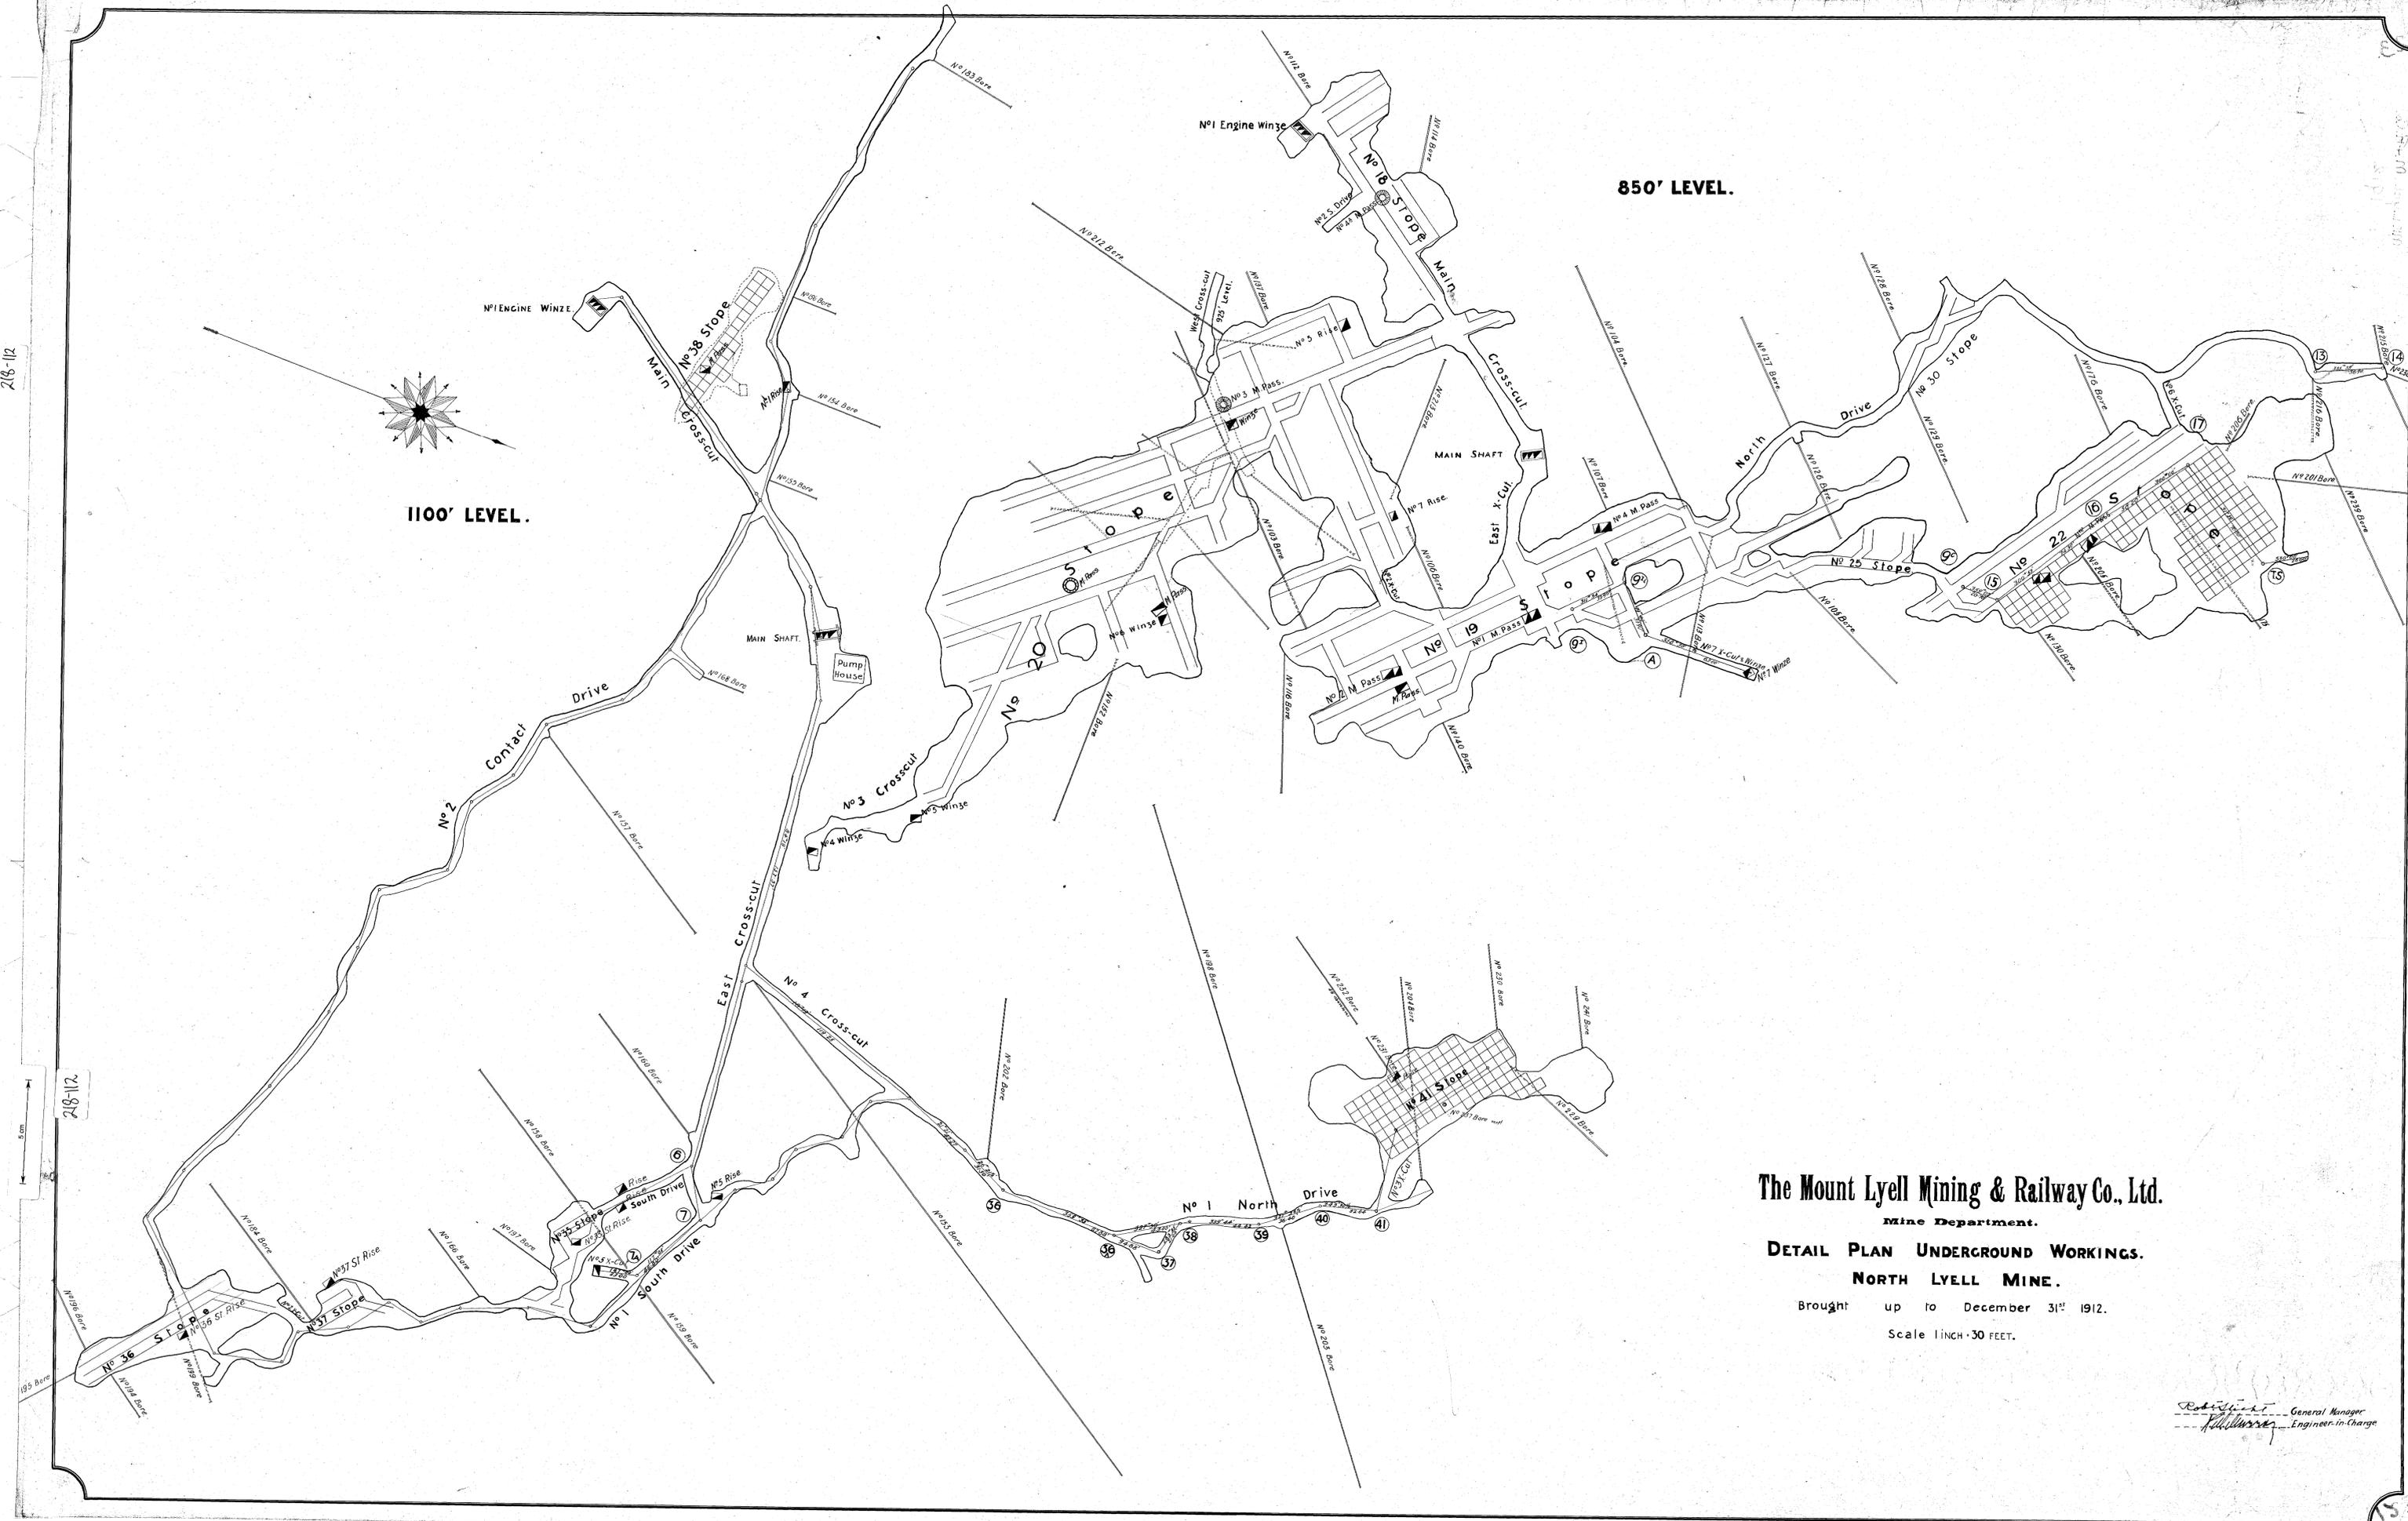

The Mount Lyell Mining & Railway Co., Ltd.
 Mine Department.
DETAIL PLAN UNDERGROUND WORKINGS.
NORTH LYELL MINE.
 Brought up to December 31st 1912.
 Scale 1 inch = 30 FEET.

Robert Lyell General Manager
H. W. ... Engineer in Charge