


218-113

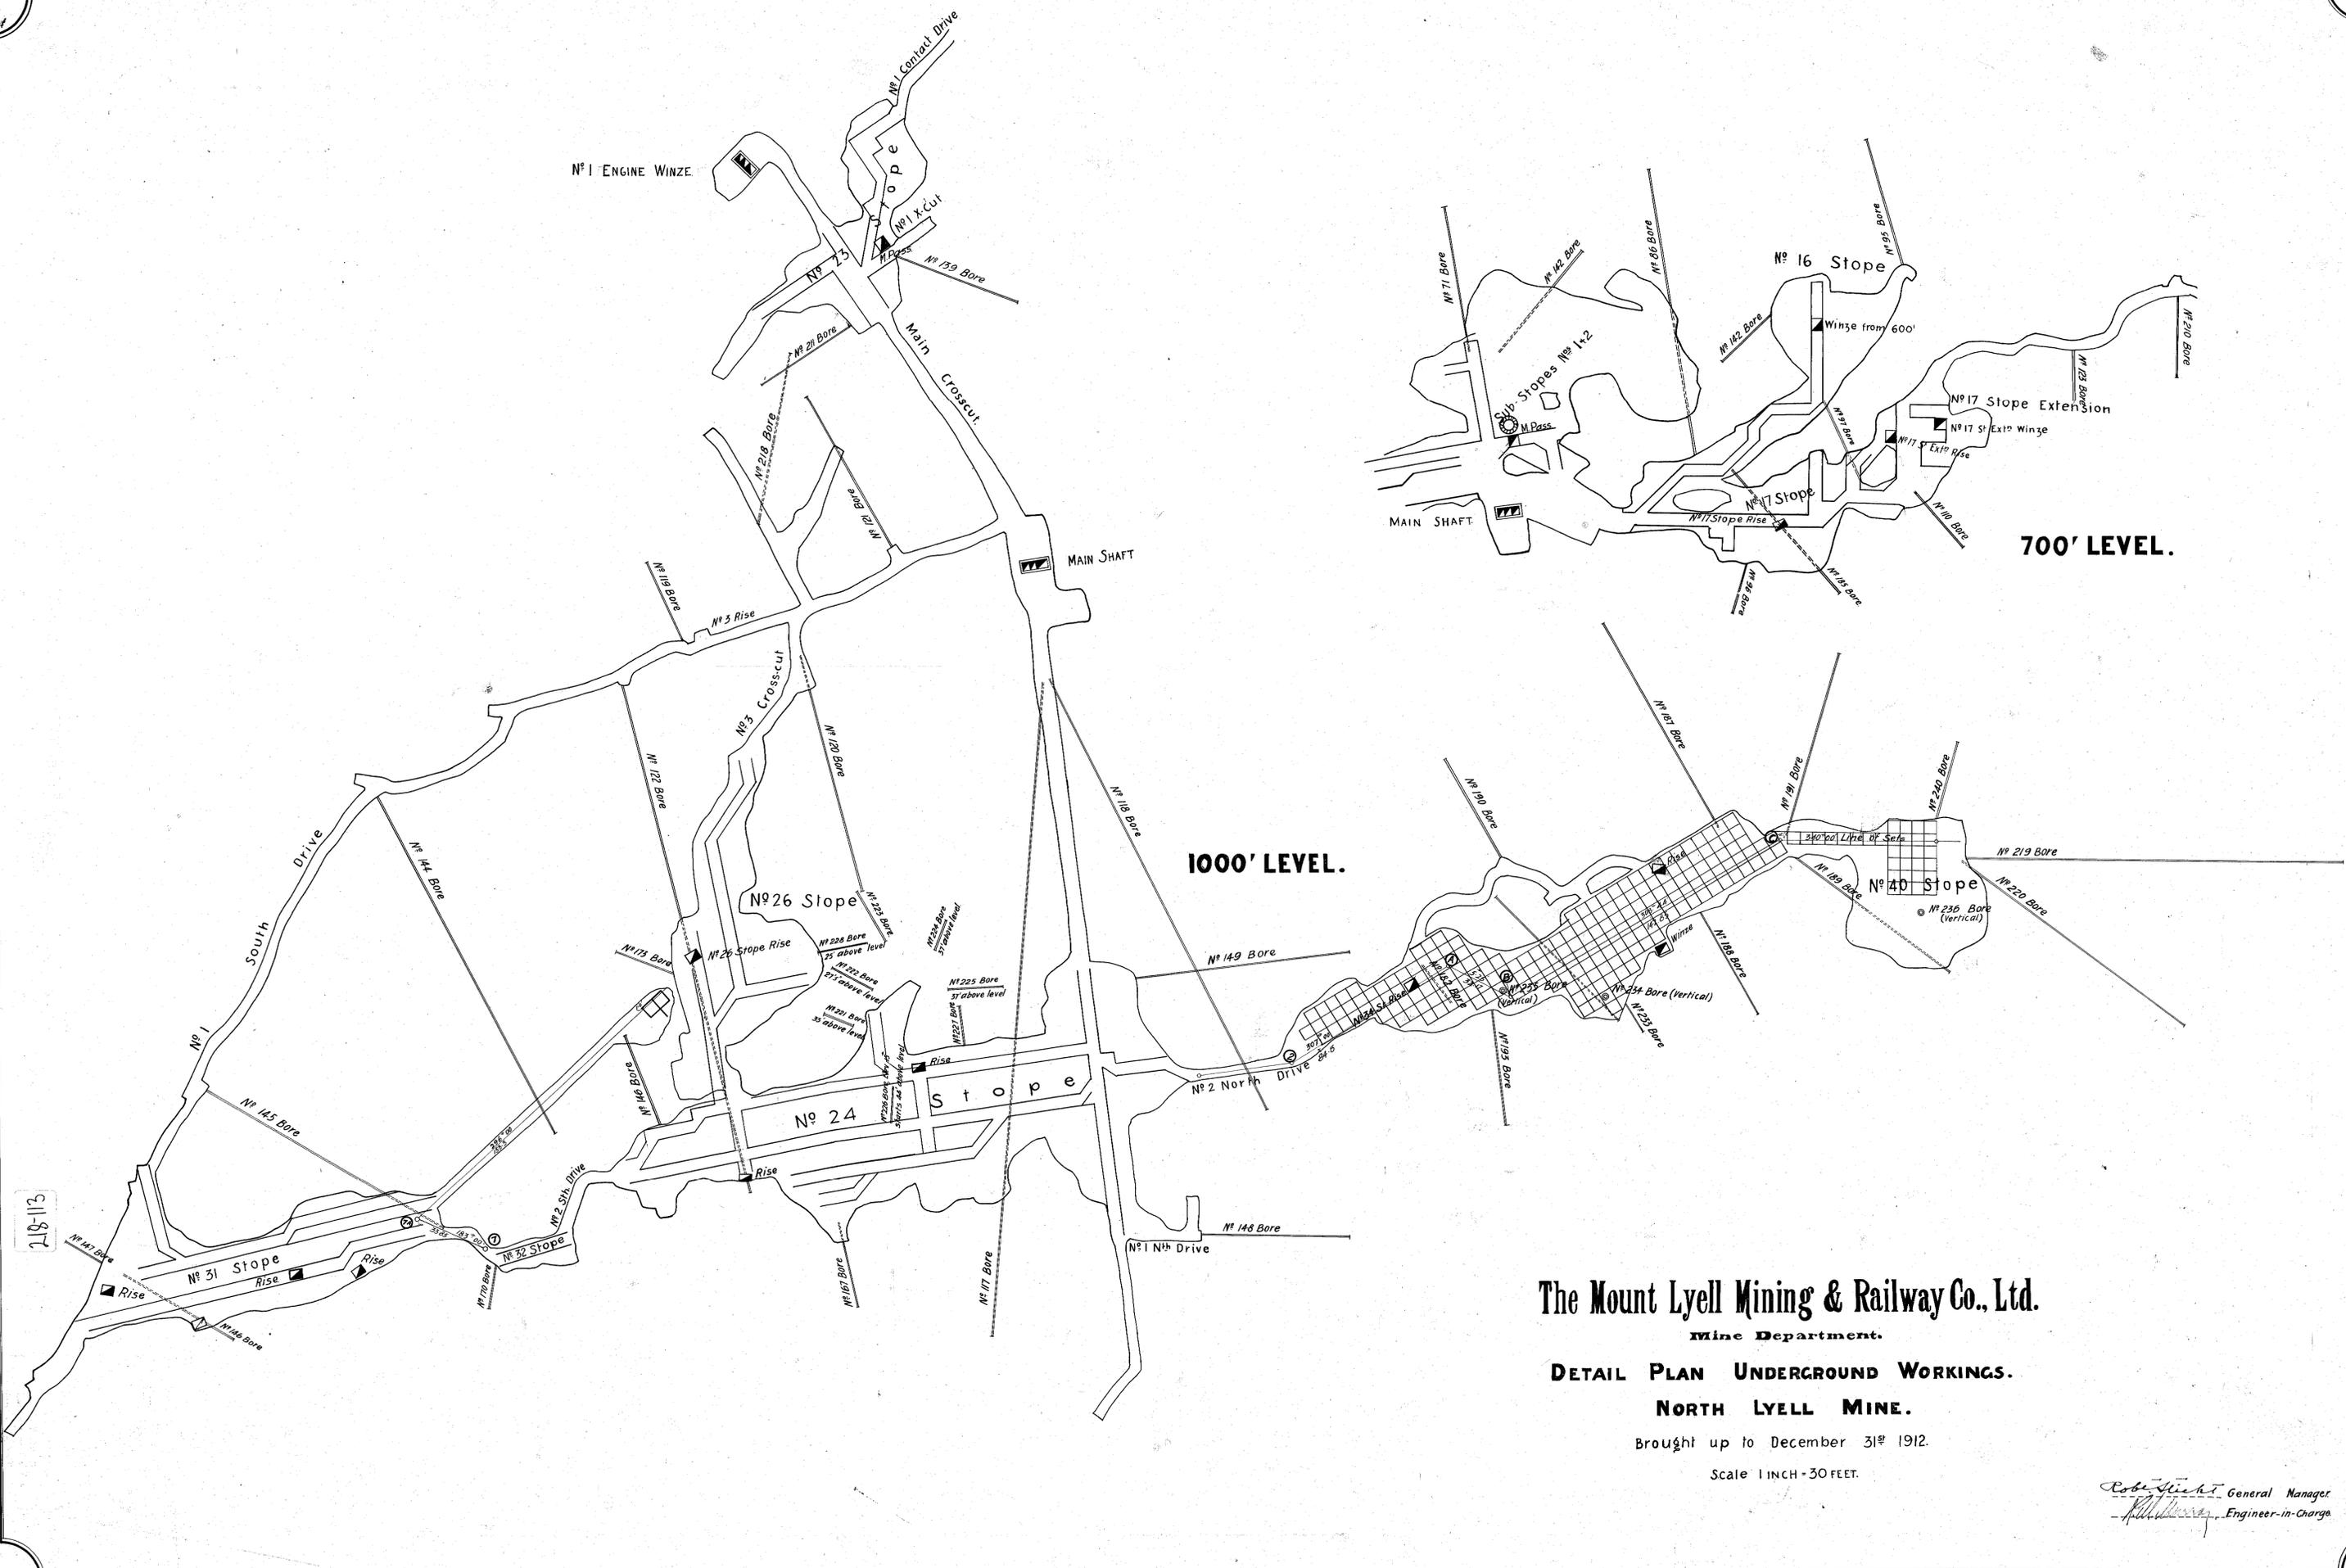

218-113

50 ft

The Mount Lyell Mining & Railway Co., Ltd.

Mine Department.

DETAIL PLAN UNDERGROUND WORKINGS.

NORTH LYELL MINE.

Brought up to December 31st 1912.

Scale 1 INCH = 30 FEET.

Robert J. Fisher General Manager
W. H. Murray Engineer-in-Charge