


218-116

218-116

5 cm

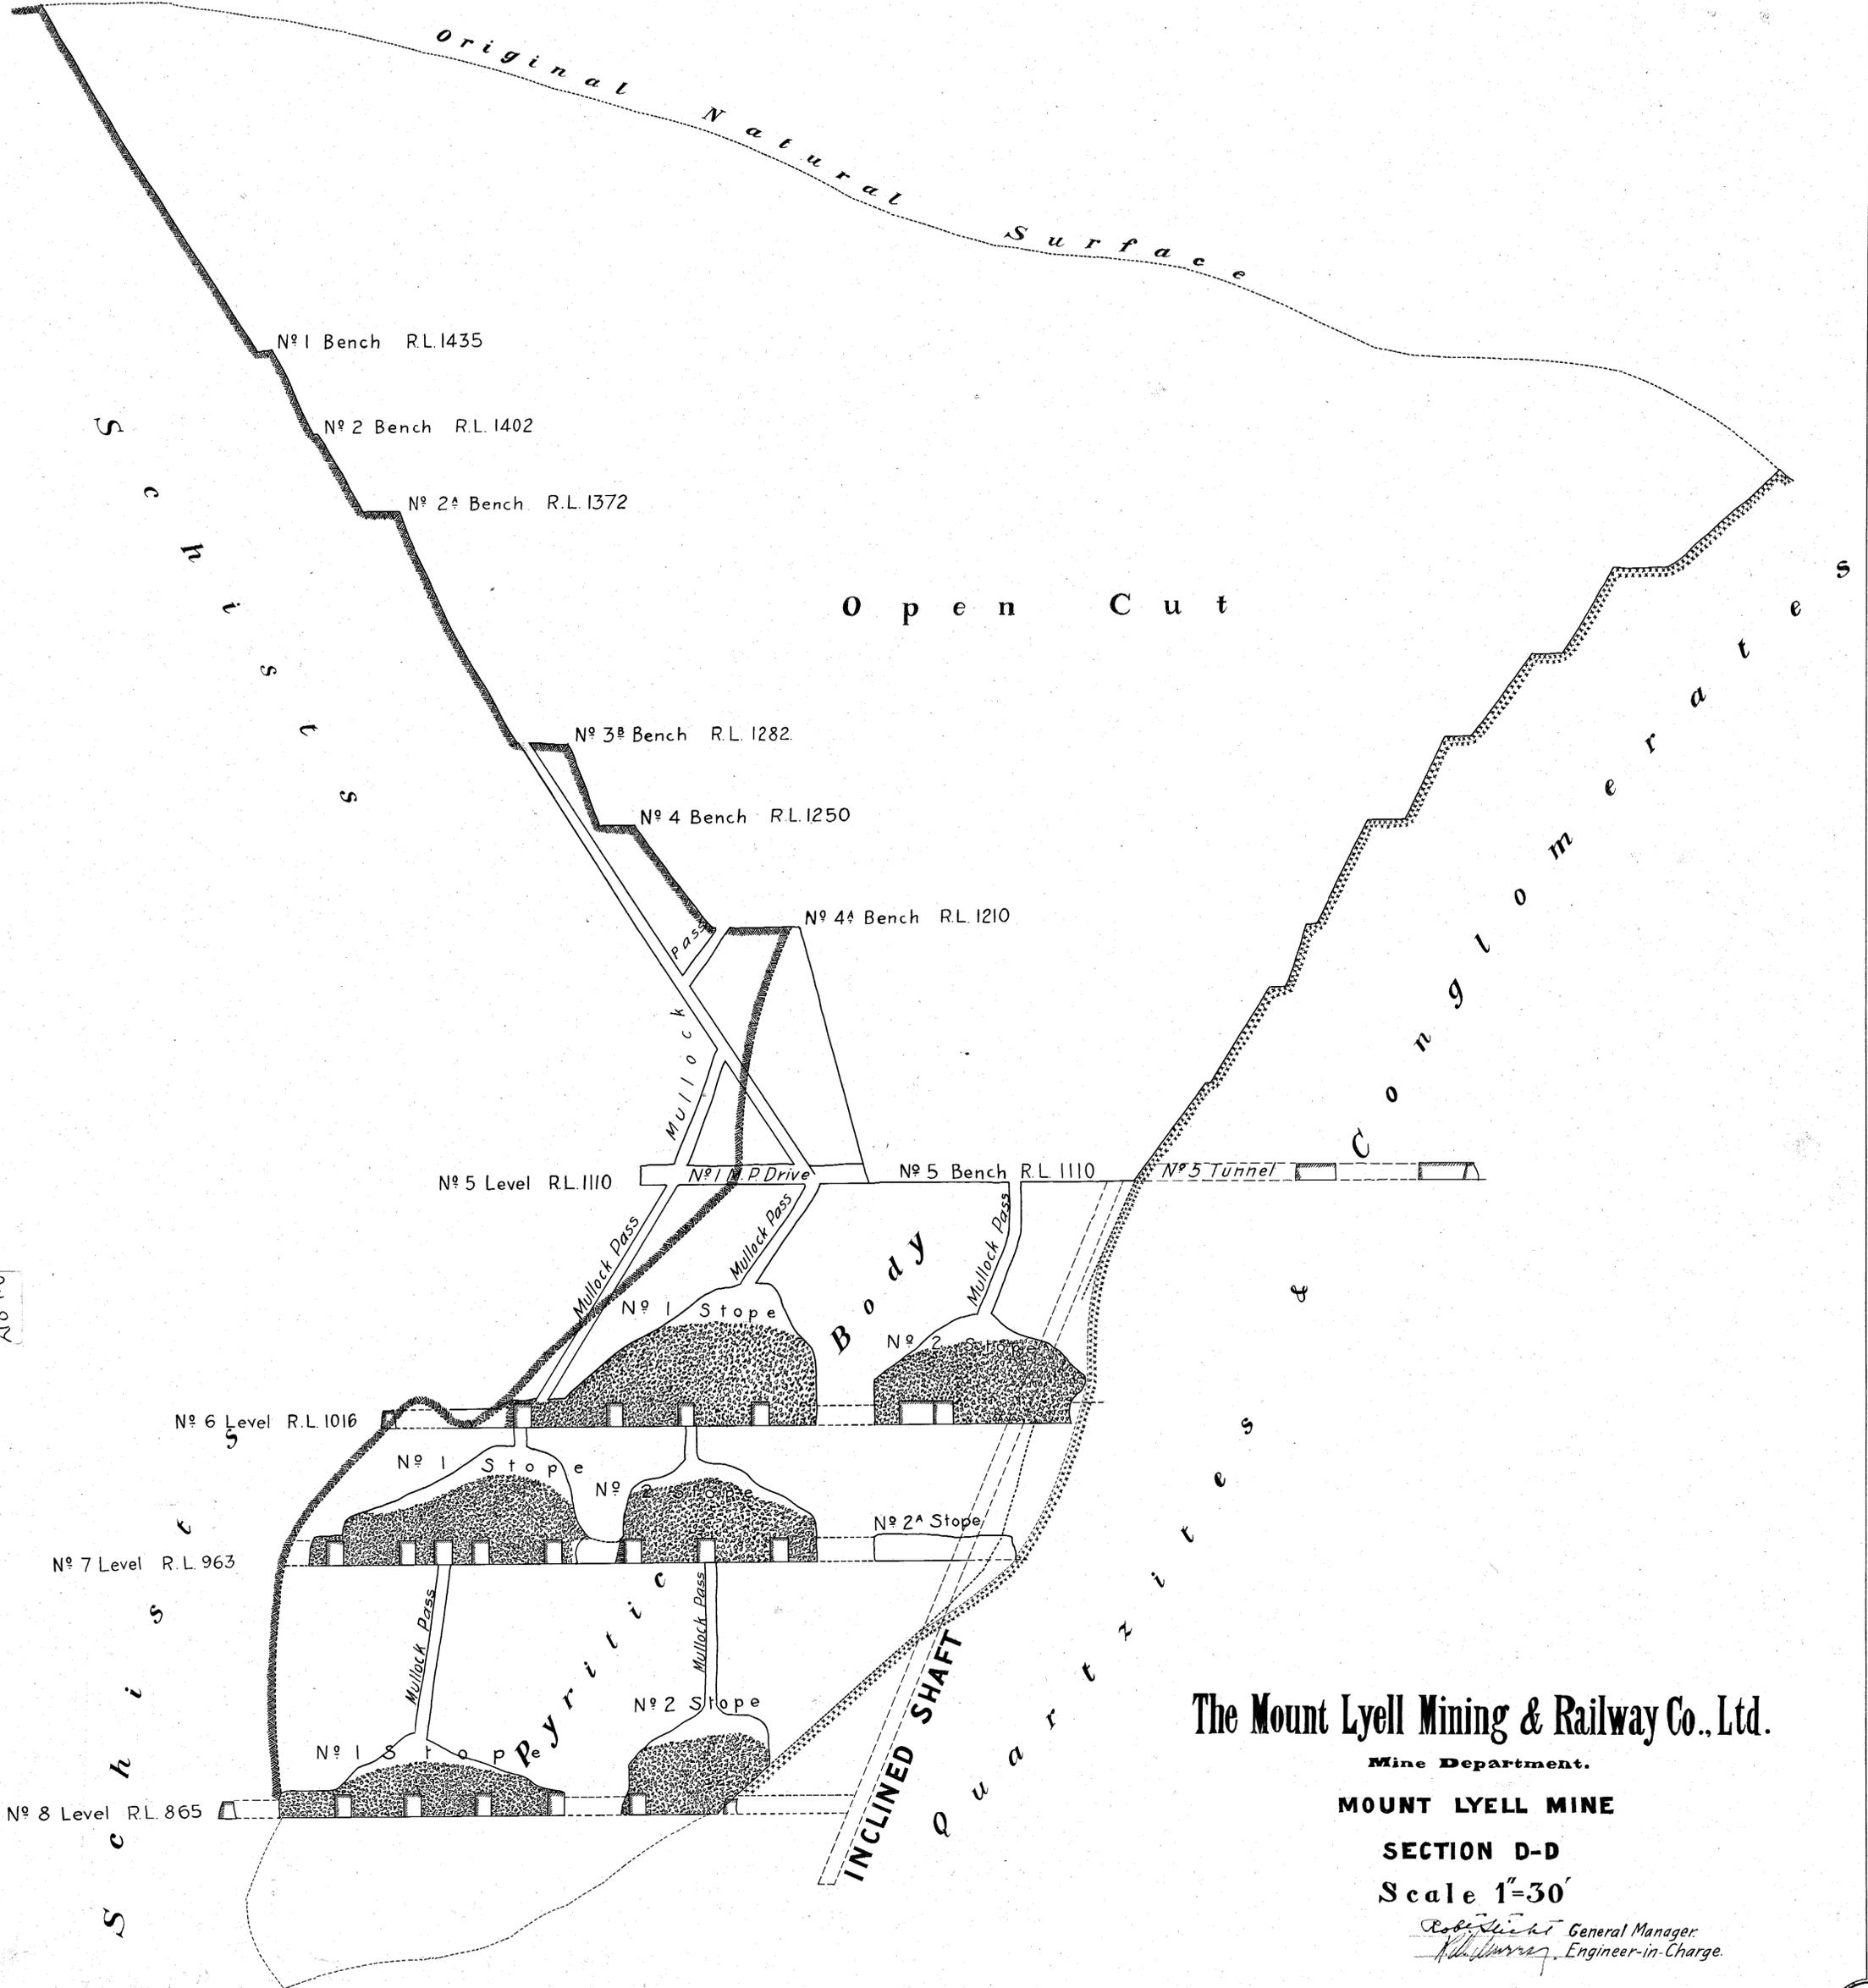

The Mount Lyell Mining & Railway Co., Ltd.

Mine Department.

MOUNT LYELL MINE

SECTION D-D

Scale 1"=30'

Robert Light General Manager.  
W. Murray Engineer-in-Charge.