


5 cm

218-118

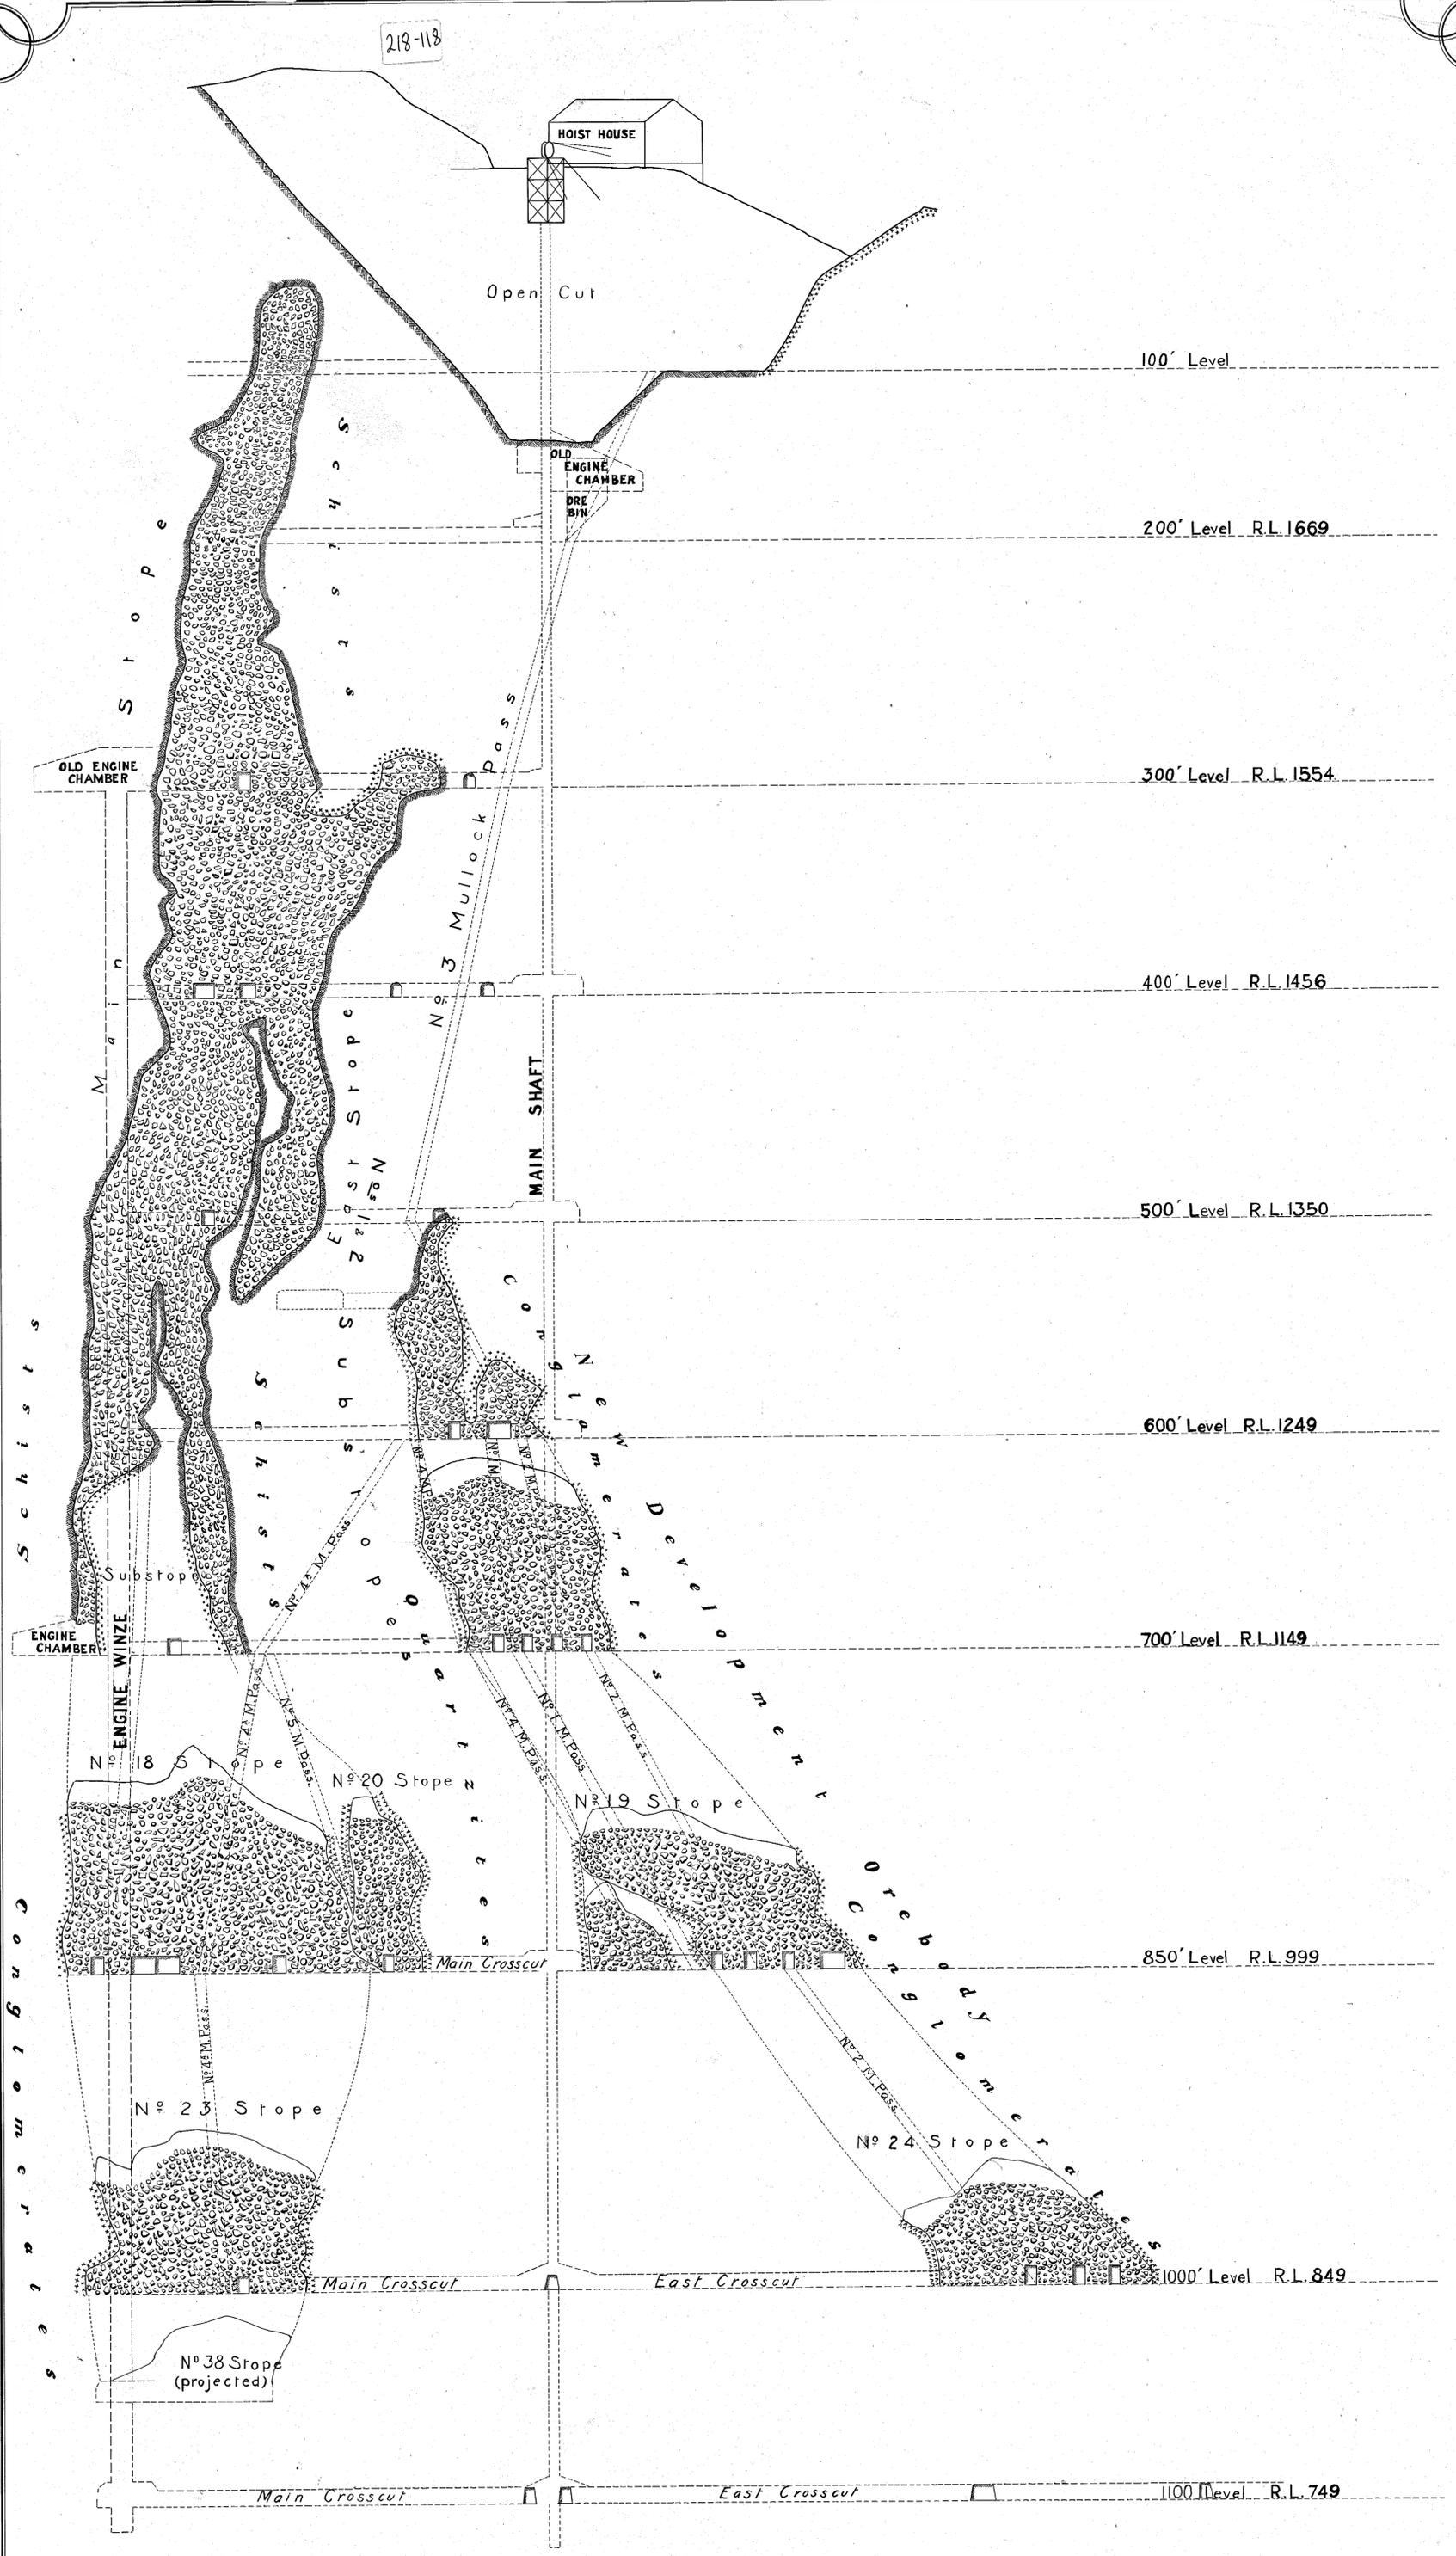

# The Mount Lyell Mining & Railway Co. Ltd.

Mine Department.

## NORTH LYELL MINE

Section on Line BB looking North

Brought up to Dec. 31<sup>st</sup> 1912

Scale 1" = 30'

*Robert Lyell* General Manager  
*A. H. Murray* Engineer-in-Charge