 



218-119



218-119

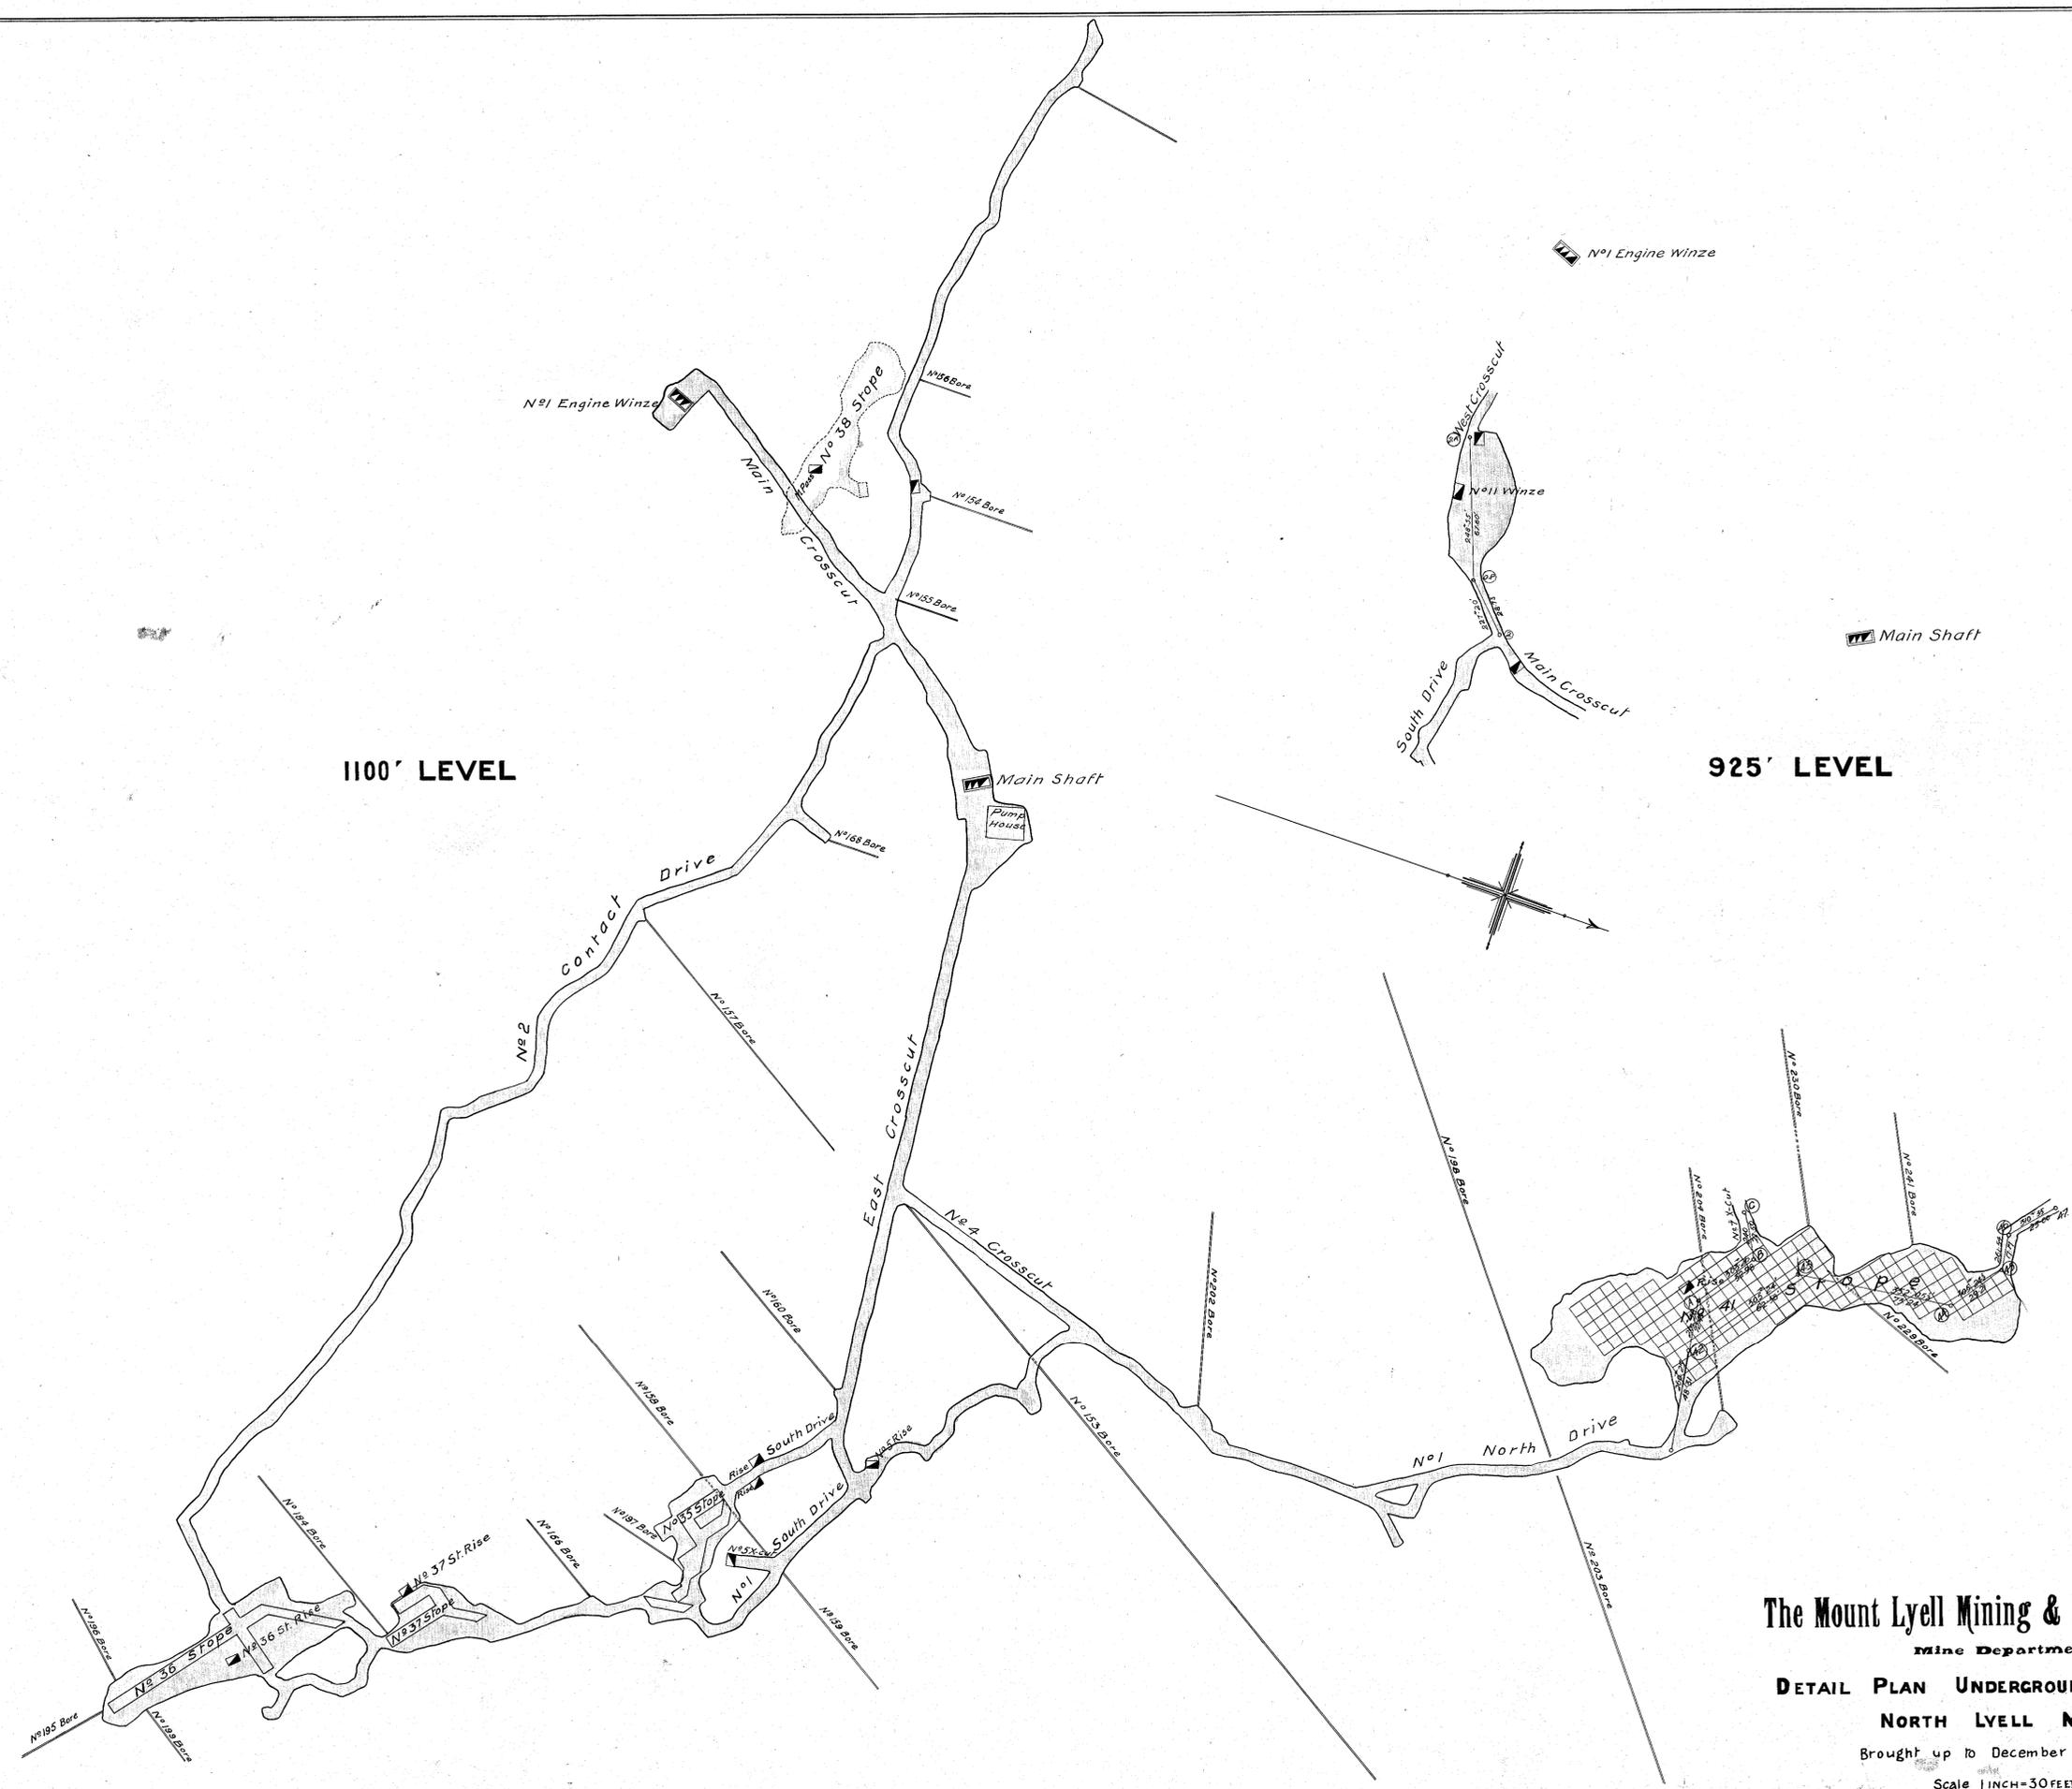

The Mount Lyell Mining & Railway Co., Ltd.
 Mine Department.
DETAIL PLAN UNDERGROUND WORKINGS.
NORTH LYELL MINE

Brought up to December 31st 1913
 Scale 1 INCH = 30 FEET

Local Superintendent
 Engineer-in-Charge