
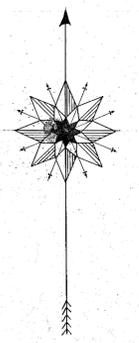
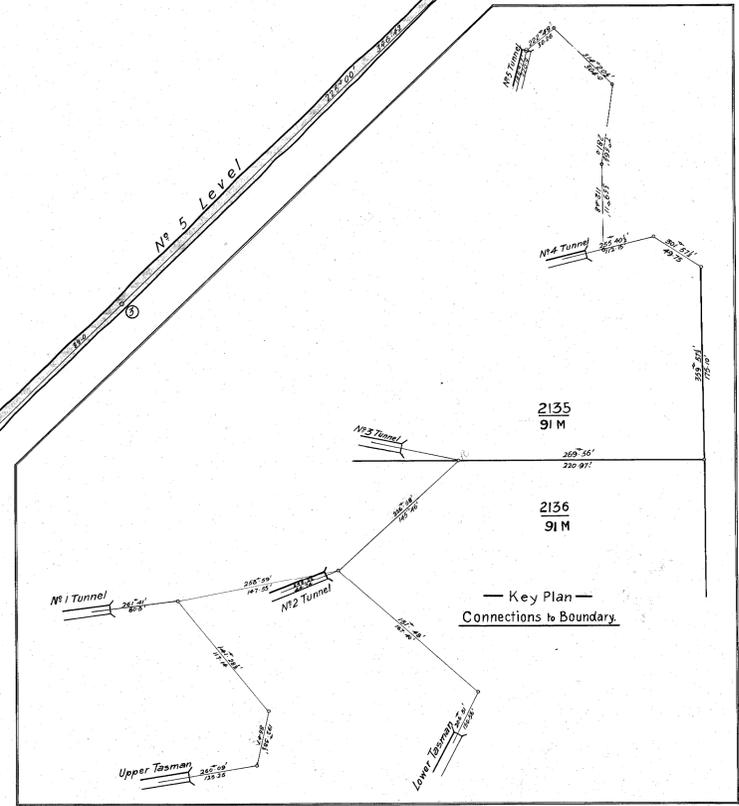


218-121

218-121

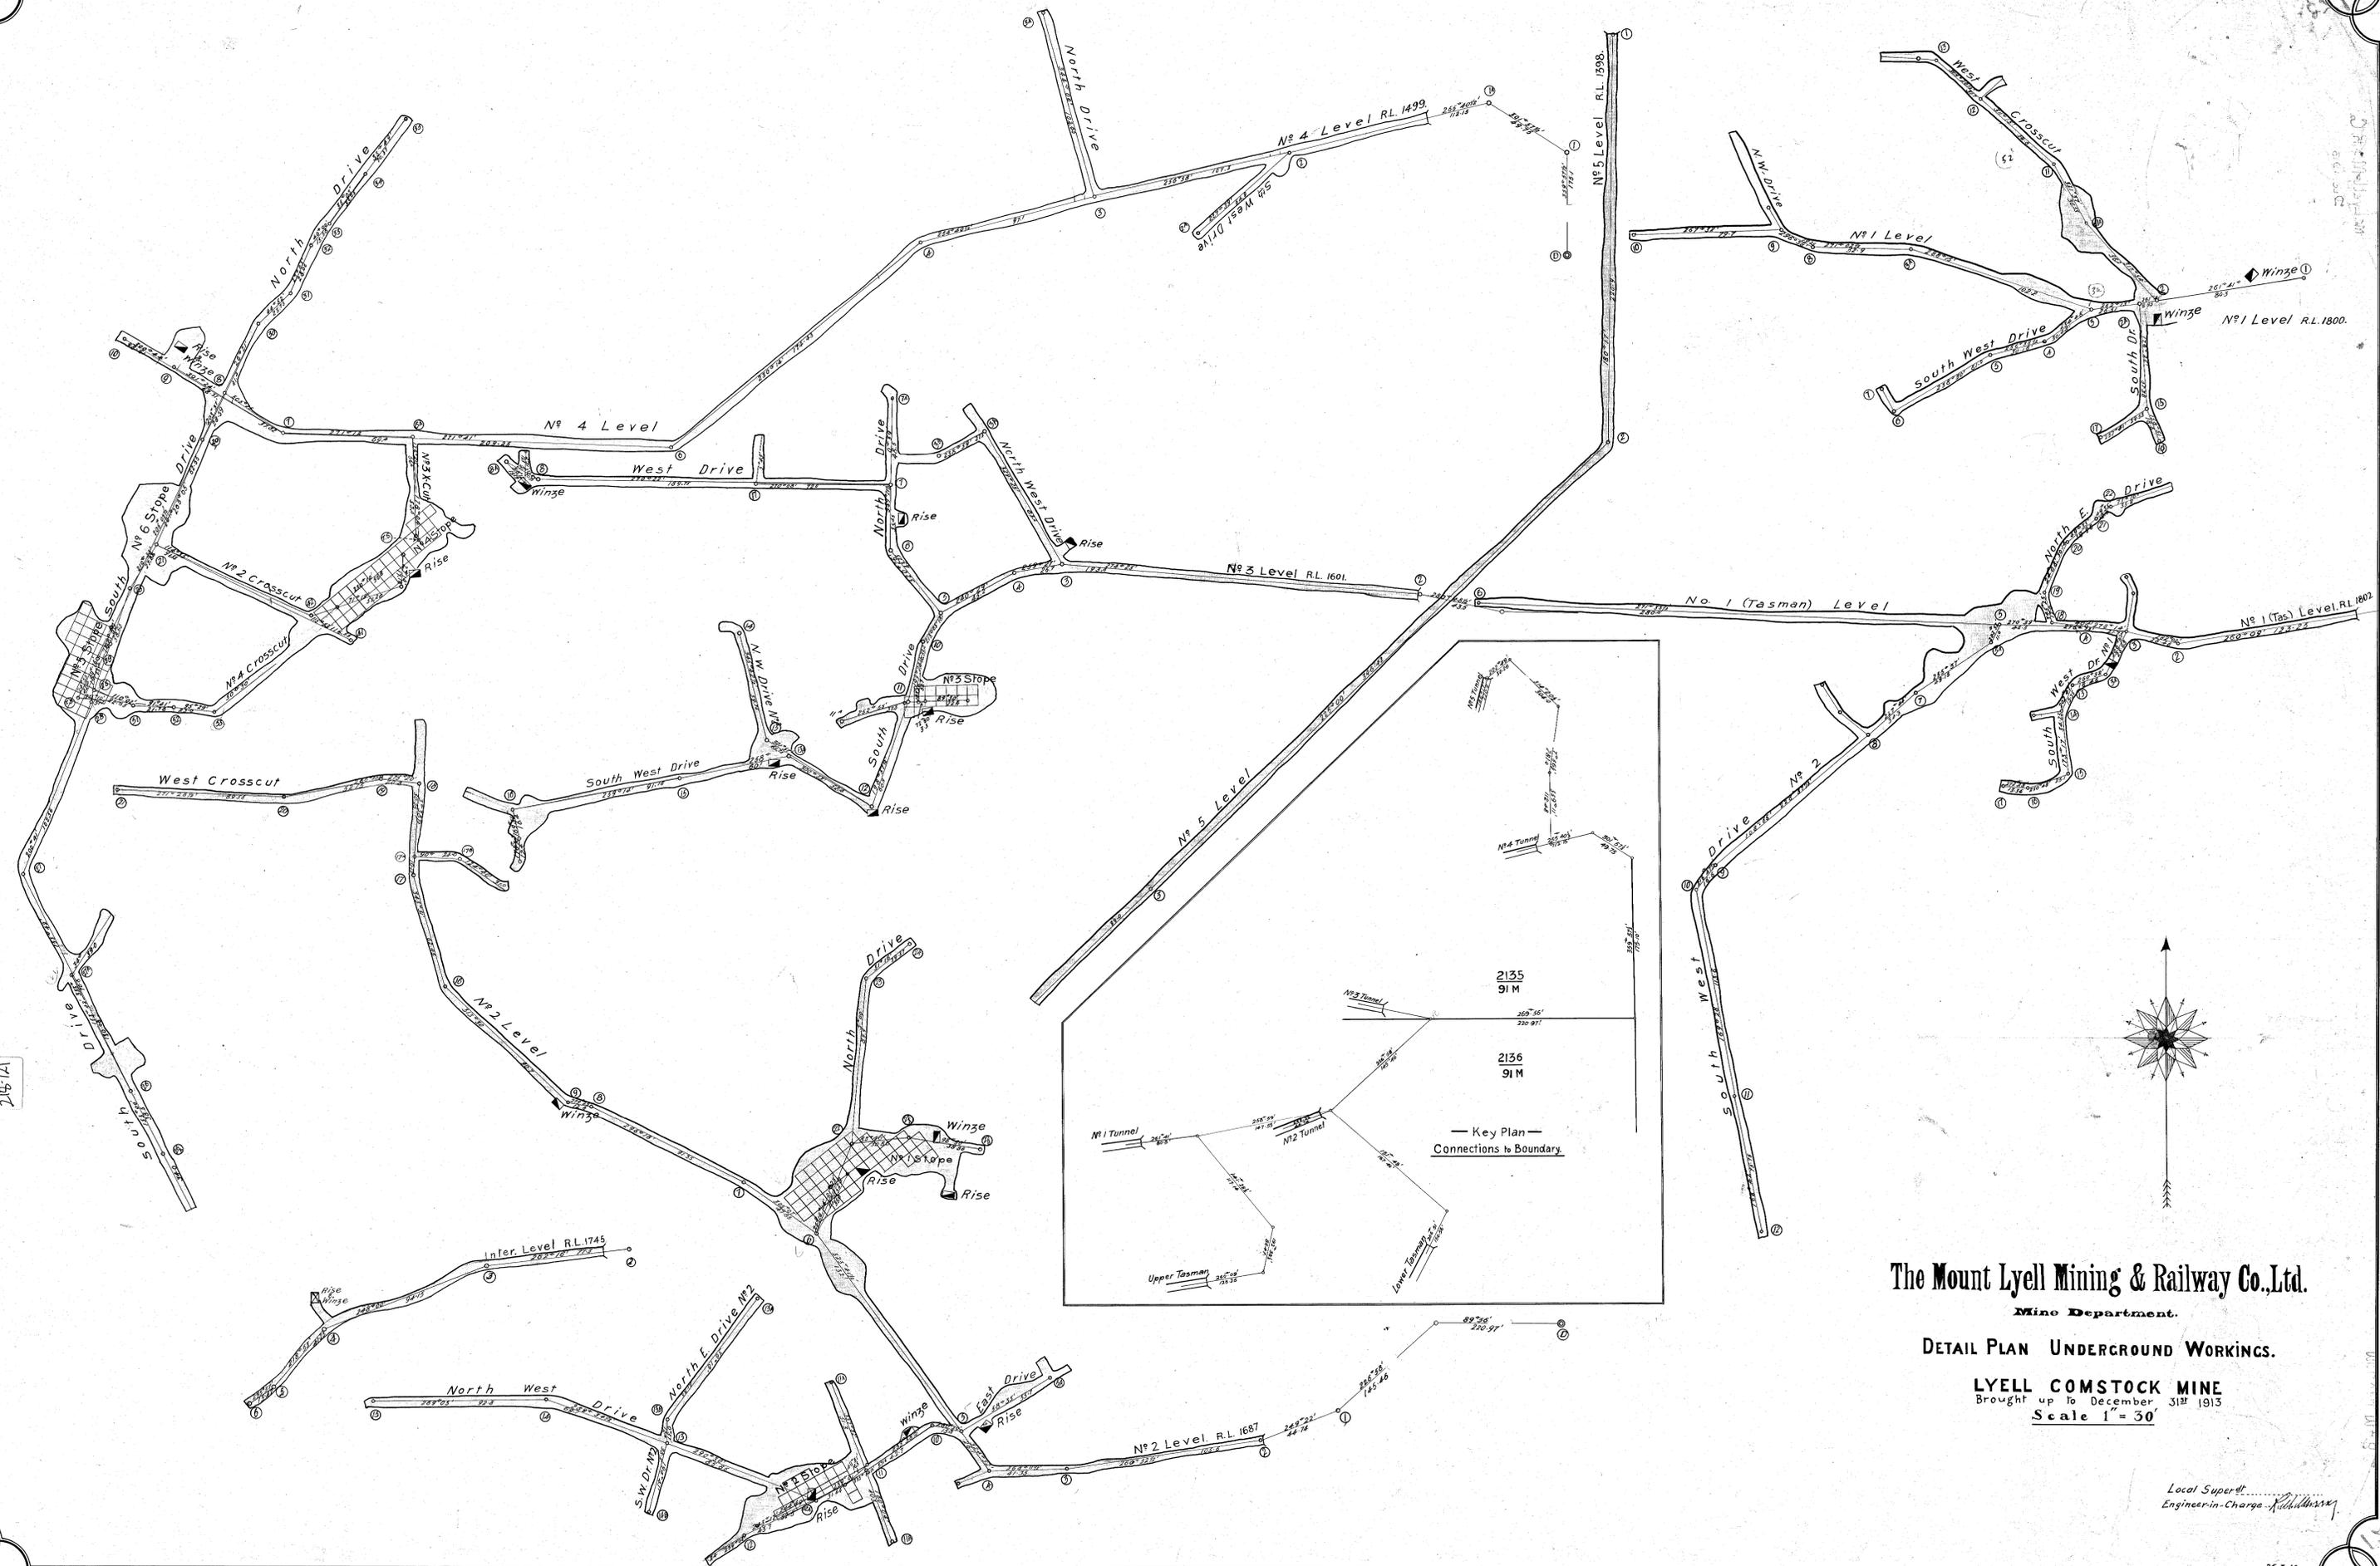

The Mount Lyell Mining & Railway Co., Ltd.
 Mine Department.
DETAIL PLAN UNDERGROUND WORKINGS.
LYELL COMSTOCK MINE
 Brought up to December, 31st 1913
 Scale 1" = 30'

Local Superint.
 Engineer-in-Charge. *Richardson*