

The Mount Lyell Mining & Railway Co. Ltd.

Mine Department.


LYELL COMSTOCK MINE.

Longitudinal Section looking N. West.

Scale 1" = 30'

Brought up to December 31st 1913

W. H. Murray Local Superintendent
Engineer-in-Charge

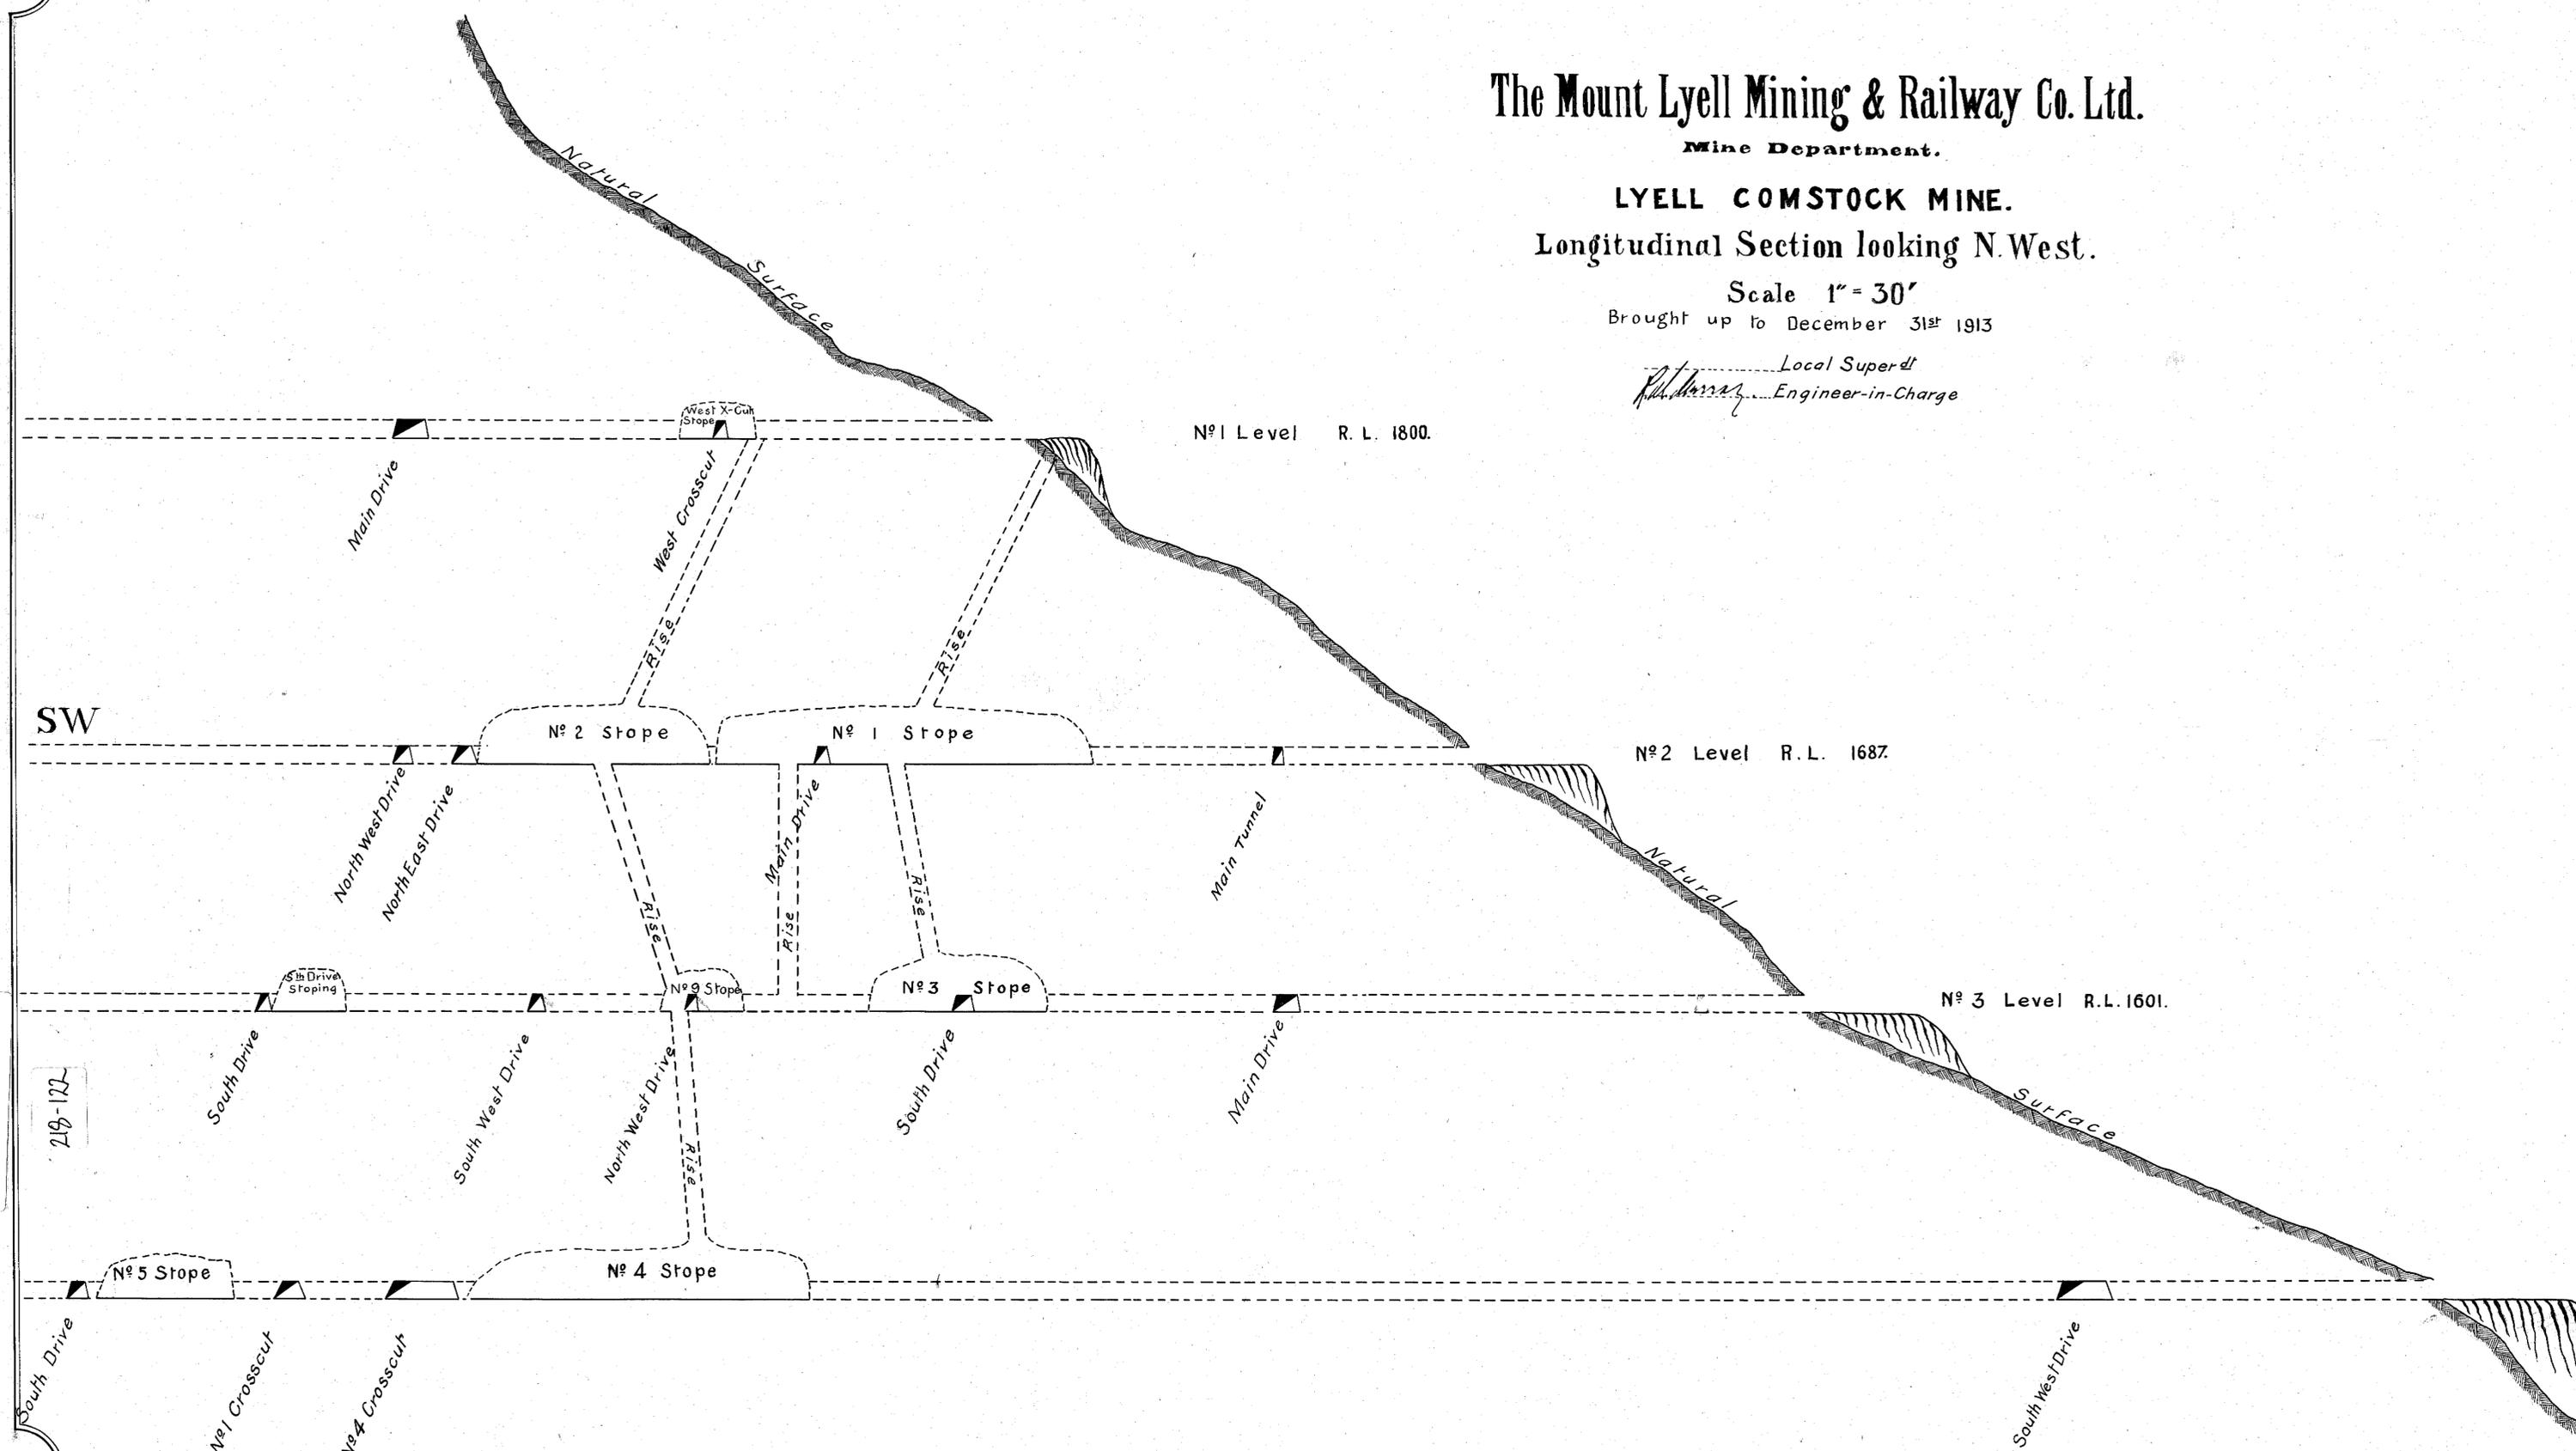

218-122

218-122

5 cm

31.3.14