


218-123

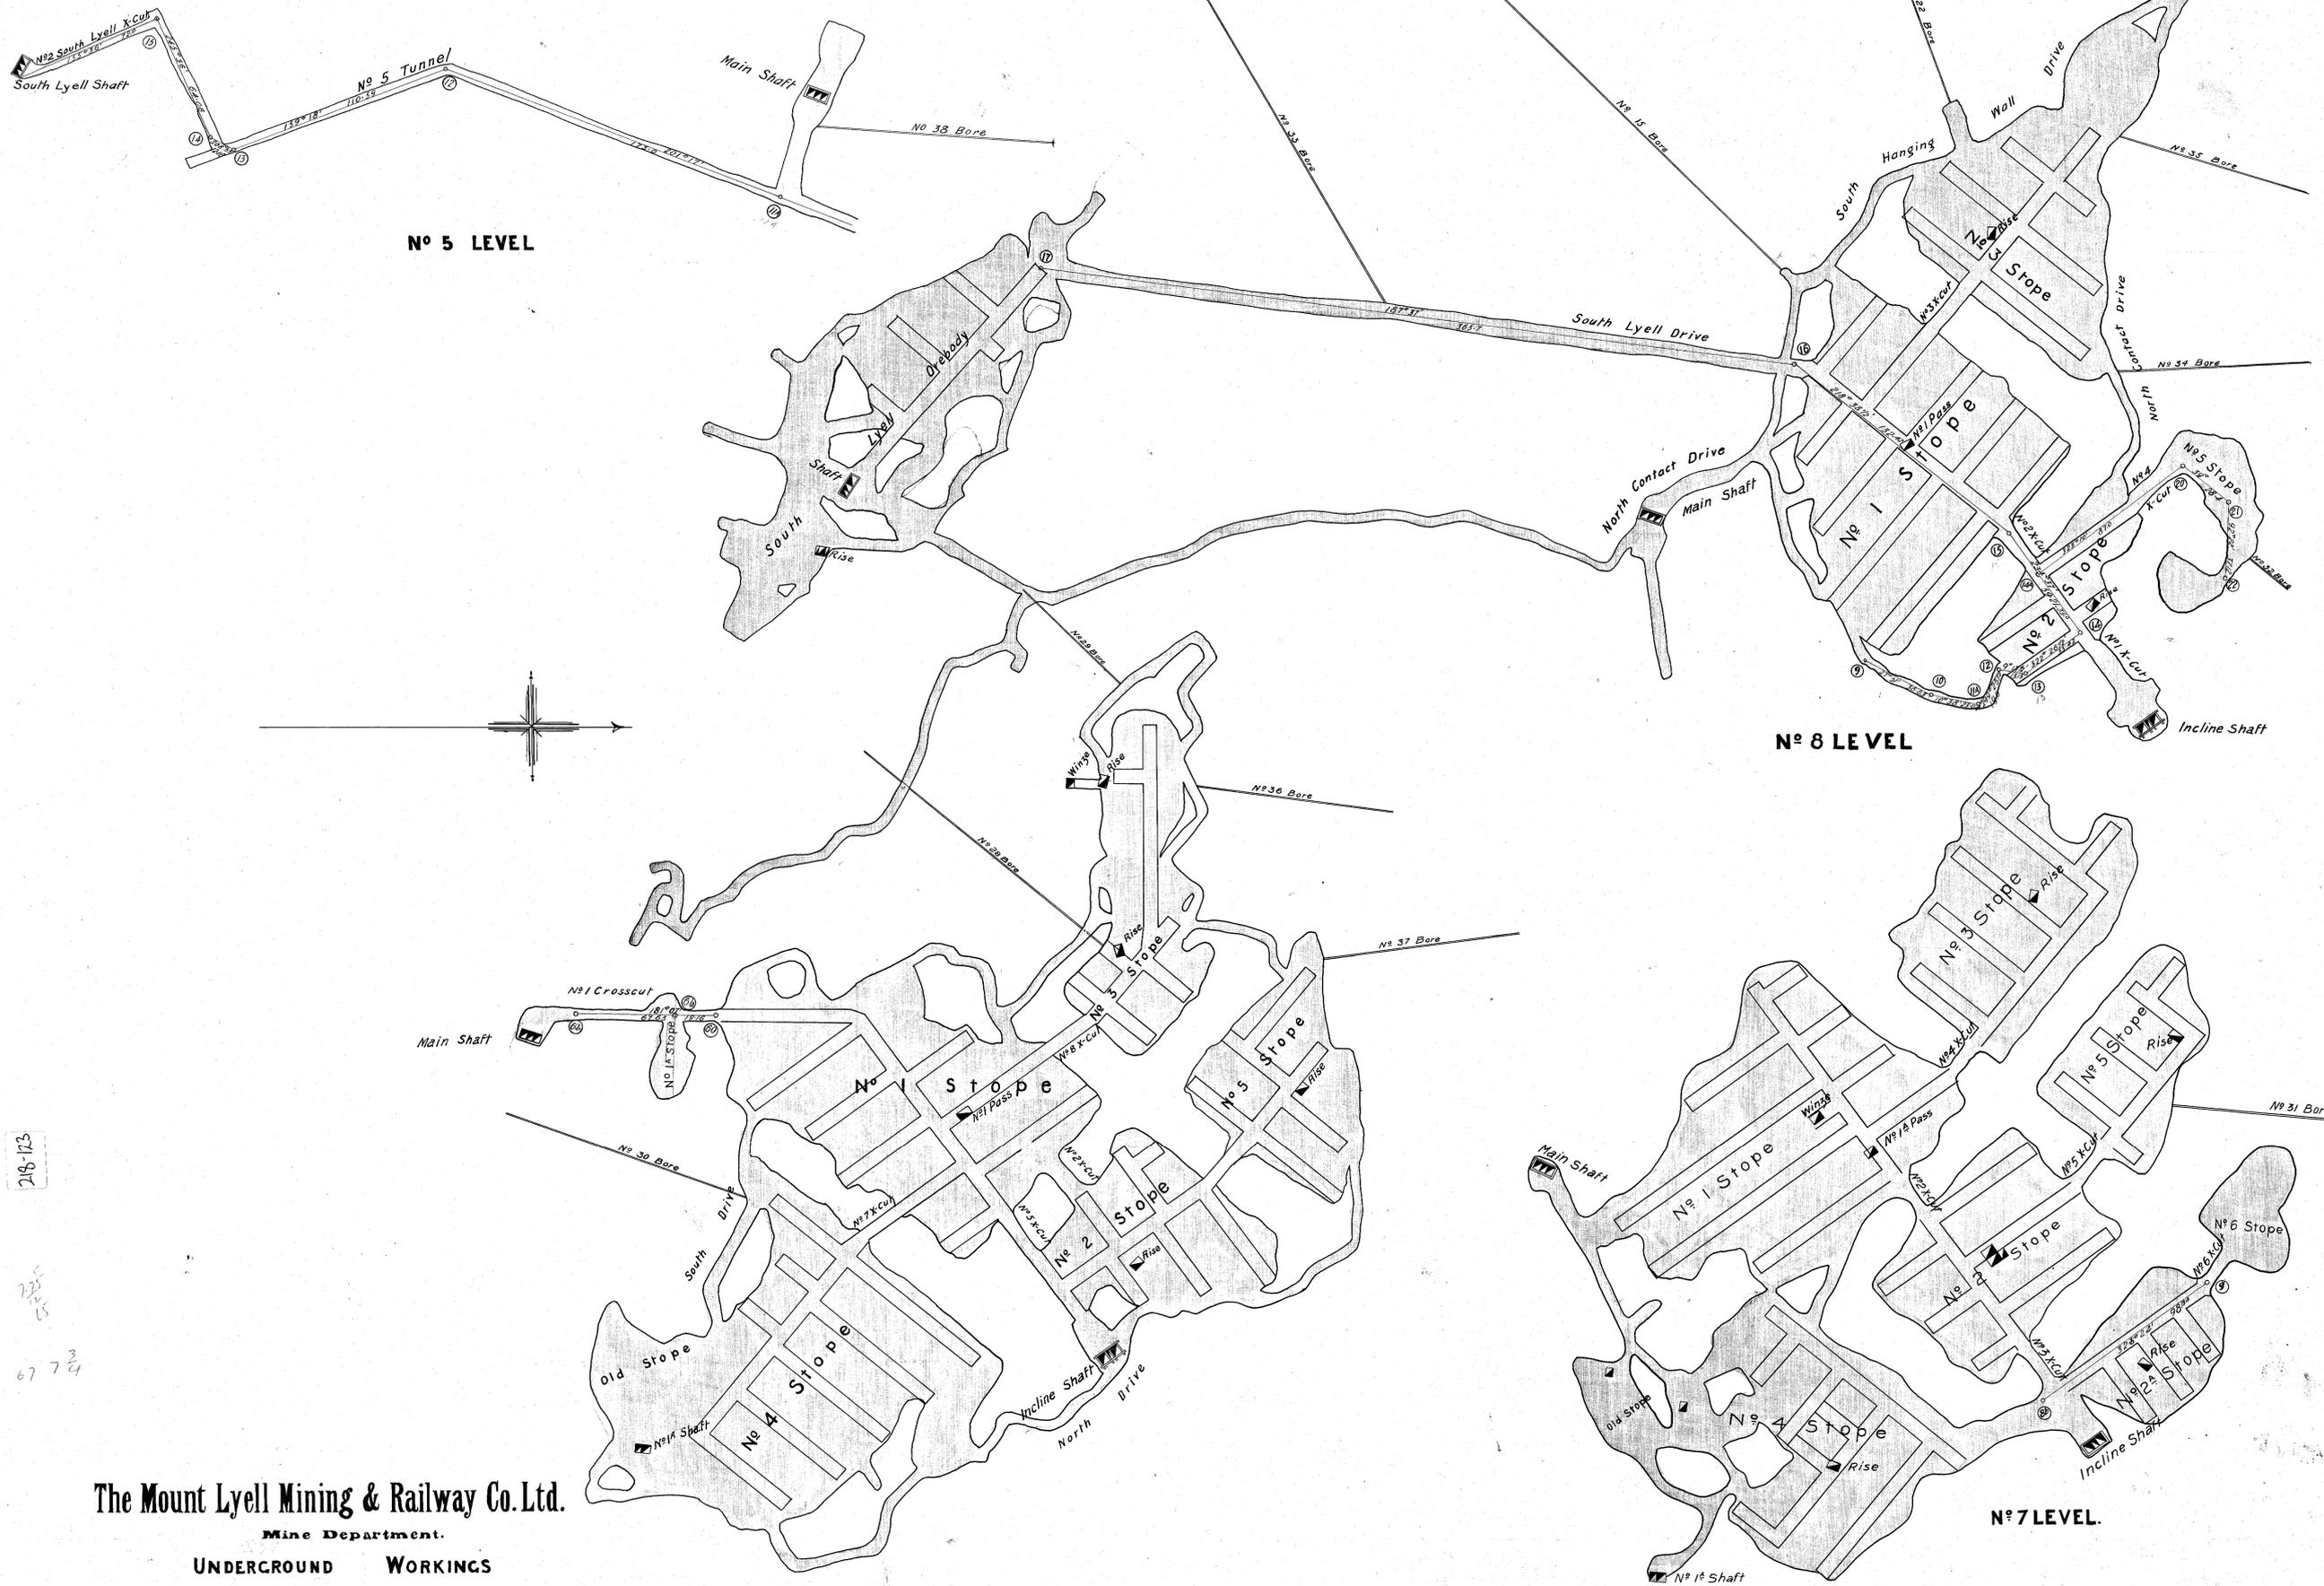

218-123

67 7/8

The Mount Lyell Mining & Railway Co. Ltd.
 Mine Department.
UNDERGROUND WORKINGS
MOUNT LYELL MINE
 Brought up to December 31st 1913
 Scale 1" = 30'

Local Superintendent
[Signature]
 Engineer-in-Charge