


218-124

218-124

5 cm

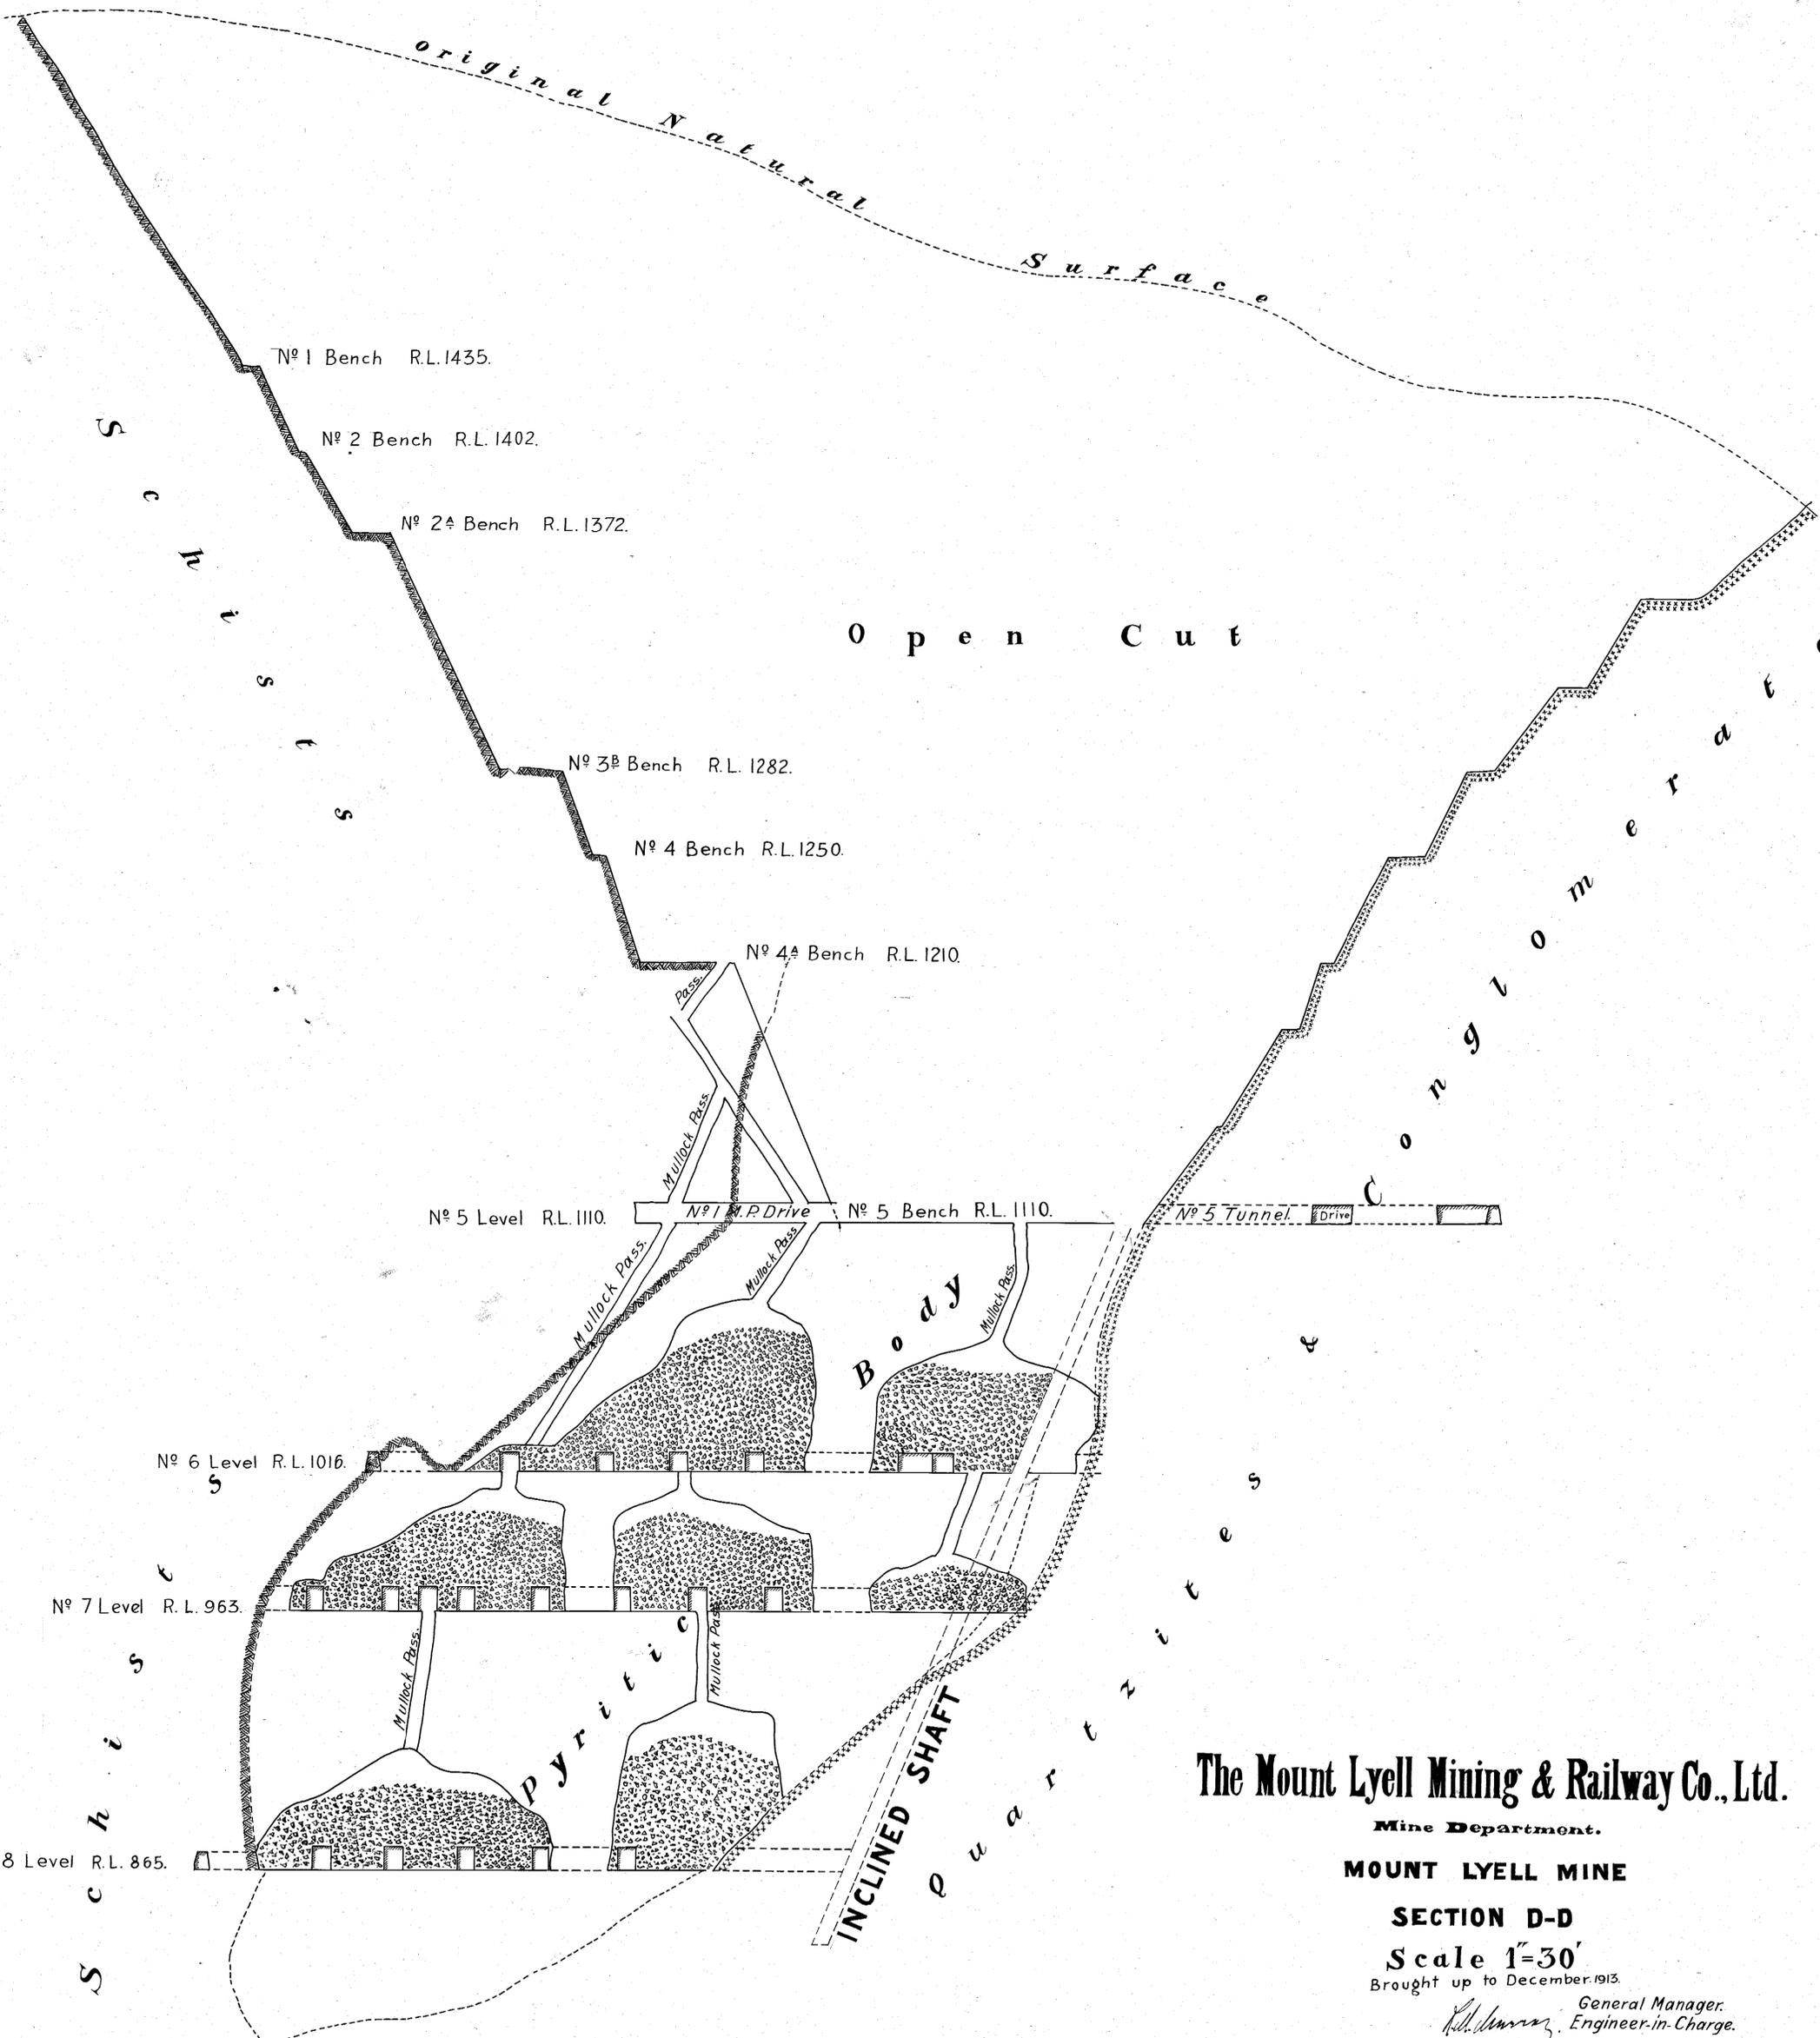

The Mount Lyell Mining & Railway Co., Ltd.

Mine Department.

MOUNT LYELL MINE

SECTION D-D

Scale 1"=30'

Brought up to December, 1913.

*R. H. Murray* General Manager.  
Engineer-in-Charge.