


218-126

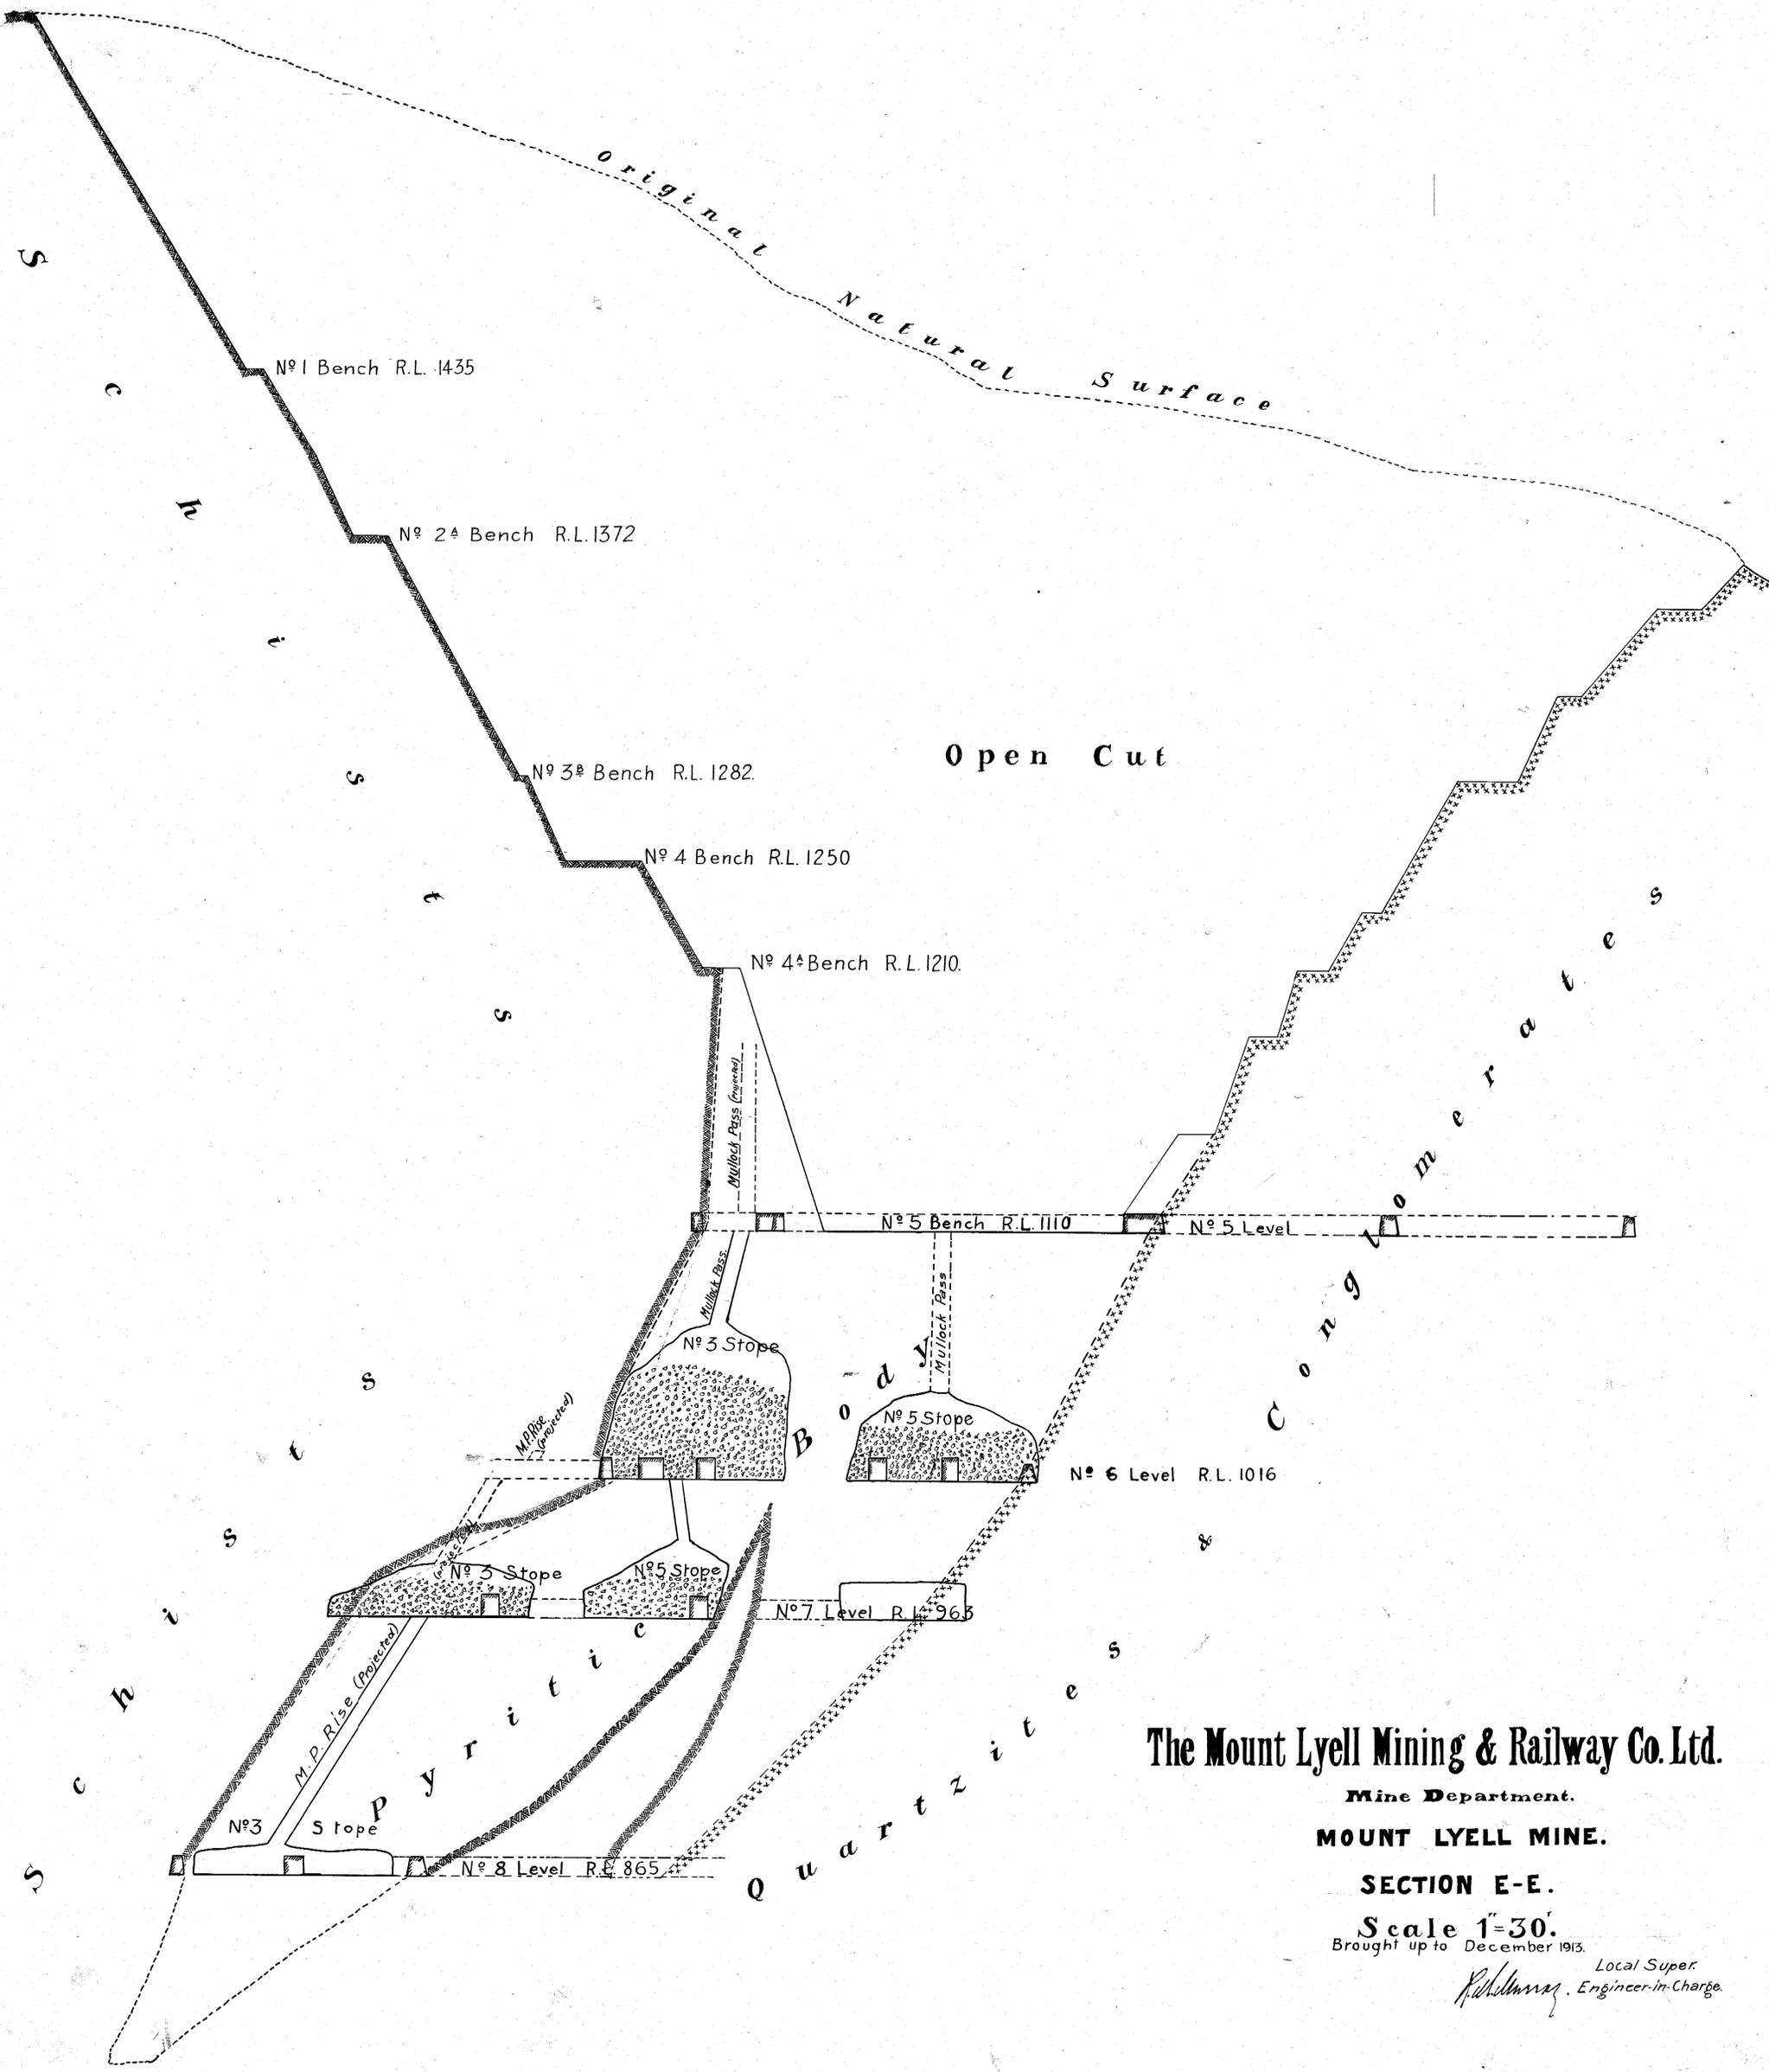

218-126

5 cm

The Mount Lyell Mining & Railway Co. Ltd.

Mine Department.
MOUNT LYELL MINE.

SECTION E-E.

Scale 1"=30'.
Brought up to December 1913.

R. Schumann Local Super.
Engineer-in-Charge.