



218-127



600' LEVEL.

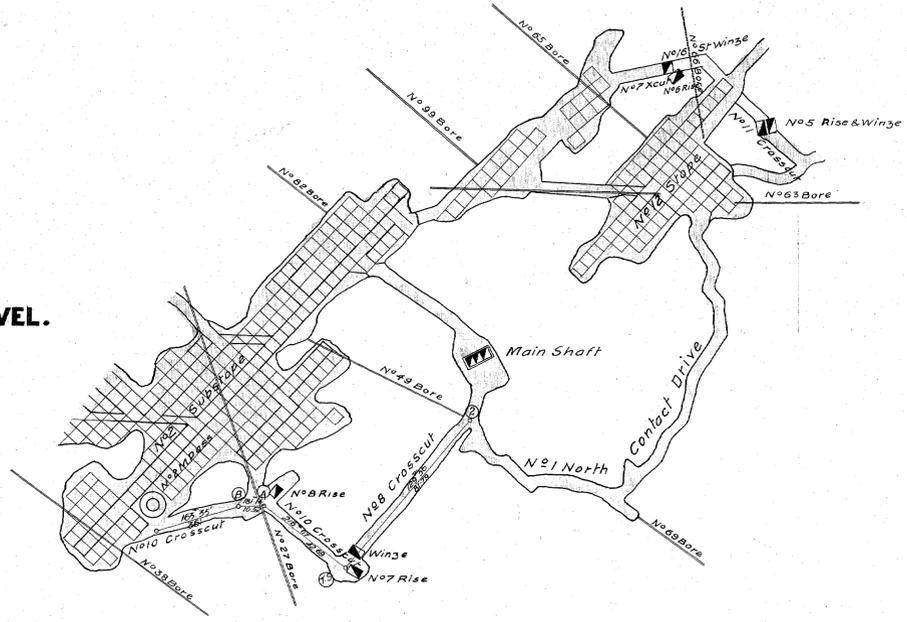

300' LEVEL.

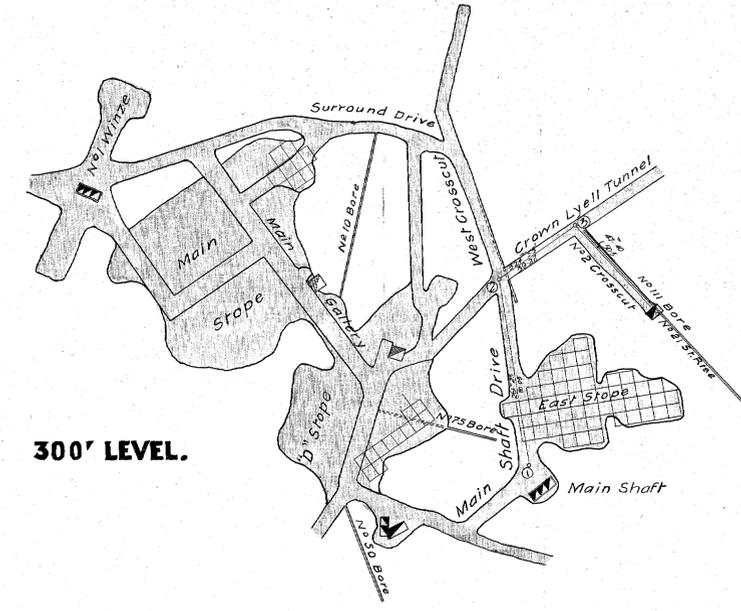


500' LEVEL.

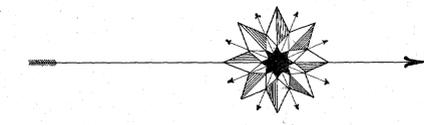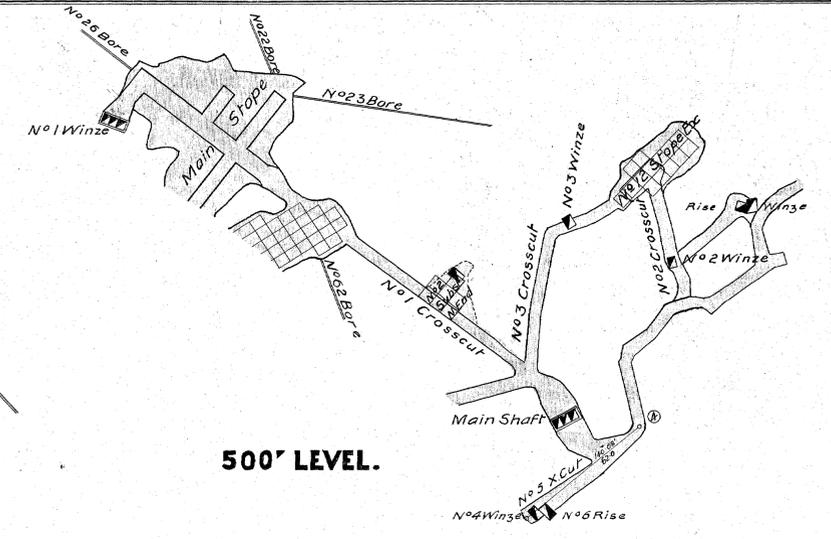

218-127



700' LEVEL.

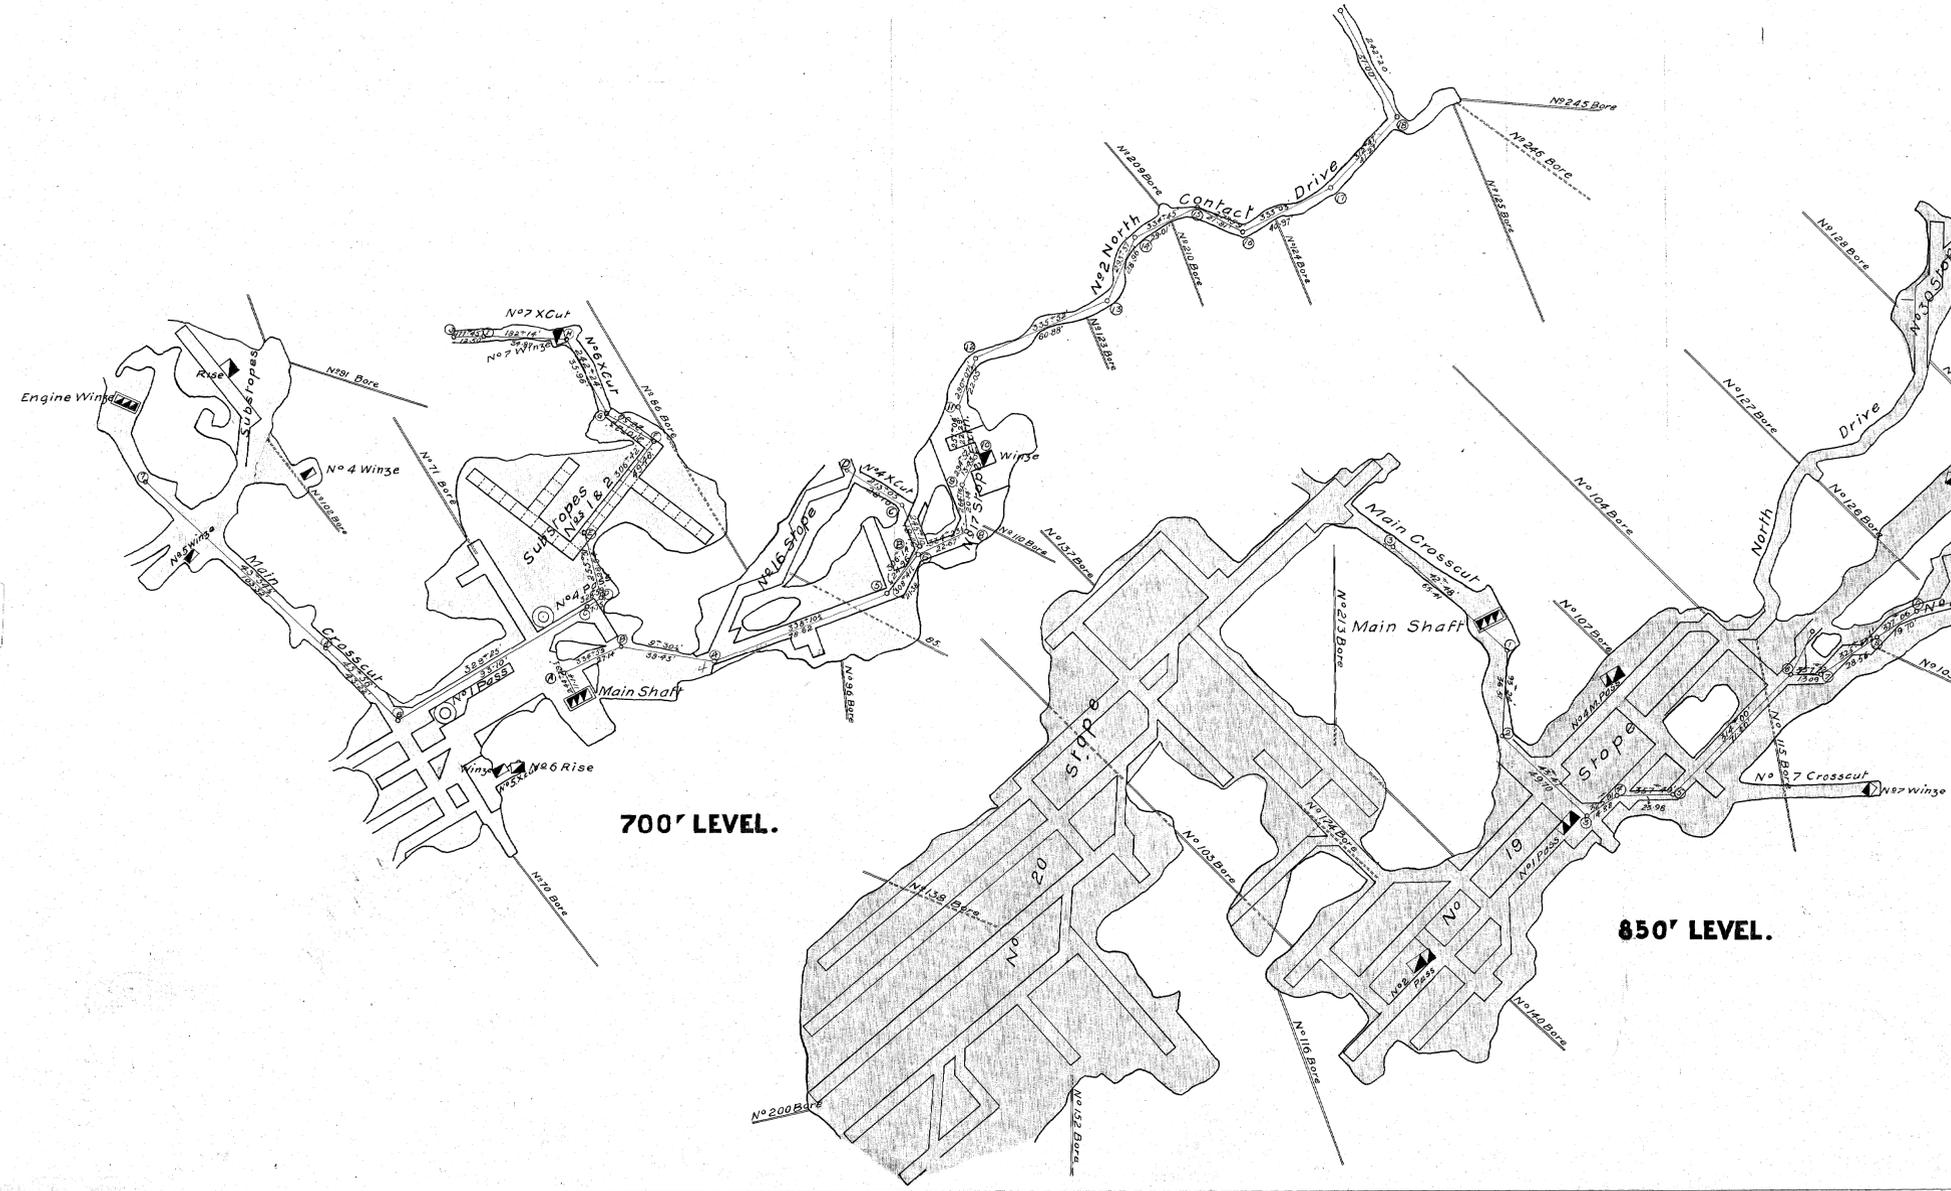

850' LEVEL.

The Mount Lyell Mining & Railway Co., Ltd.

Mine Department.

DETAIL PLAN UNDERGROUND WORKINGS

NORTH LYELL MINE.

Brought up to December 31<sup>st</sup> 1913.

Scale 1 INCH = 30 FEET.

Local Super<sup>dt</sup>  
*R. H. Maxwell* Engineer-in-Charge

183.14