


218-128

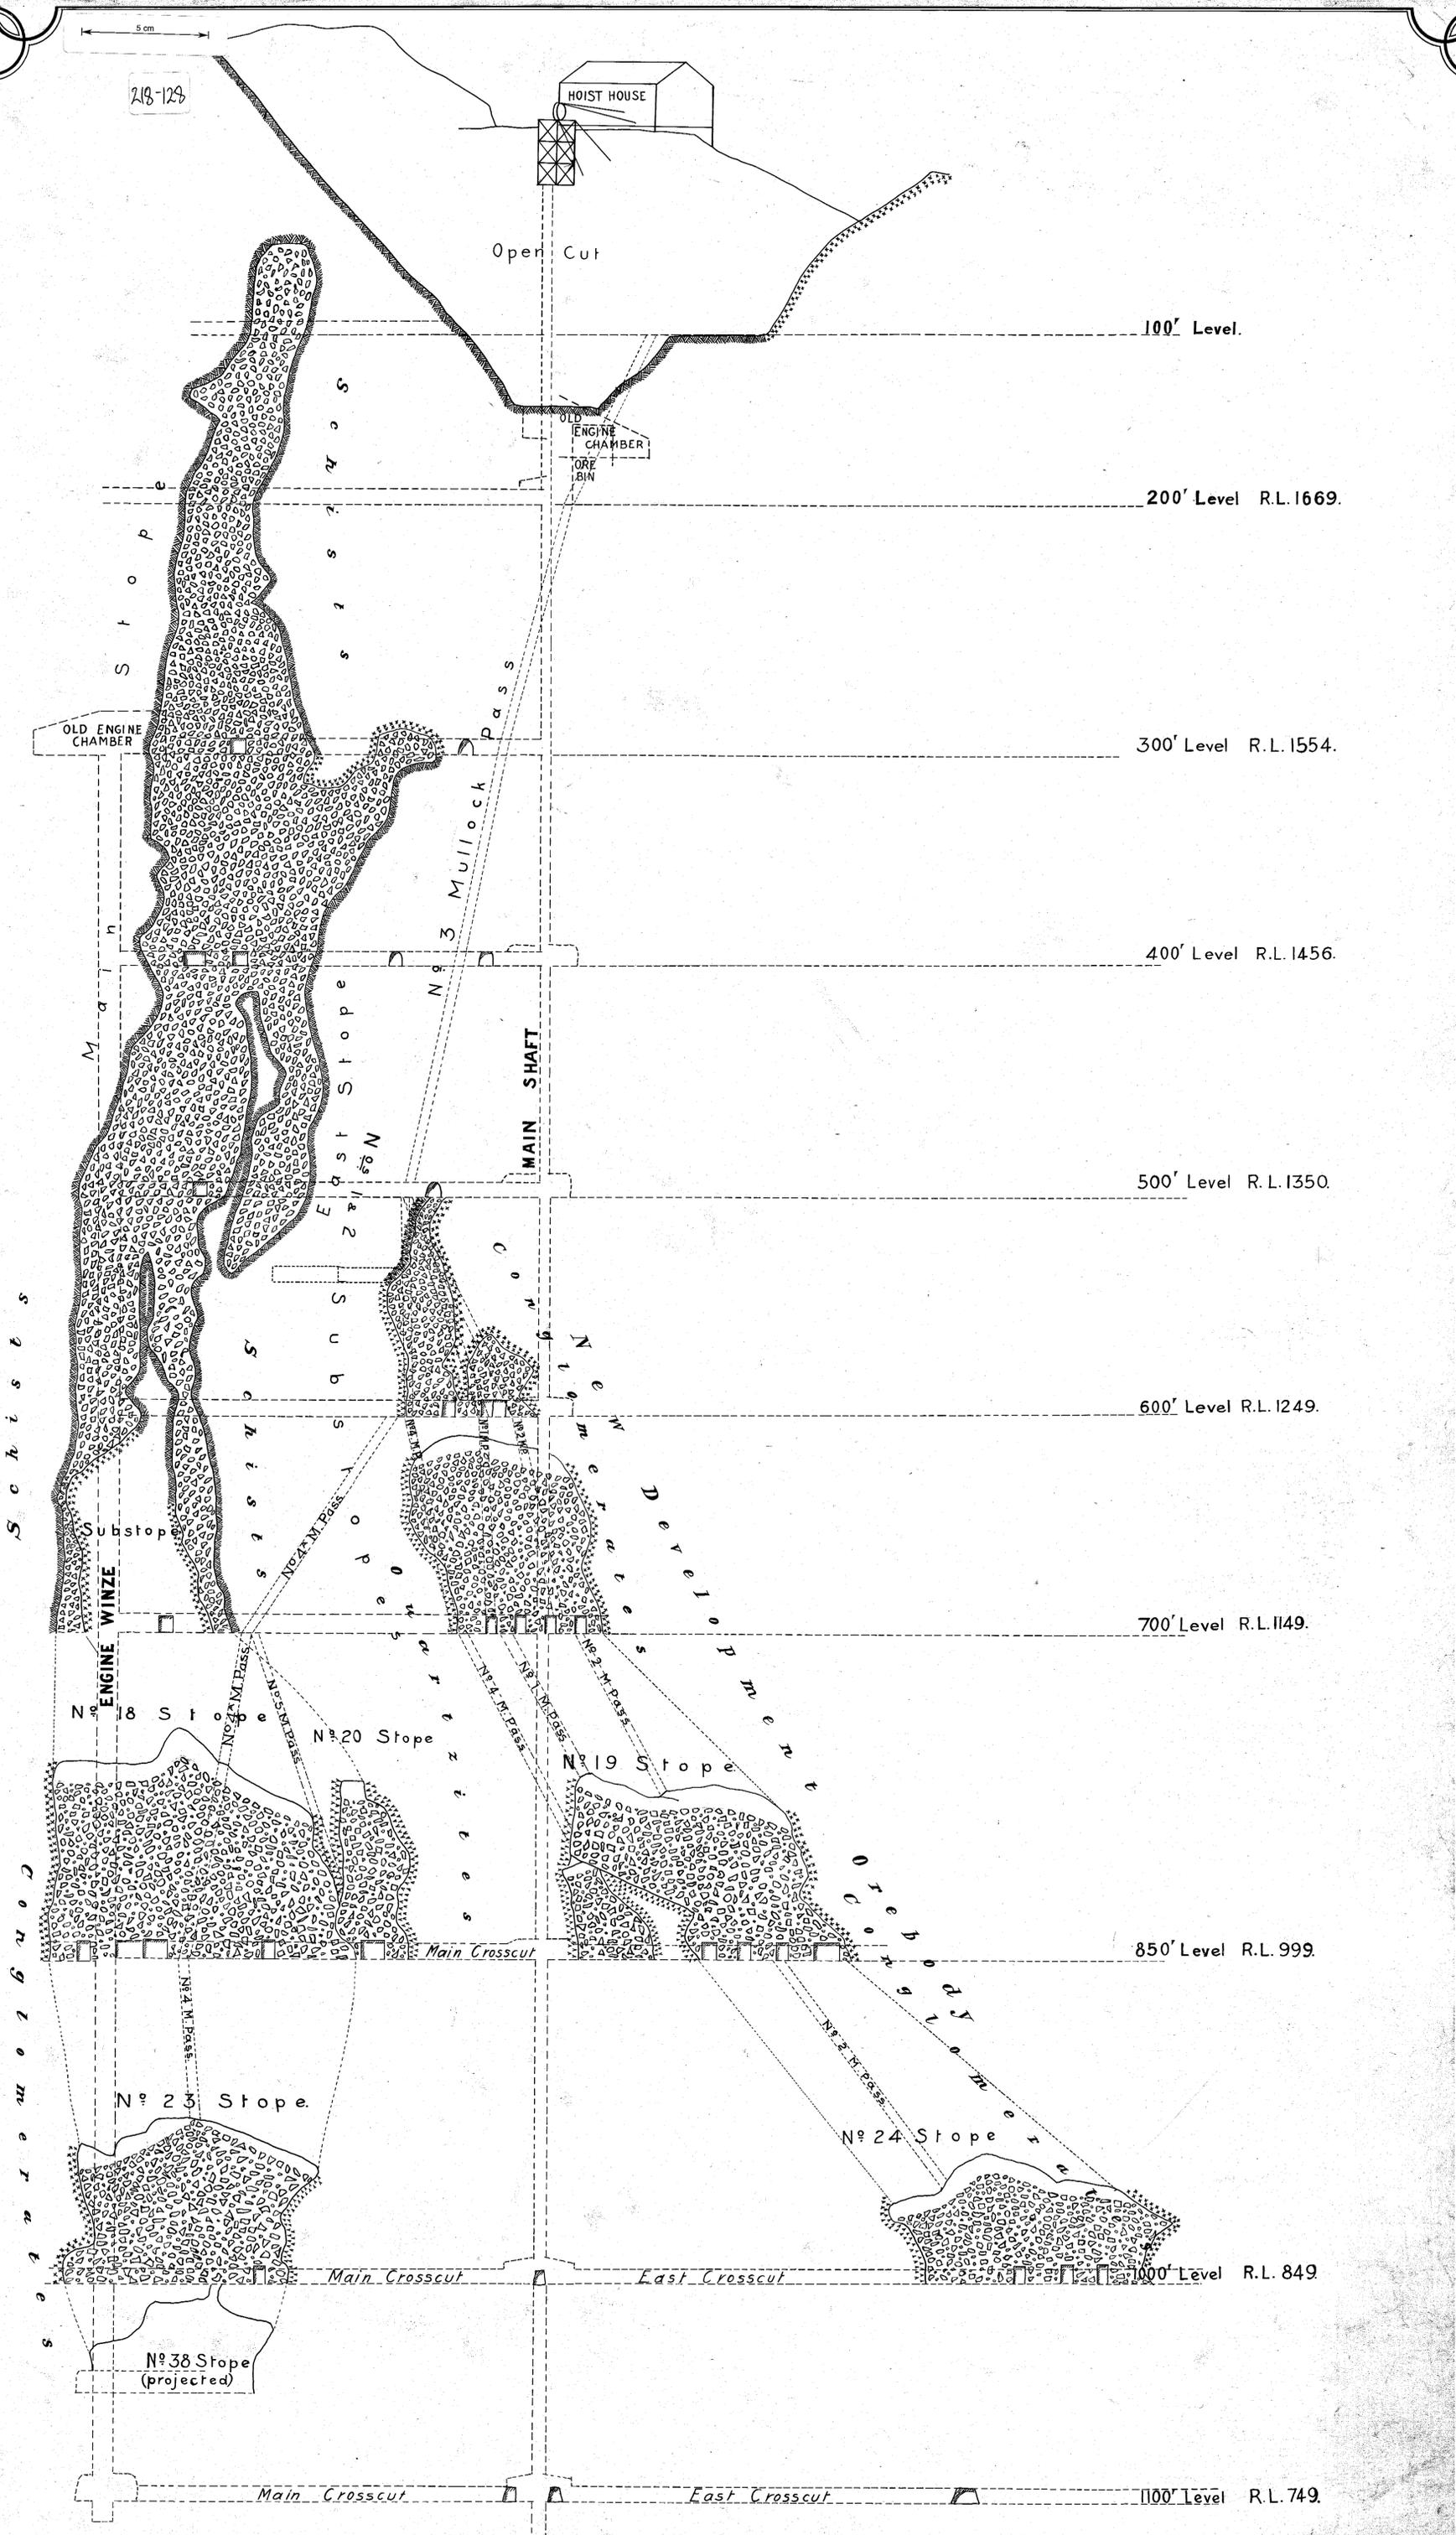

**The Mount Lyell Mining & Railway Co. Ltd.**

Mine Department.

**NORTH LYELL MINE.**

Section on Line BB looking North.

Brought up to Dec. 31<sup>st</sup> 1913.

Scale 1" = 30'

Local Super.  
Eng. in Charge *[Signature]*