



No. 4 LEVEL.

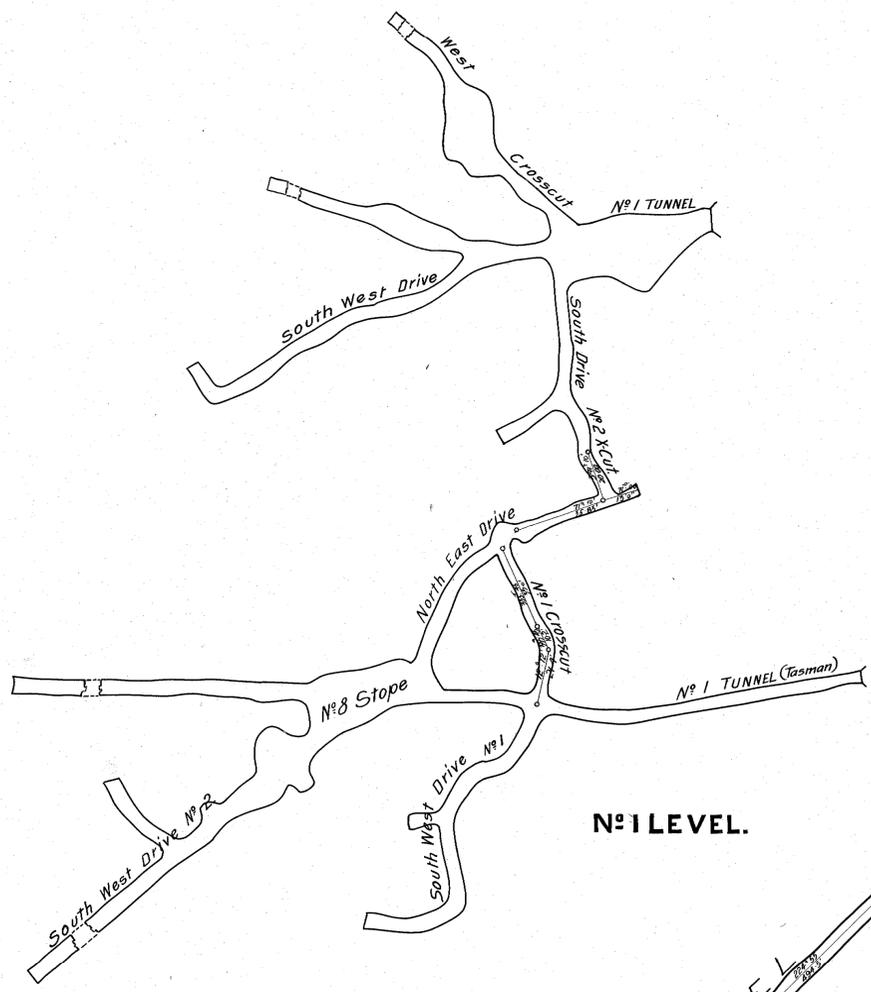

No. 1 LEVEL.

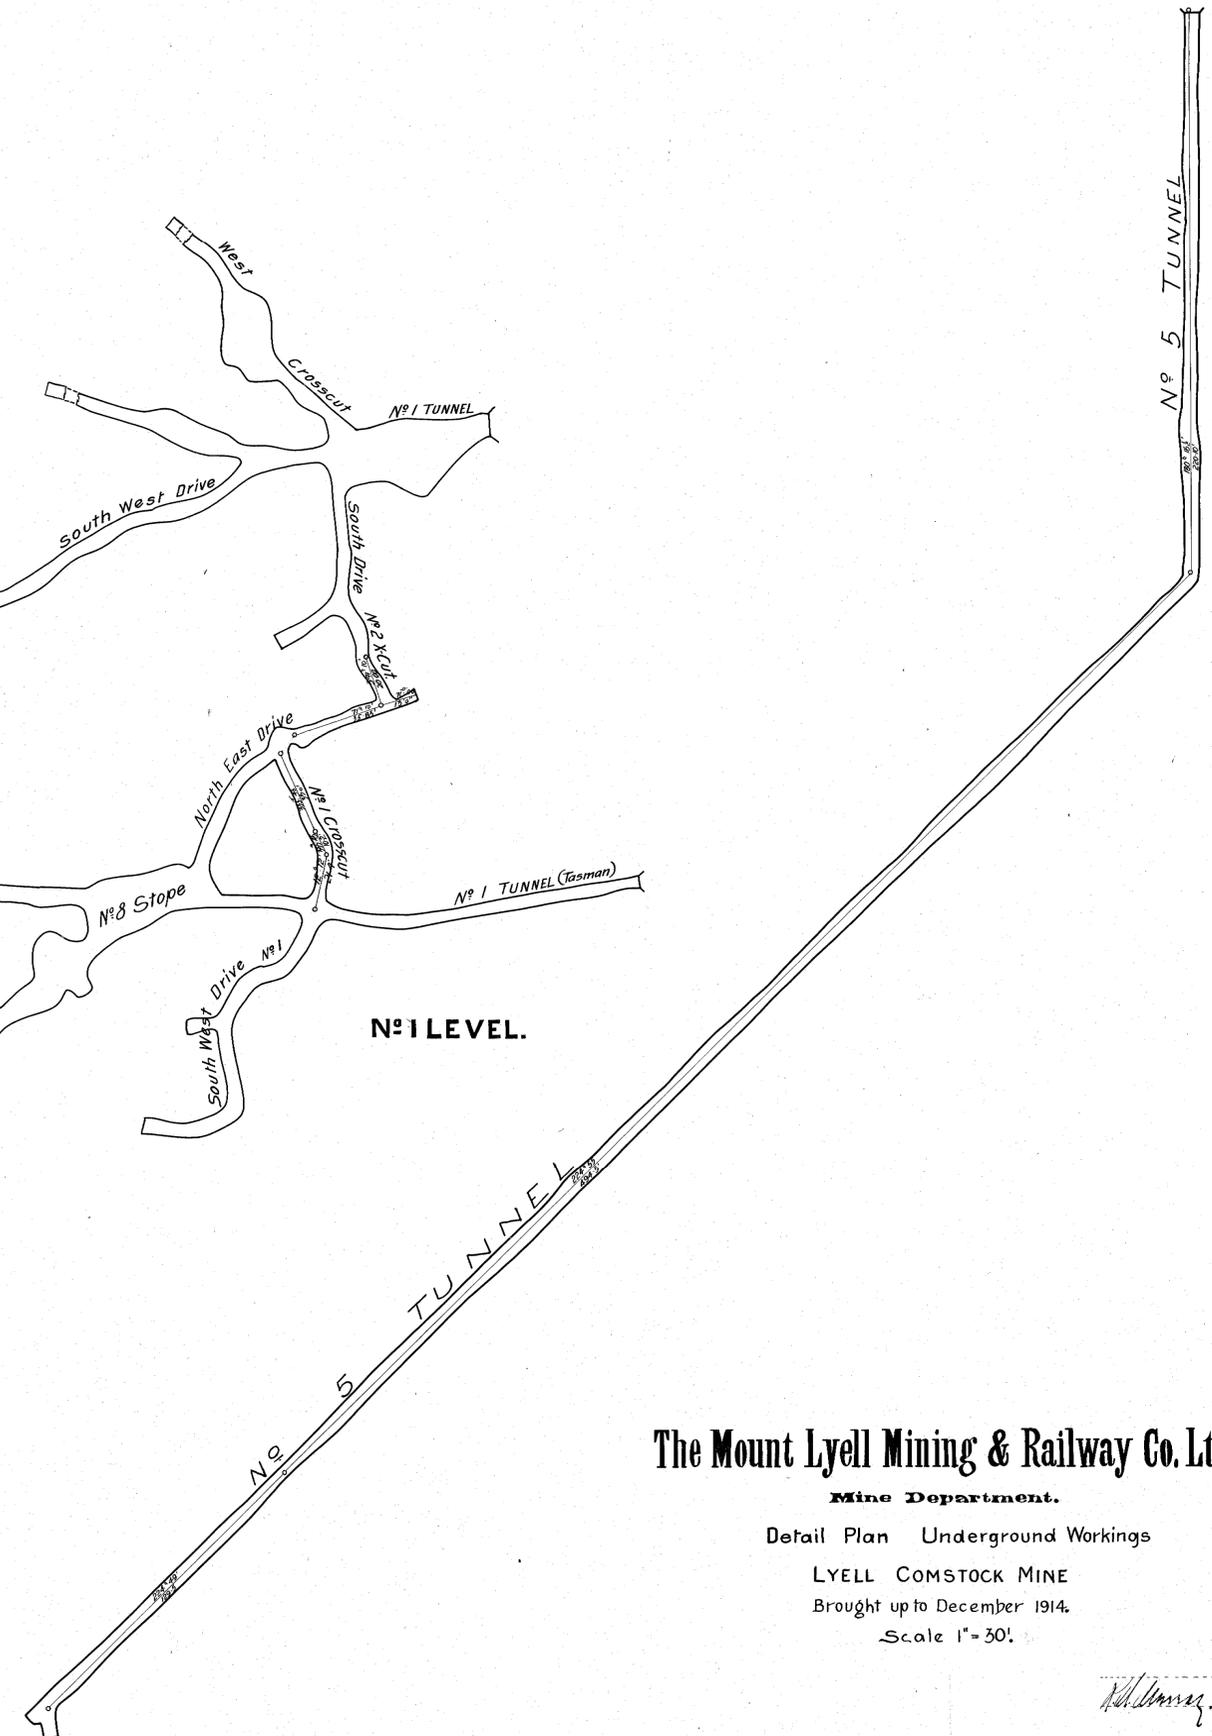

5  
100  
218-129

**The Mount Lyell Mining & Railway Co. Ltd.**

Mine Department.  
 Detail Plan Underground Workings  
 LYELL COMSTOCK MINE  
 Brought up to December 1914.  
 Scale 1" = 30'

General Manager  
*[Signature]*  
 Engineer-in-Chief

218-129