


218-13

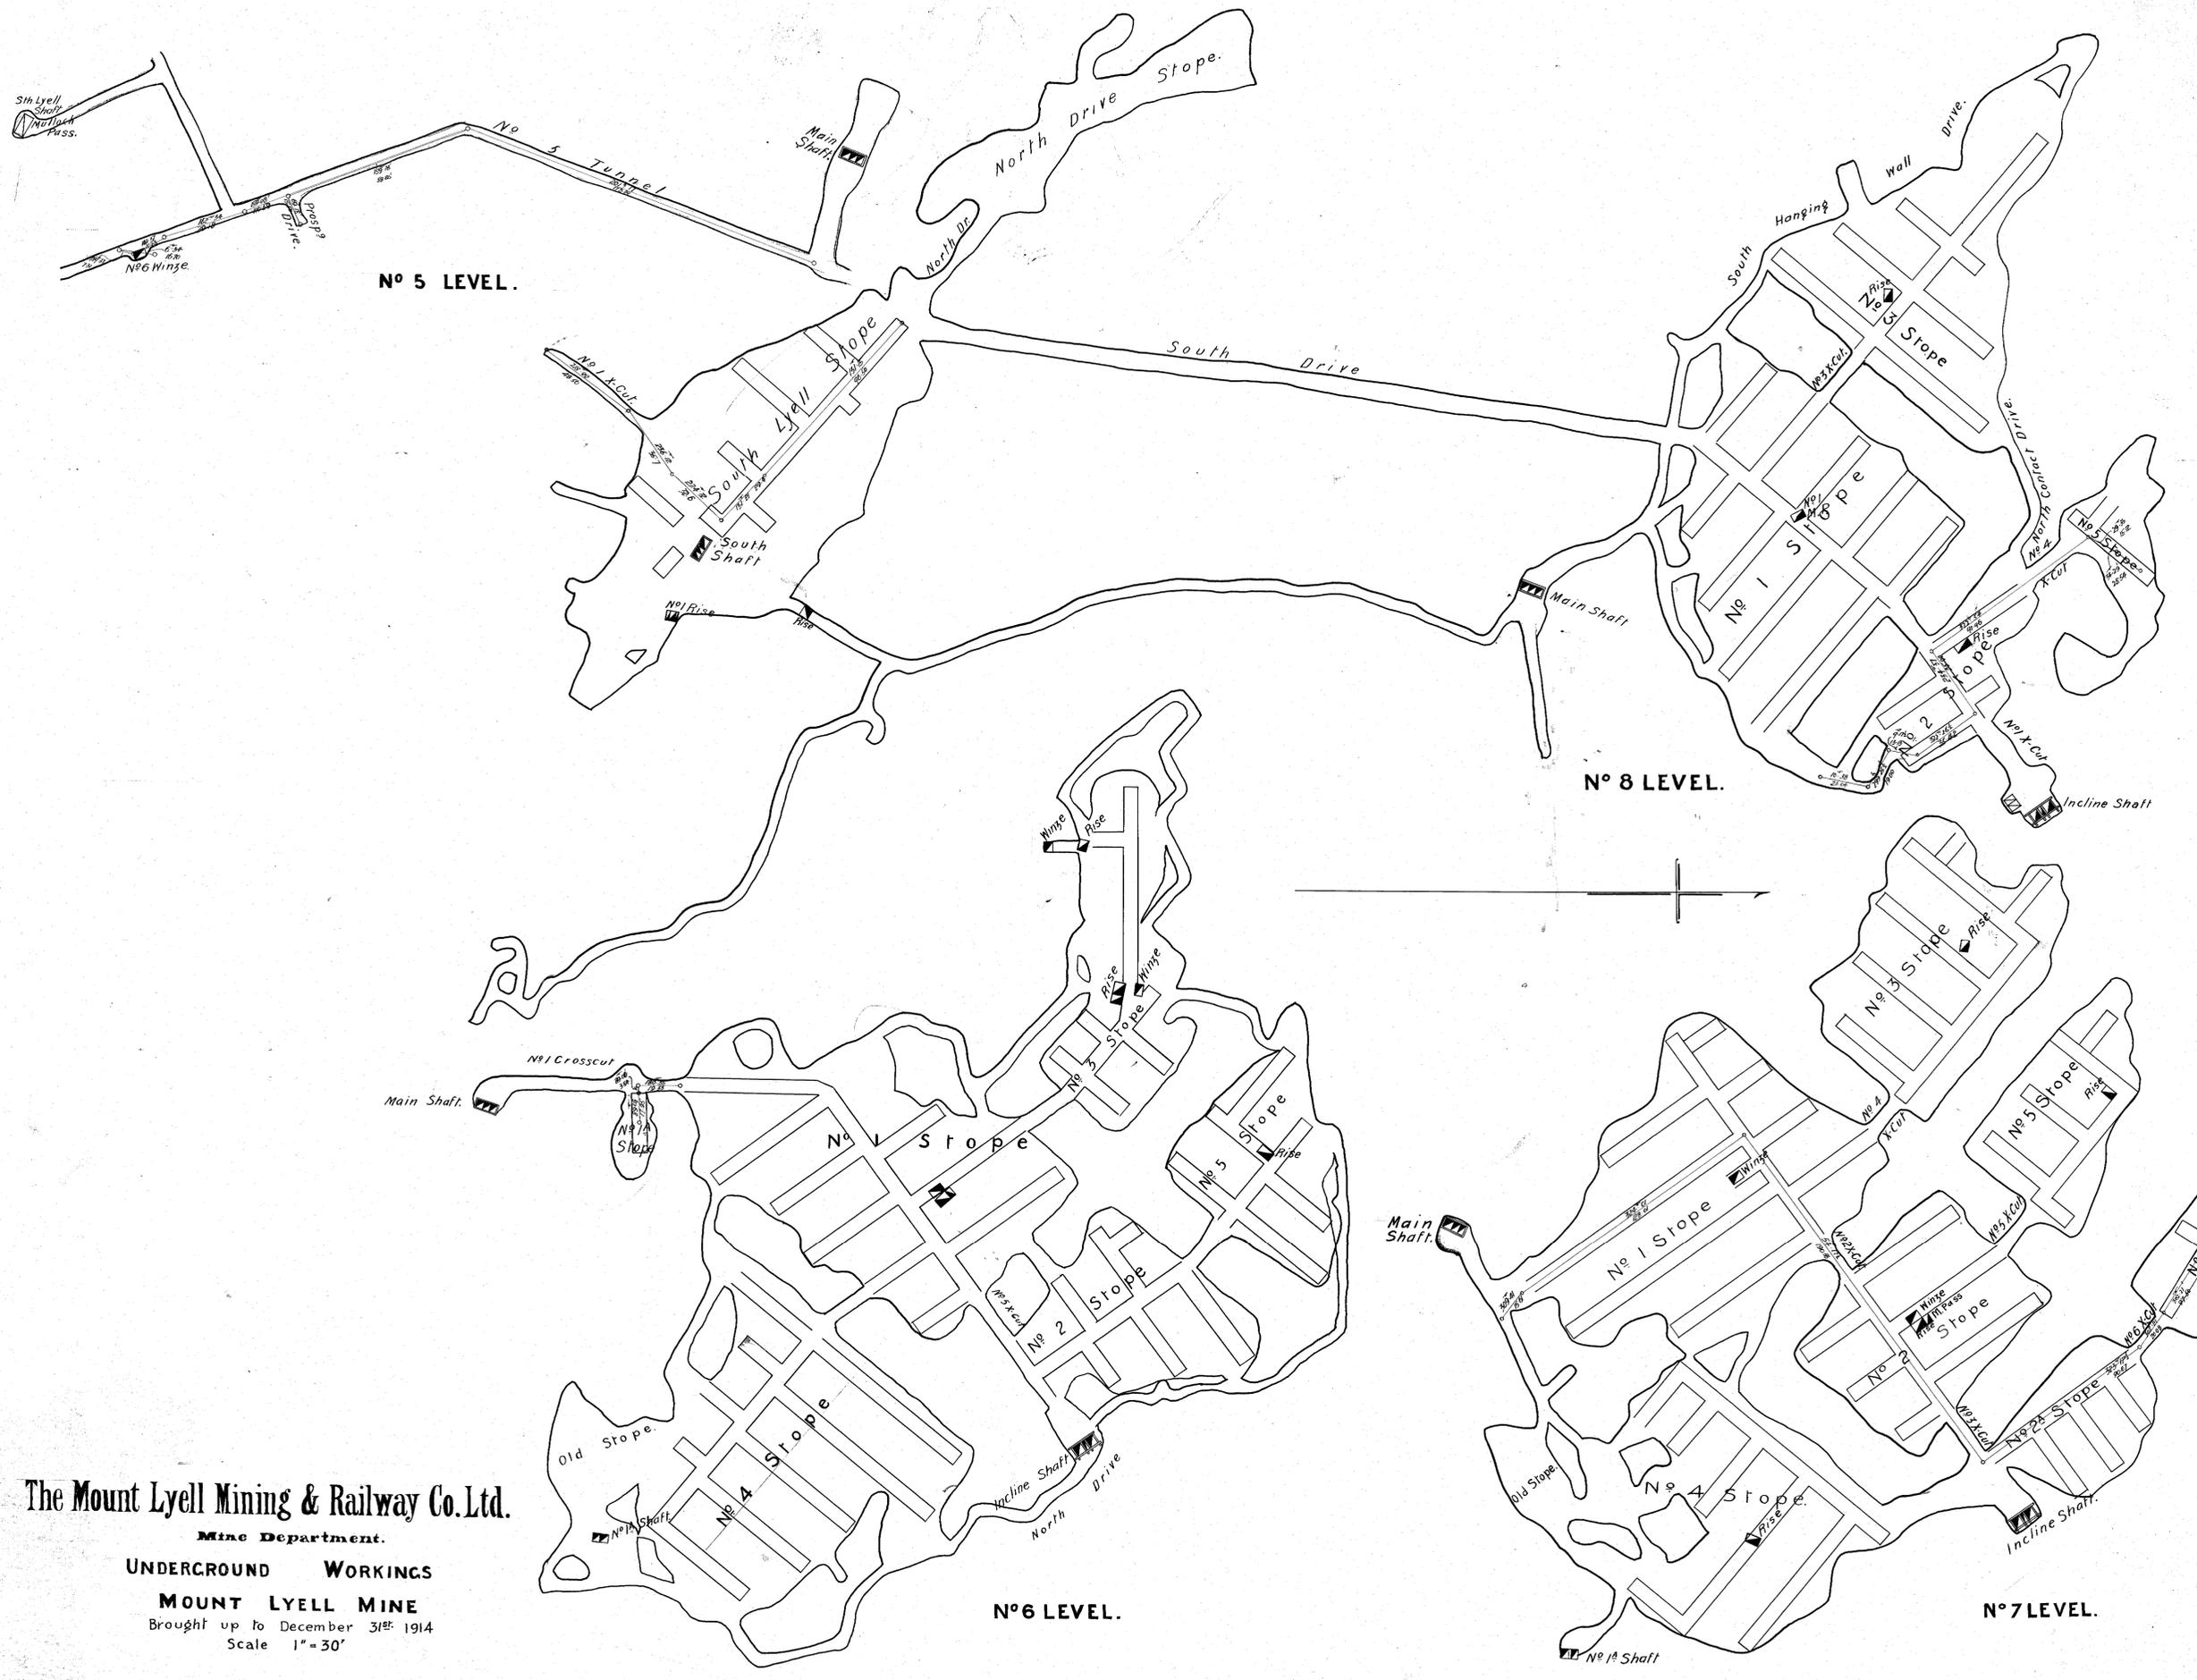

No 5 LEVEL.

No 8 LEVEL.

No 6 LEVEL.

No 7 LEVEL.

The Mount Lyell Mining & Railway Co. Ltd.

Mine Department.
UNDERGROUND WORKINGS

MOUNT LYELL MINE
Brought up to December 31st 1914
Scale 1" = 30'

General Manager:
A. W. Murray, Engineer-in-Charge.

218-13

