


28-135

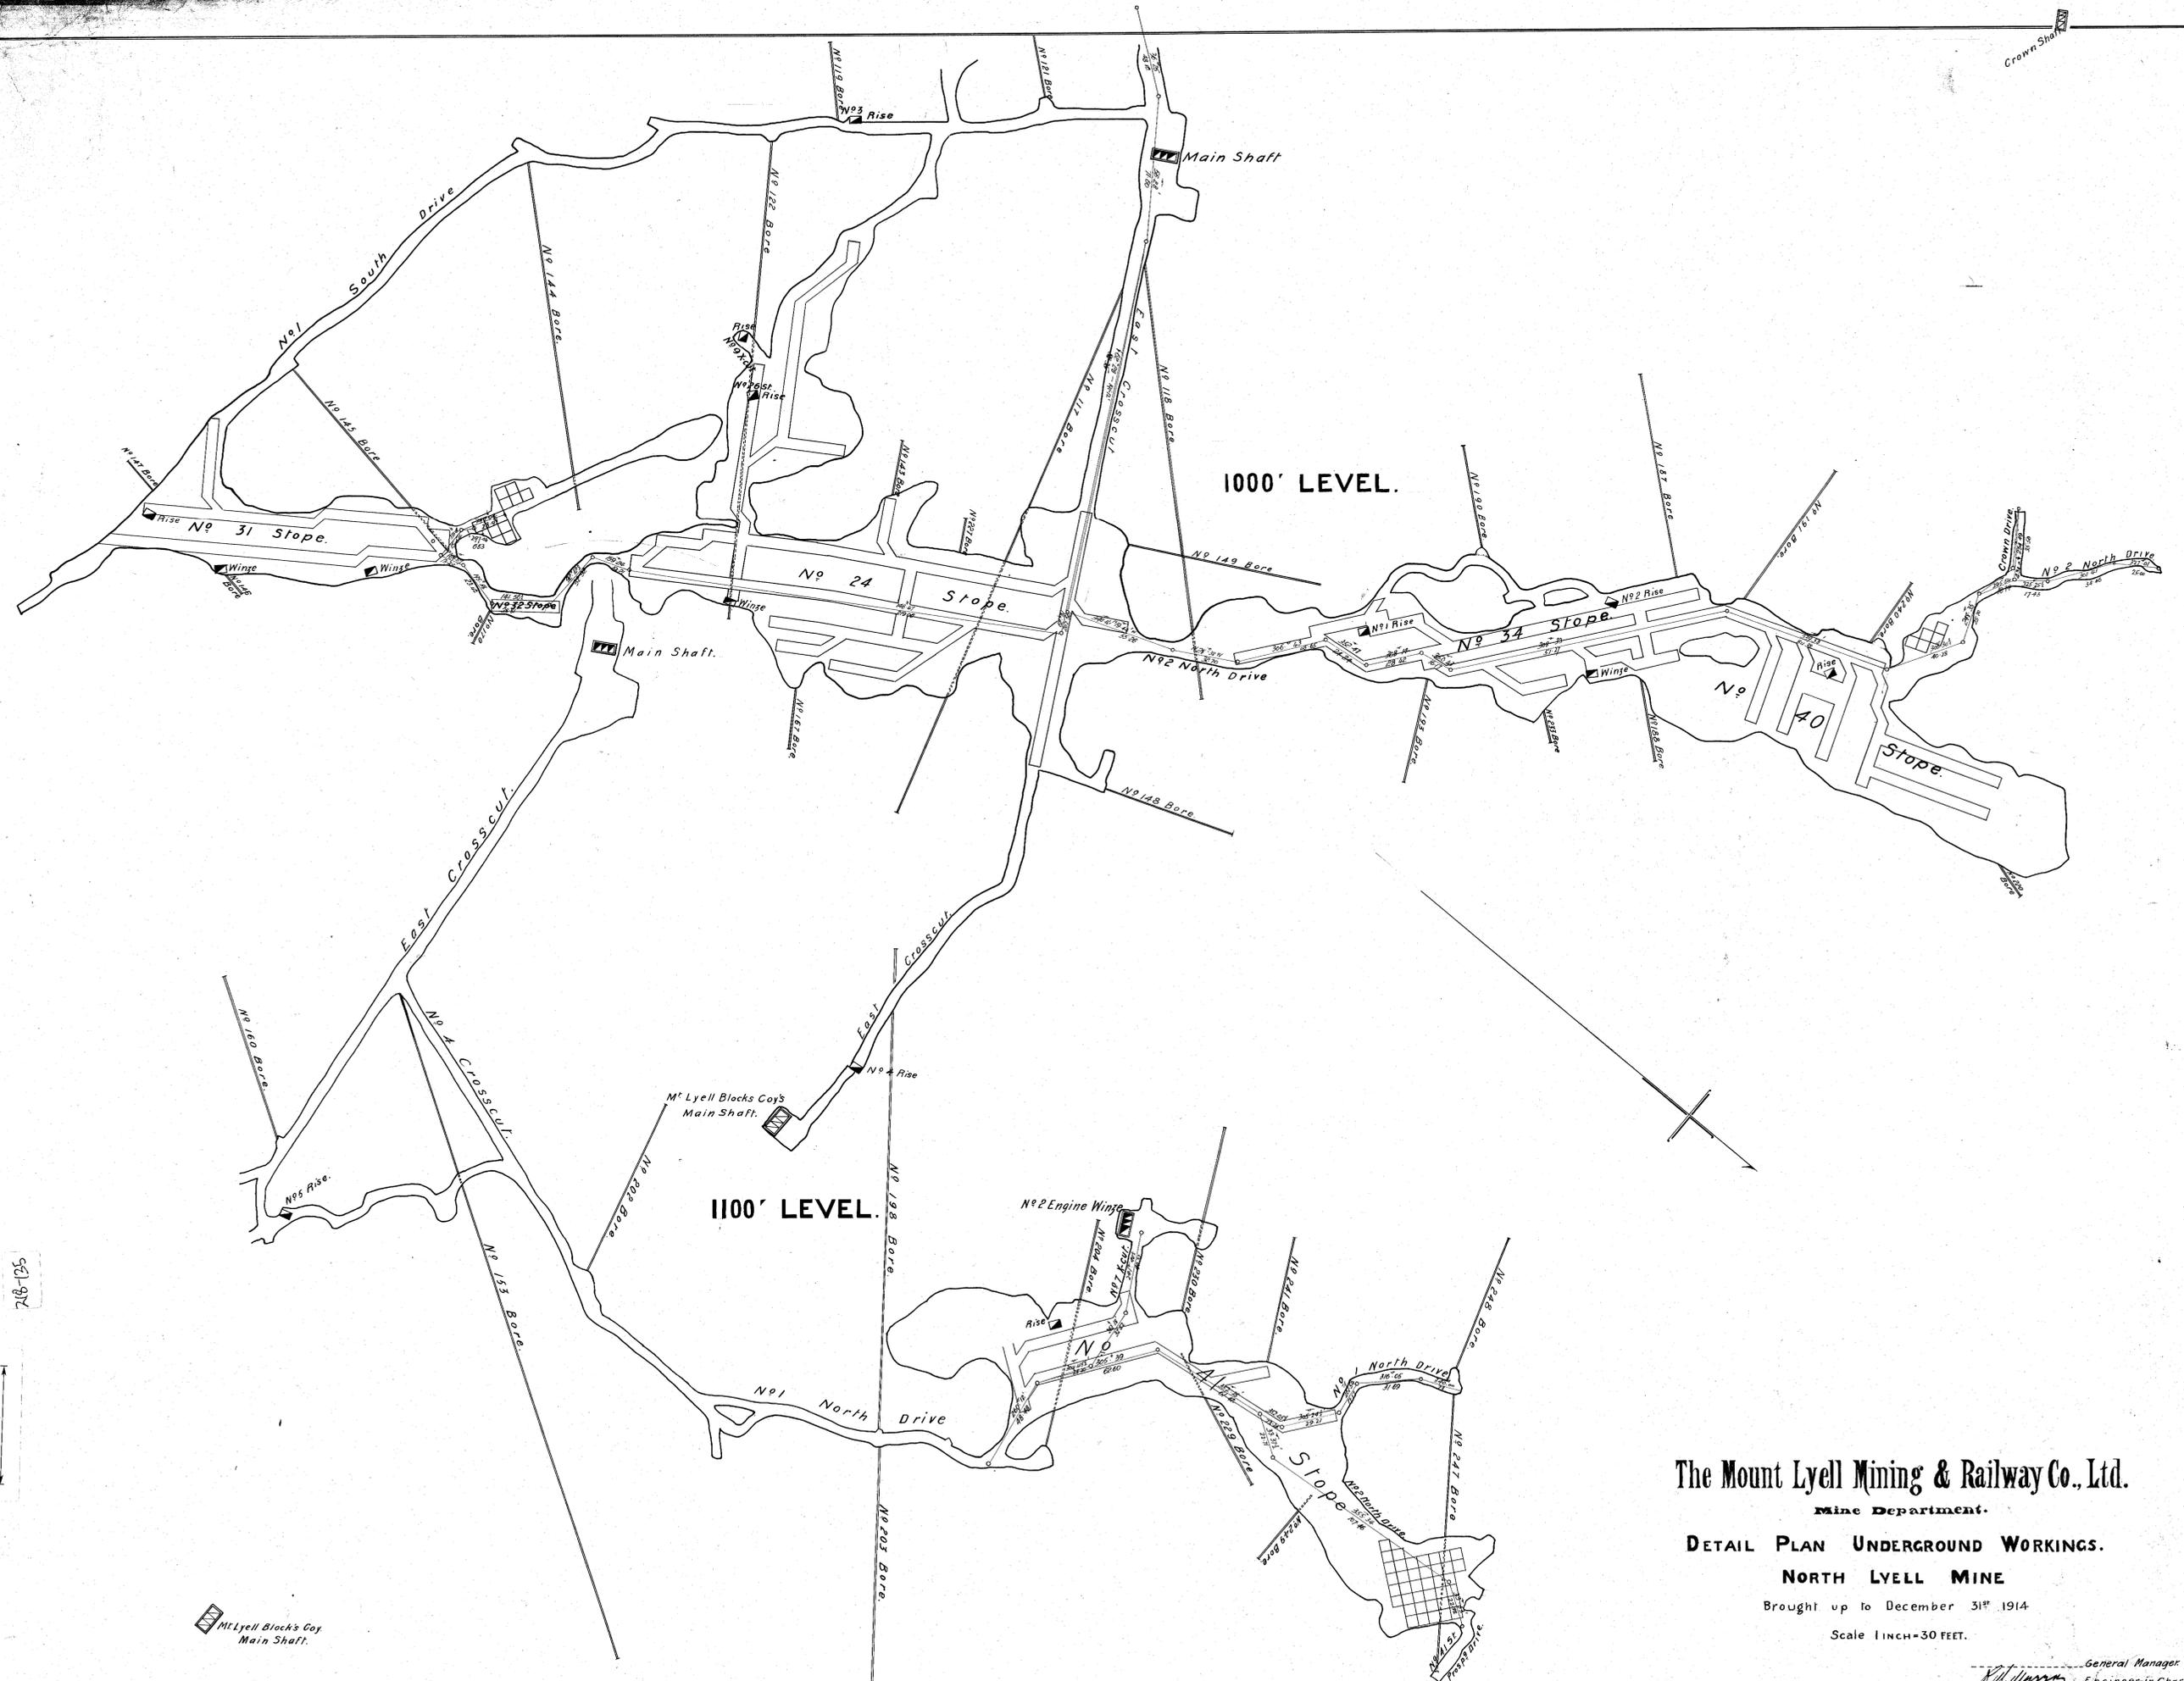

28-135

The Mount Lyell Mining & Railway Co., Ltd.

Mine Department.

DETAIL PLAN UNDERGROUND WORKINGS.

NORTH LYELL MINE

Brought up to December 31st 1914

Scale 1 inch = 30 FEET.

M. Lyell Bloch Coy.
Main Shaft.

General Manager
Engineer-in-Charge