


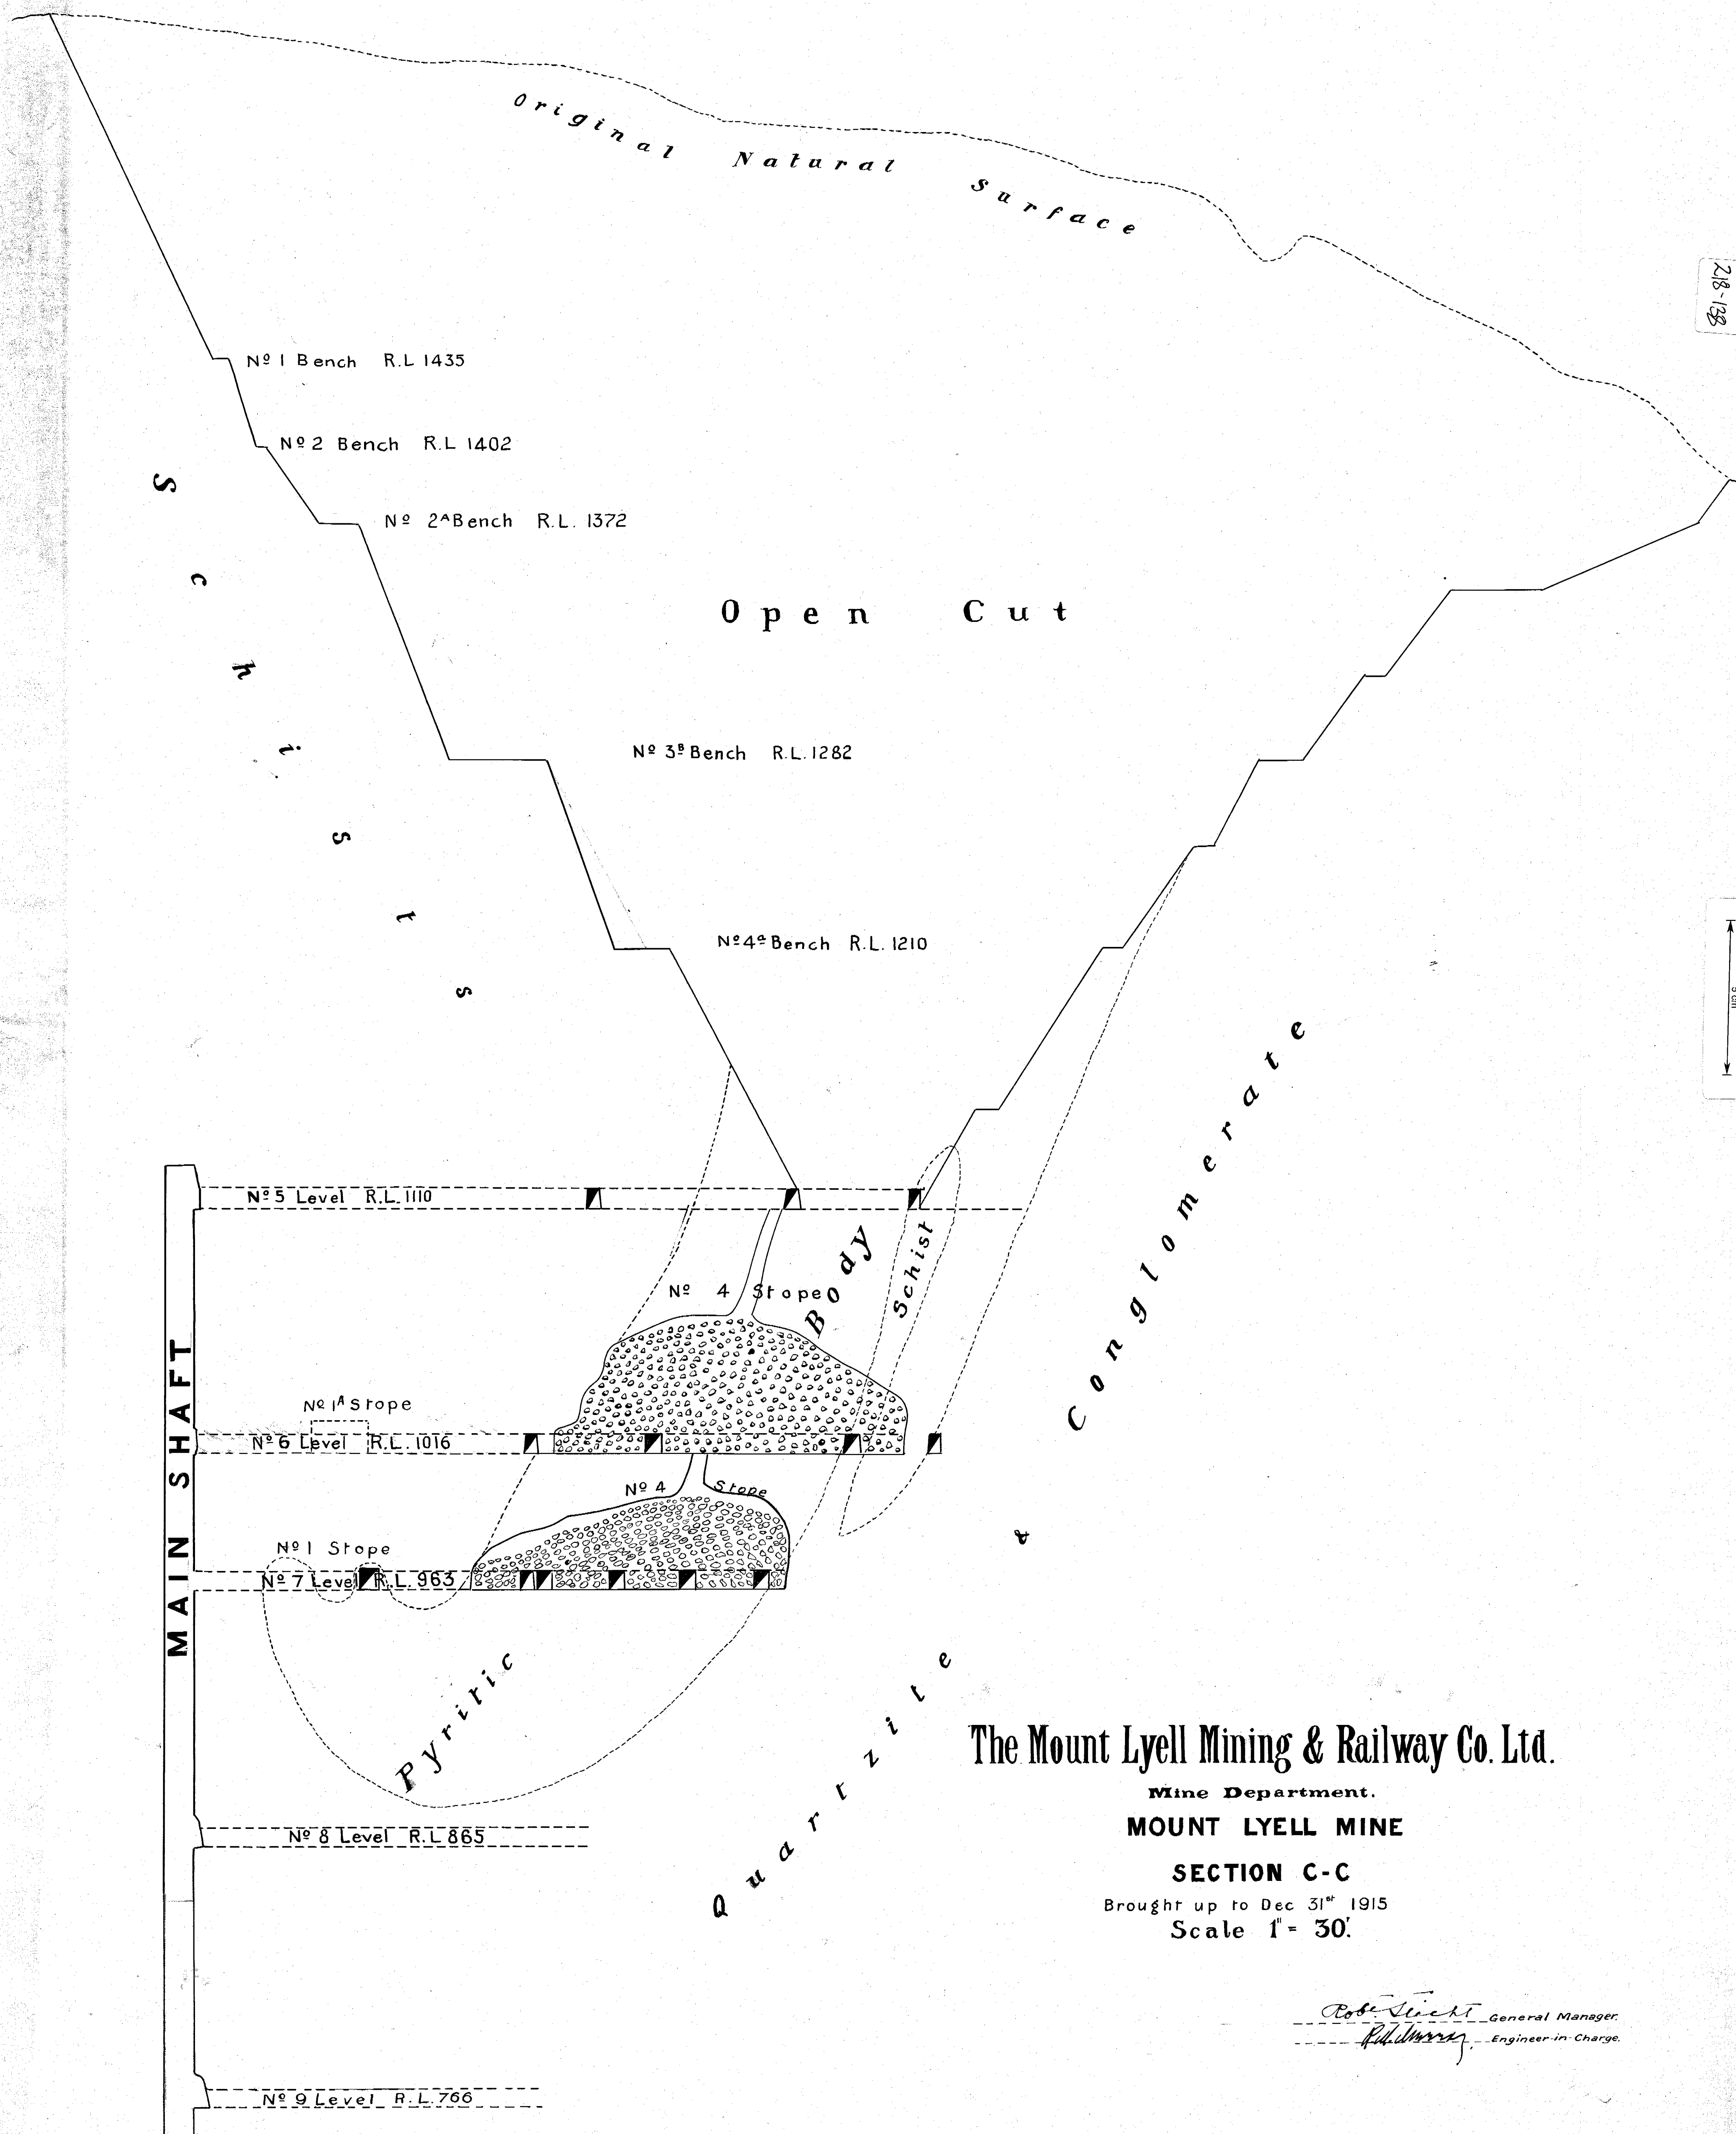

The Mount Lyell Mining & Railway Co. Ltd.

Mine Department.

MOUNT LYELL MINE

SECTION C-C

Brought up to Dec 31st 1915

Scale 1" = 30'

Robt. Smith General Manager.
Edw. W. W. W. Engineer in Charge.