





215-140

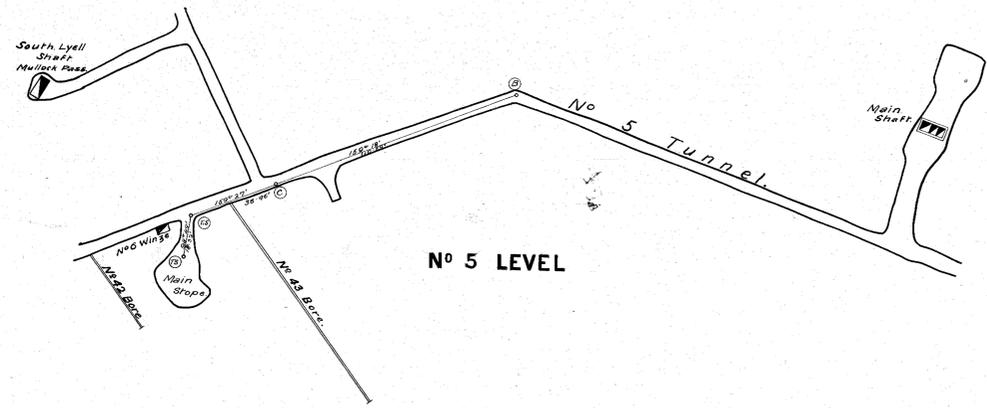

No 5 LEVEL

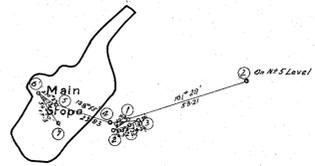

No 6 LEVEL

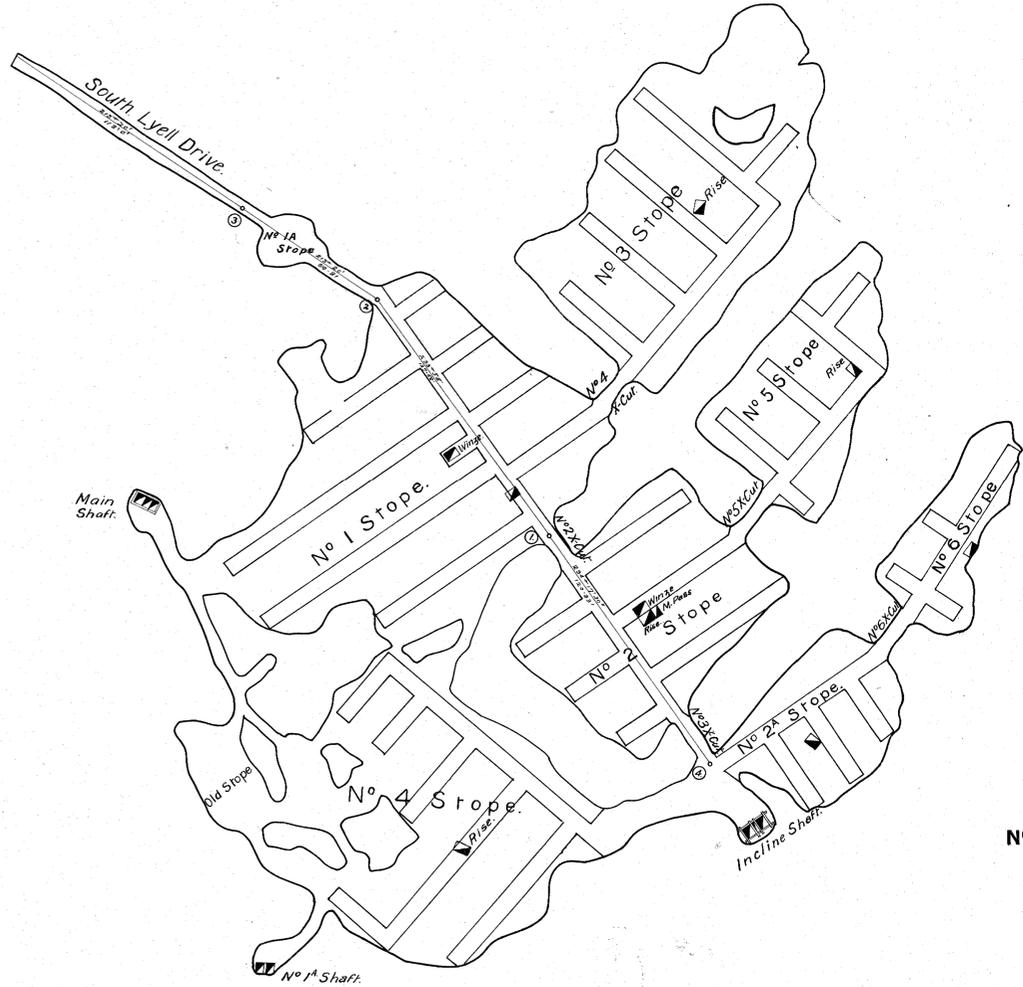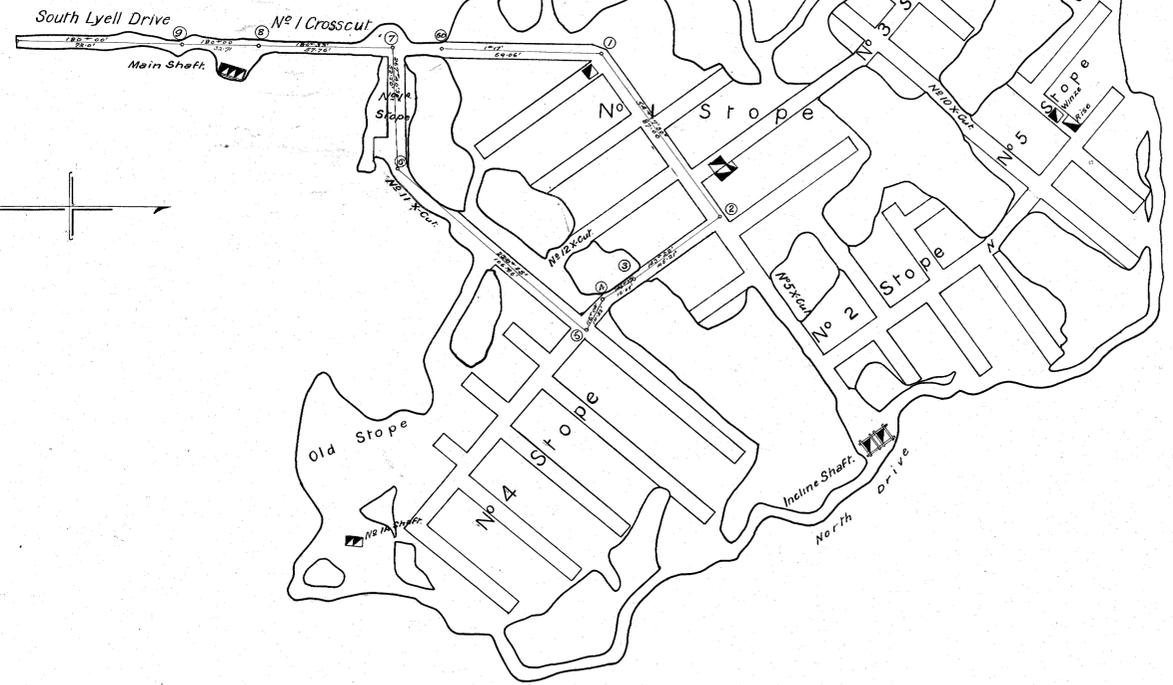

No 7 LEVEL

The Mount Lyell Mining & Railway Co Ltd

Mine Department.

MOUNT LYELL MINE.

UNDERGROUND WORKINGS 1915

SCALE: 1 INCH = 30 FEET.

Robert Street General Manager.

W. J. Murray Engineer-in-Charge.



215-140