



218-111


600' Level R.L. 1249

700' Level R.L. 1149

850' Level R.L. 999

1000' Level R.L. 849.

1100' Level R.L. 749.

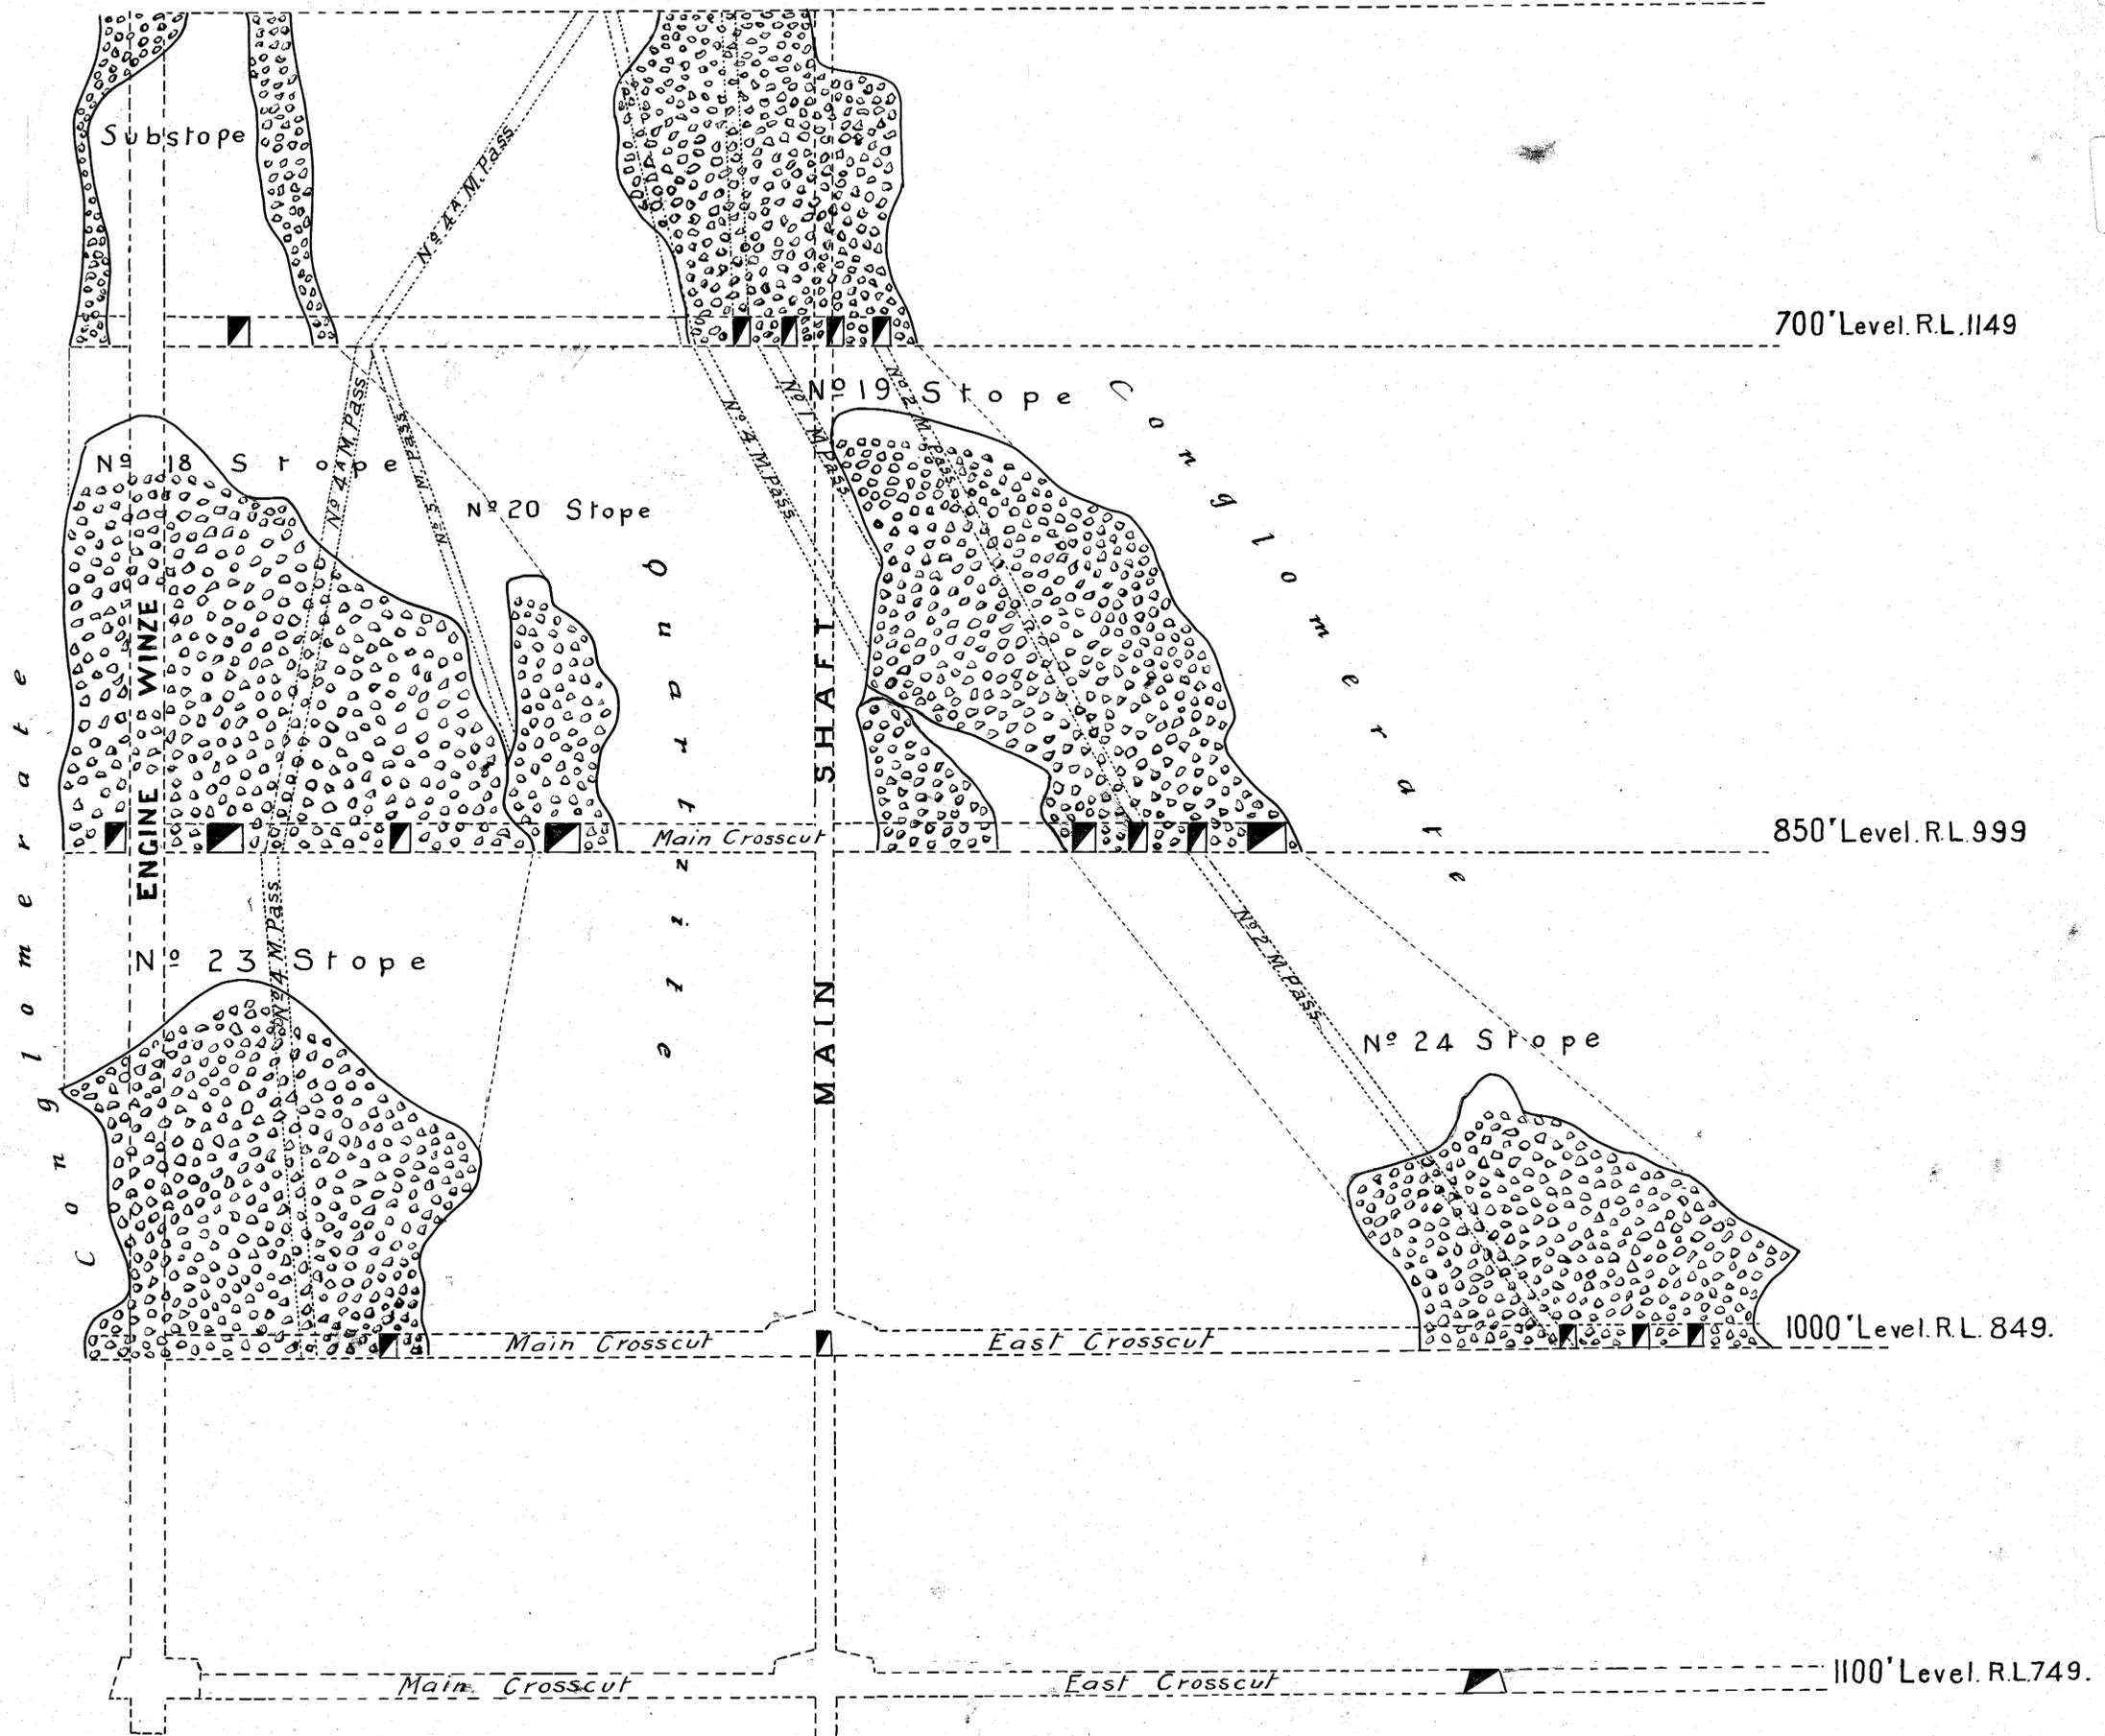

The Mount Lyell Mining & Railway Co Ltd

Mine Department.

NORTH LYELL MINE. Section on Line BB looking North.

Brought up to Dec. 31st 1915

Scale 1" = 30'

Robert Lyell General Manager.
Robert Lyell Engineer-in-Charge

218-111