



175
K
11/10/14
M

8
100
10

218-143

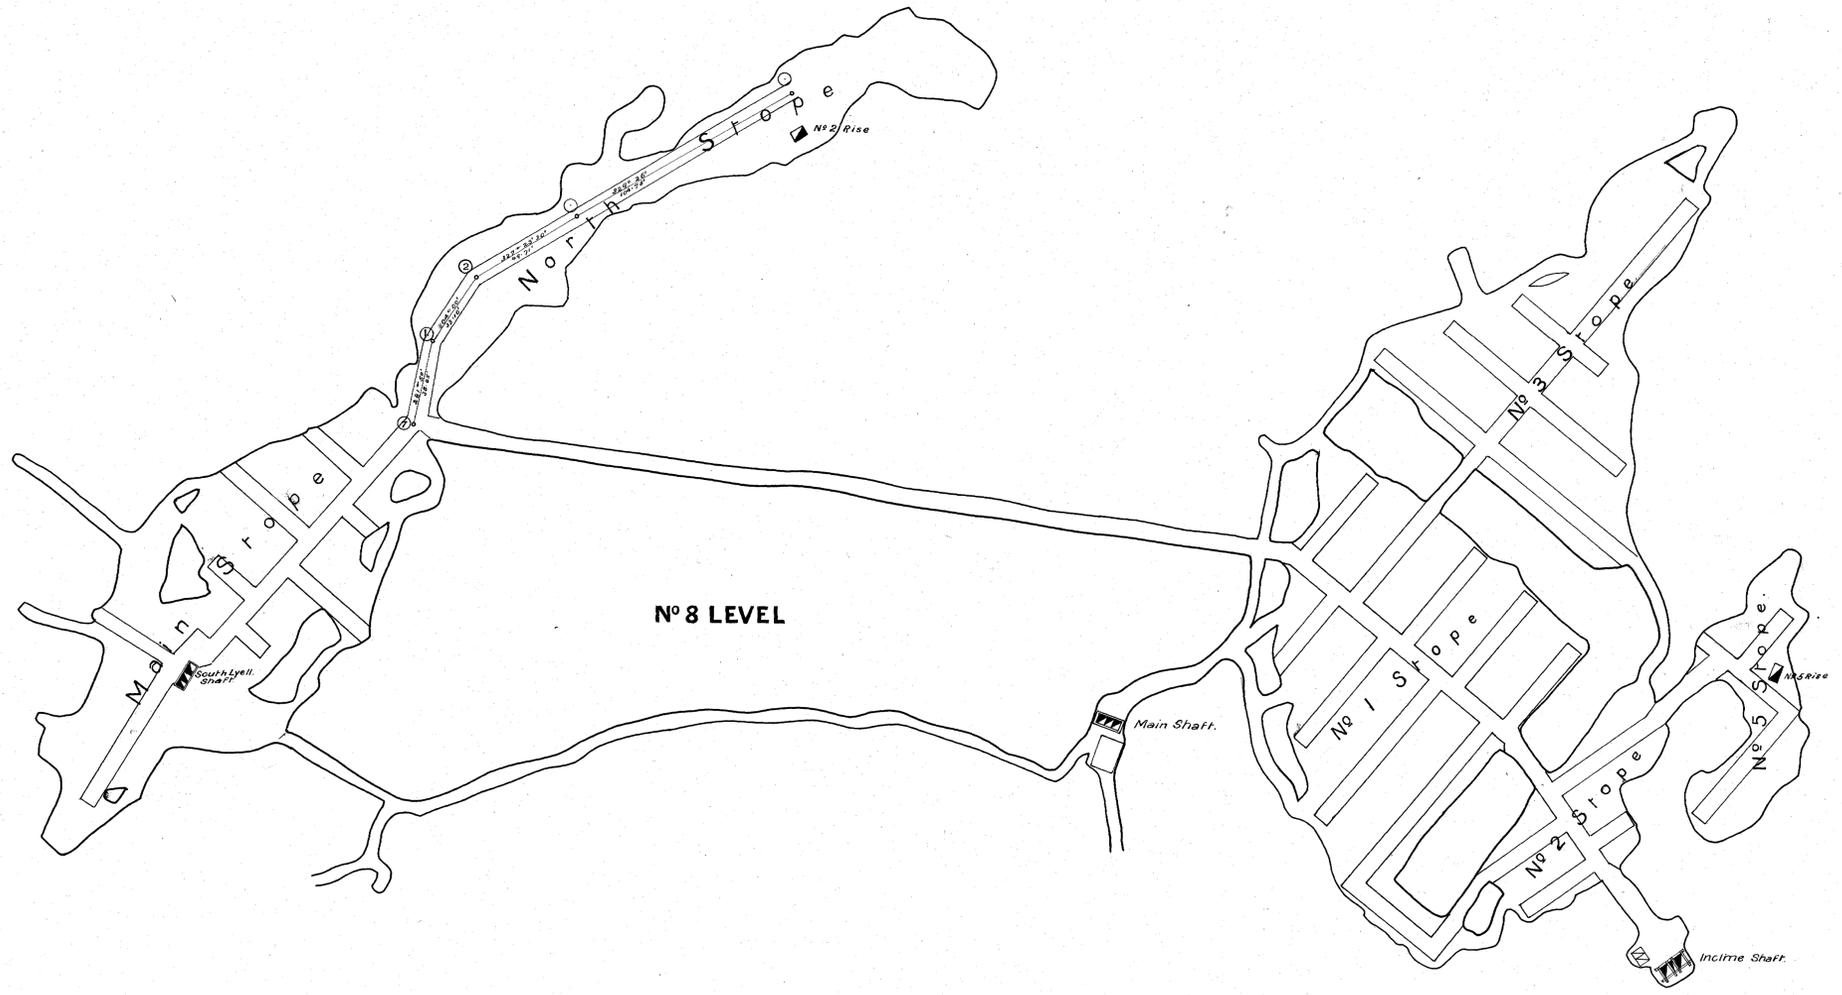

No 8 LEVEL

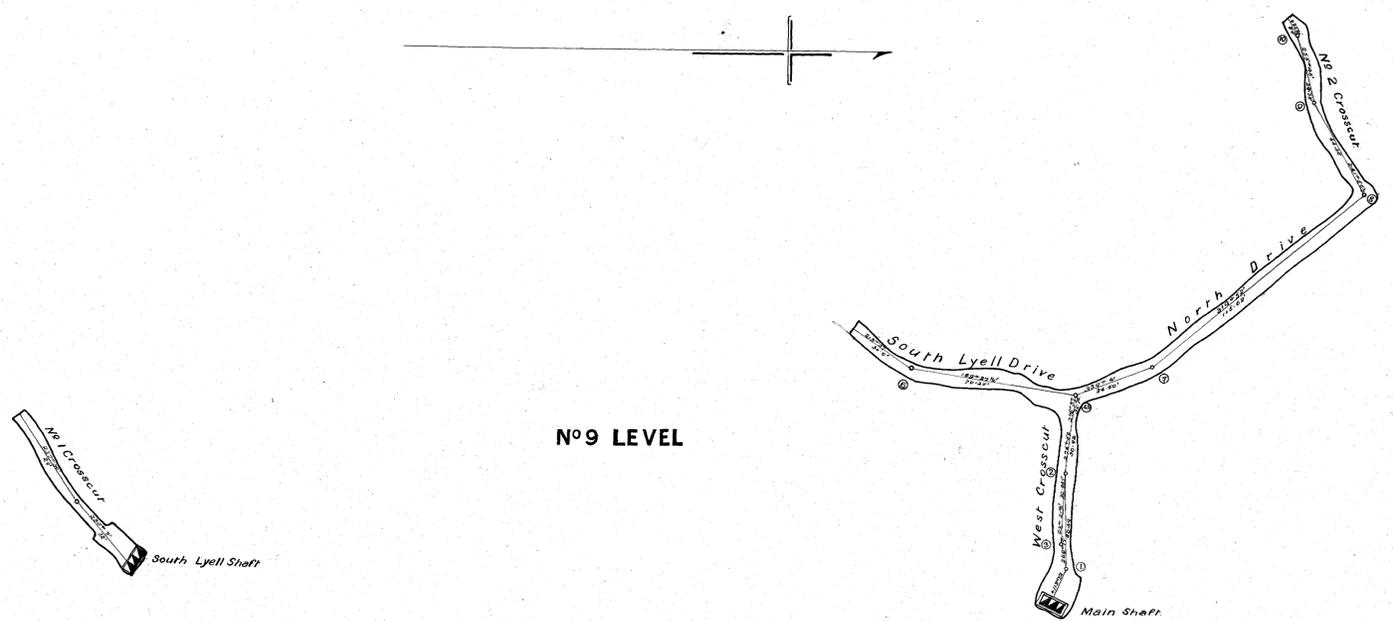

No 9 LEVEL

The Mount Lyell Mining & Railway Co. Ltd.

Mine Department.

MOUNT LYELL MINE.

UNDERGROUND WORKINGS. 1915

SCALE: 1 INCH = 30 FEET.

Robert Smith General Manager.

Richardson Engineer-in-Charge.

218-143