


218-145

218-145

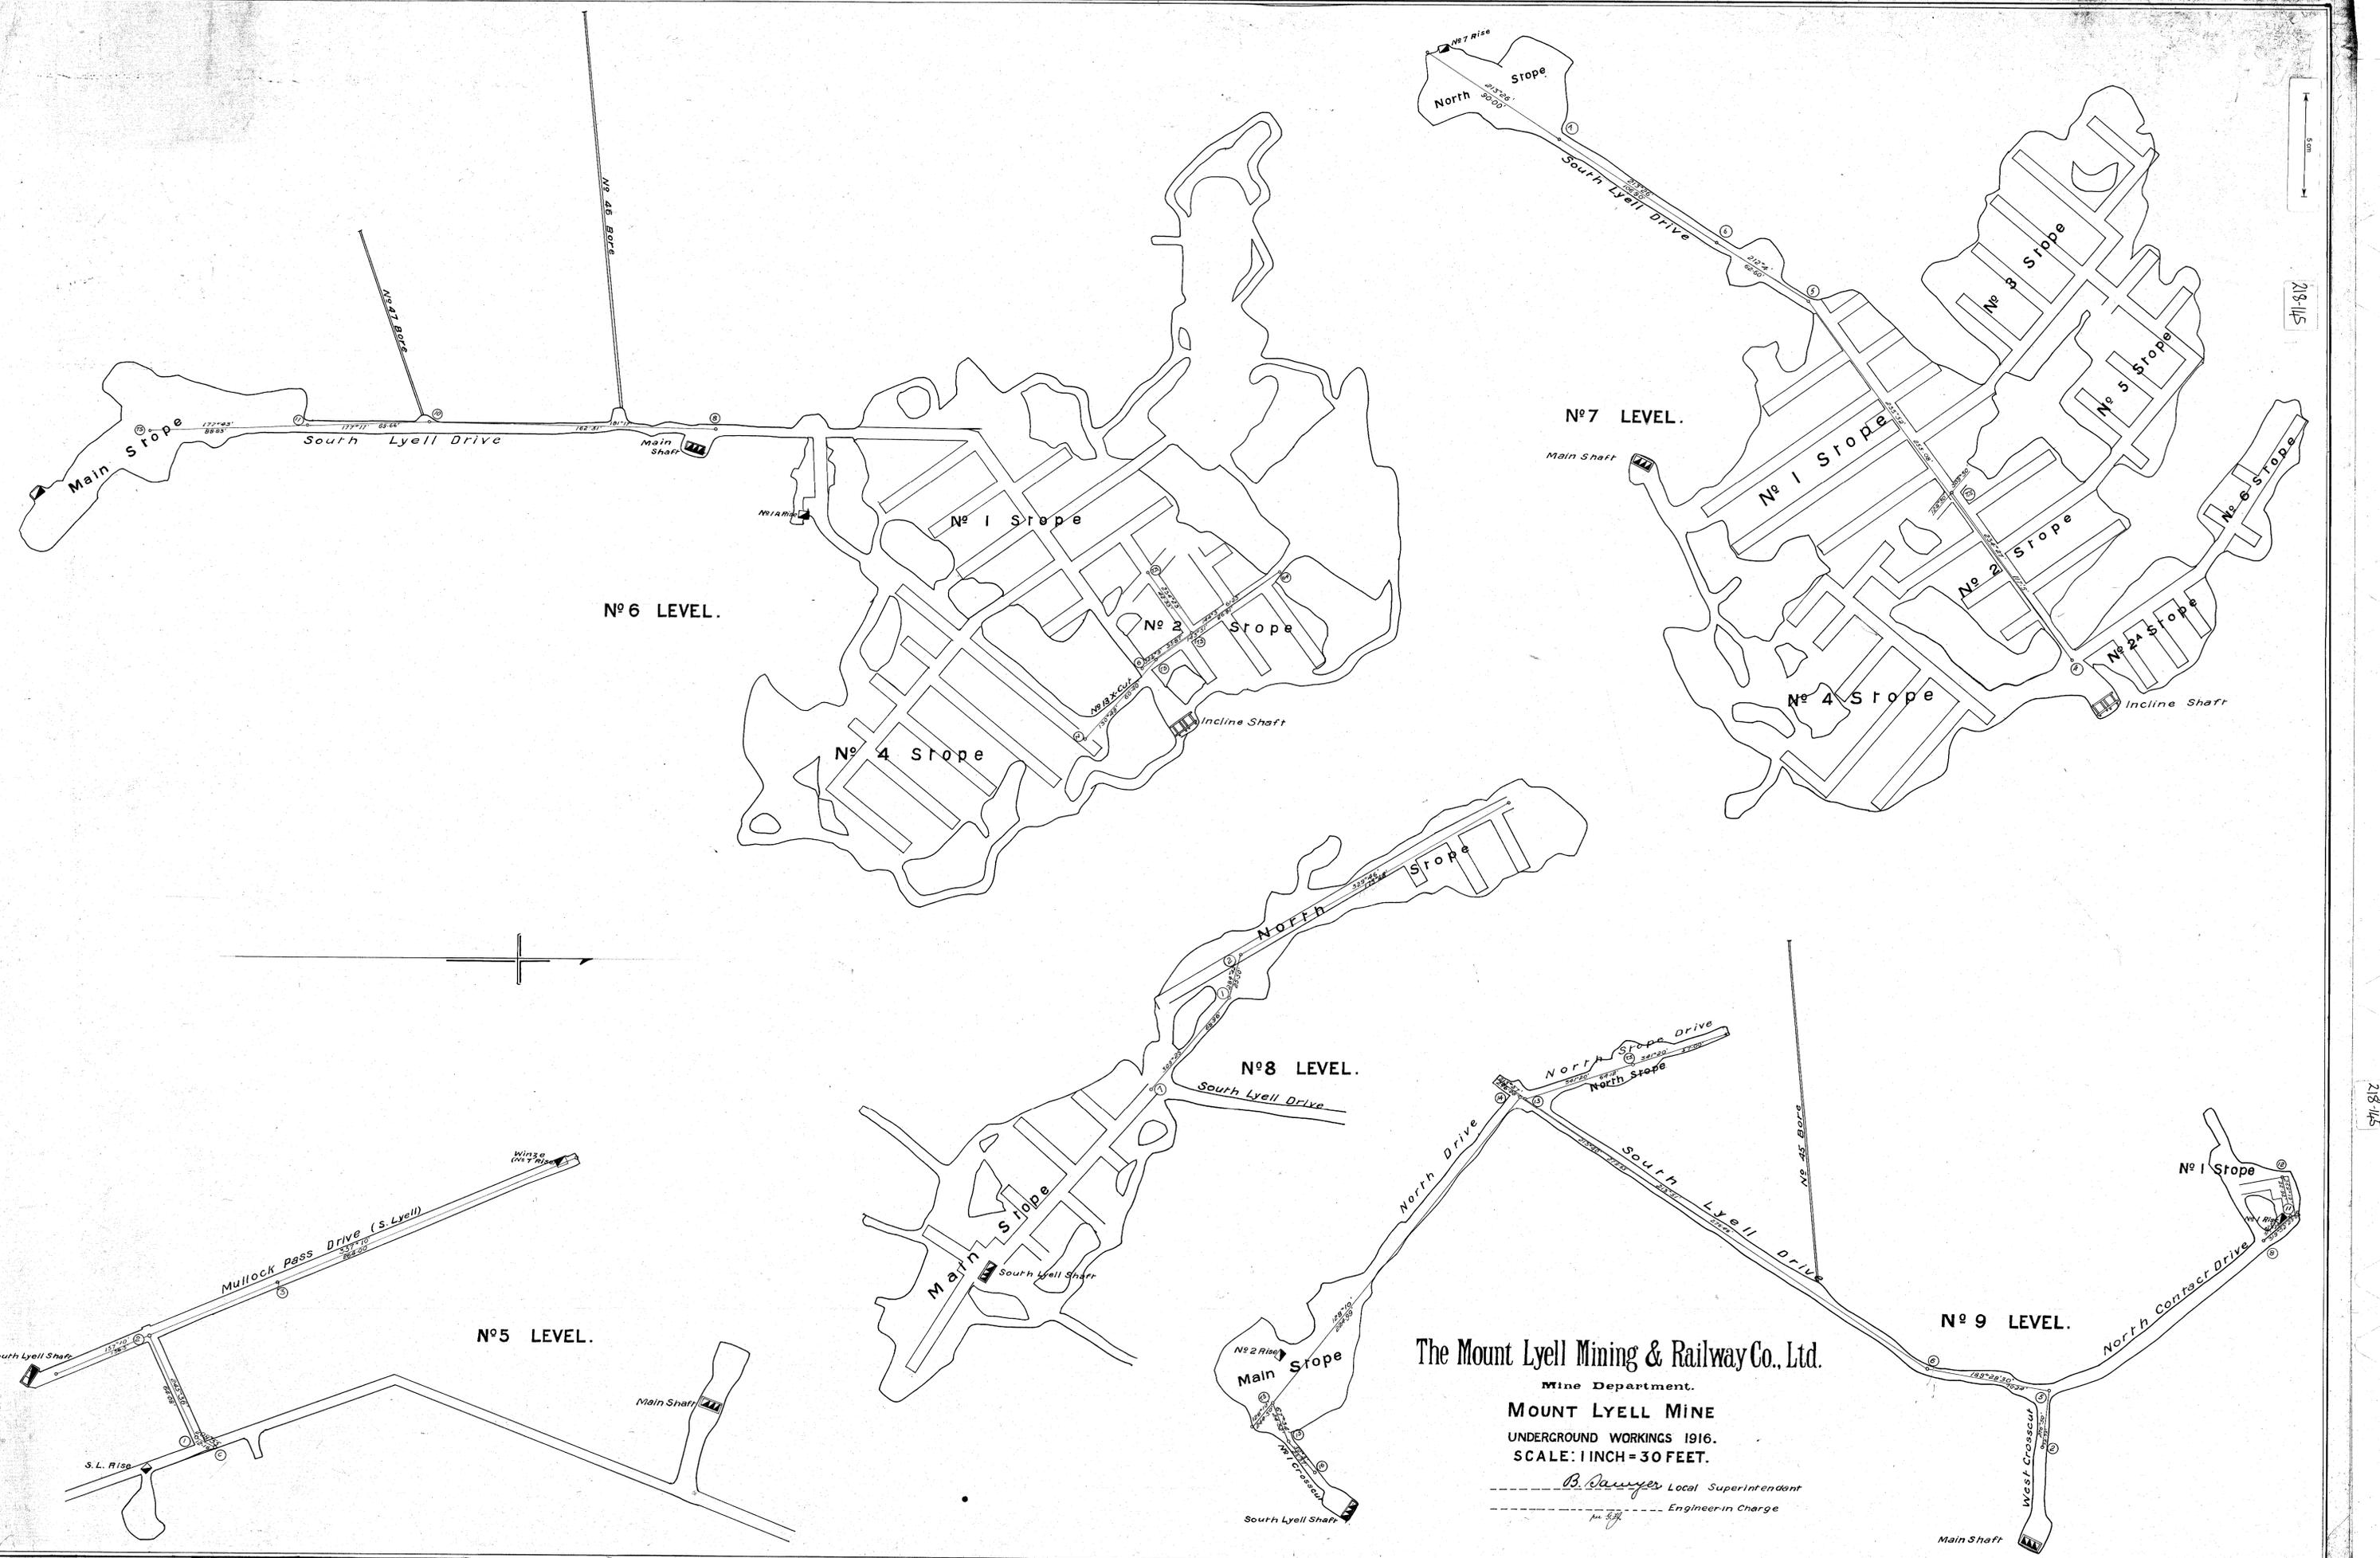

The Mount Lyell Mining & Railway Co., Ltd.
 Mine Department.
MOUNT LYELL MINE
 UNDERGROUND WORKINGS 1916.
 SCALE: 1 INCH = 30 FEET.
B. Sawyer Local Superintendent
 Engineer-in Charge