


28-146



28-146

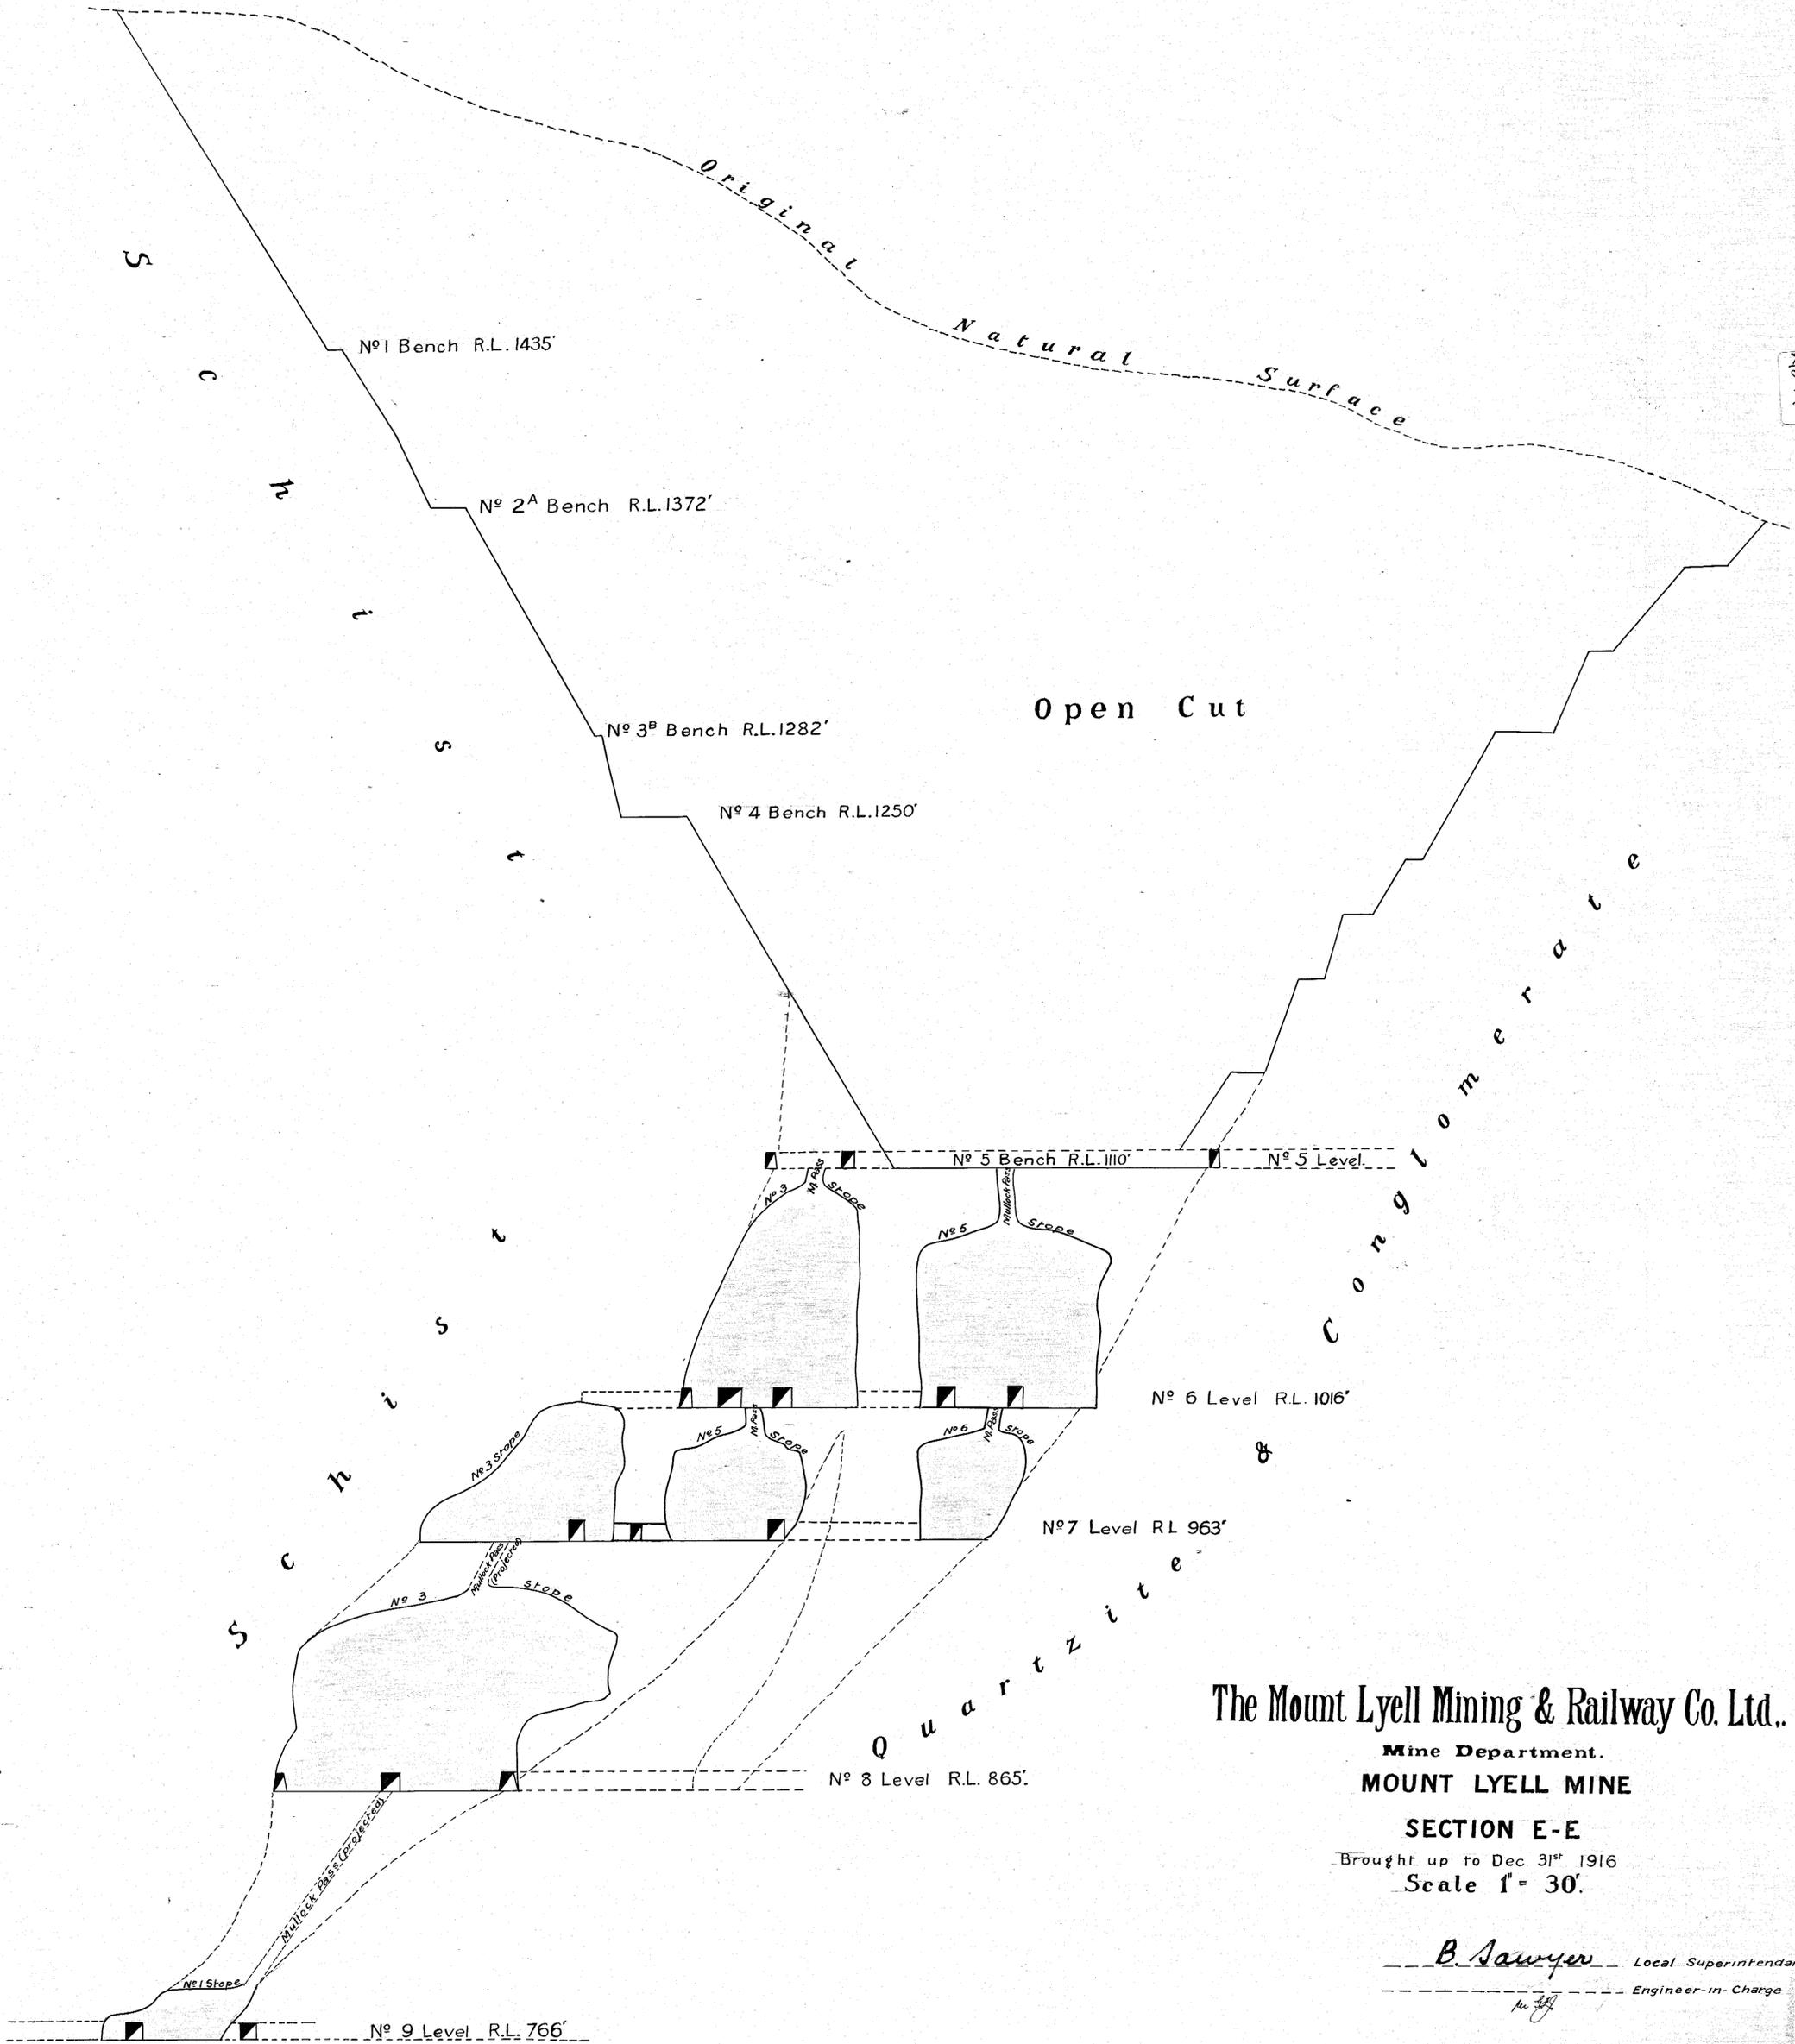

The Mount Lyell Mining & Railway Co. Ltd.

Mine Department.
MOUNT LYELL MINE

SECTION E-E

Brought up to Dec 31st 1916
Scale 1" = 30'

B. Sawyer Local Superintendent
Engineer-in-Charge