


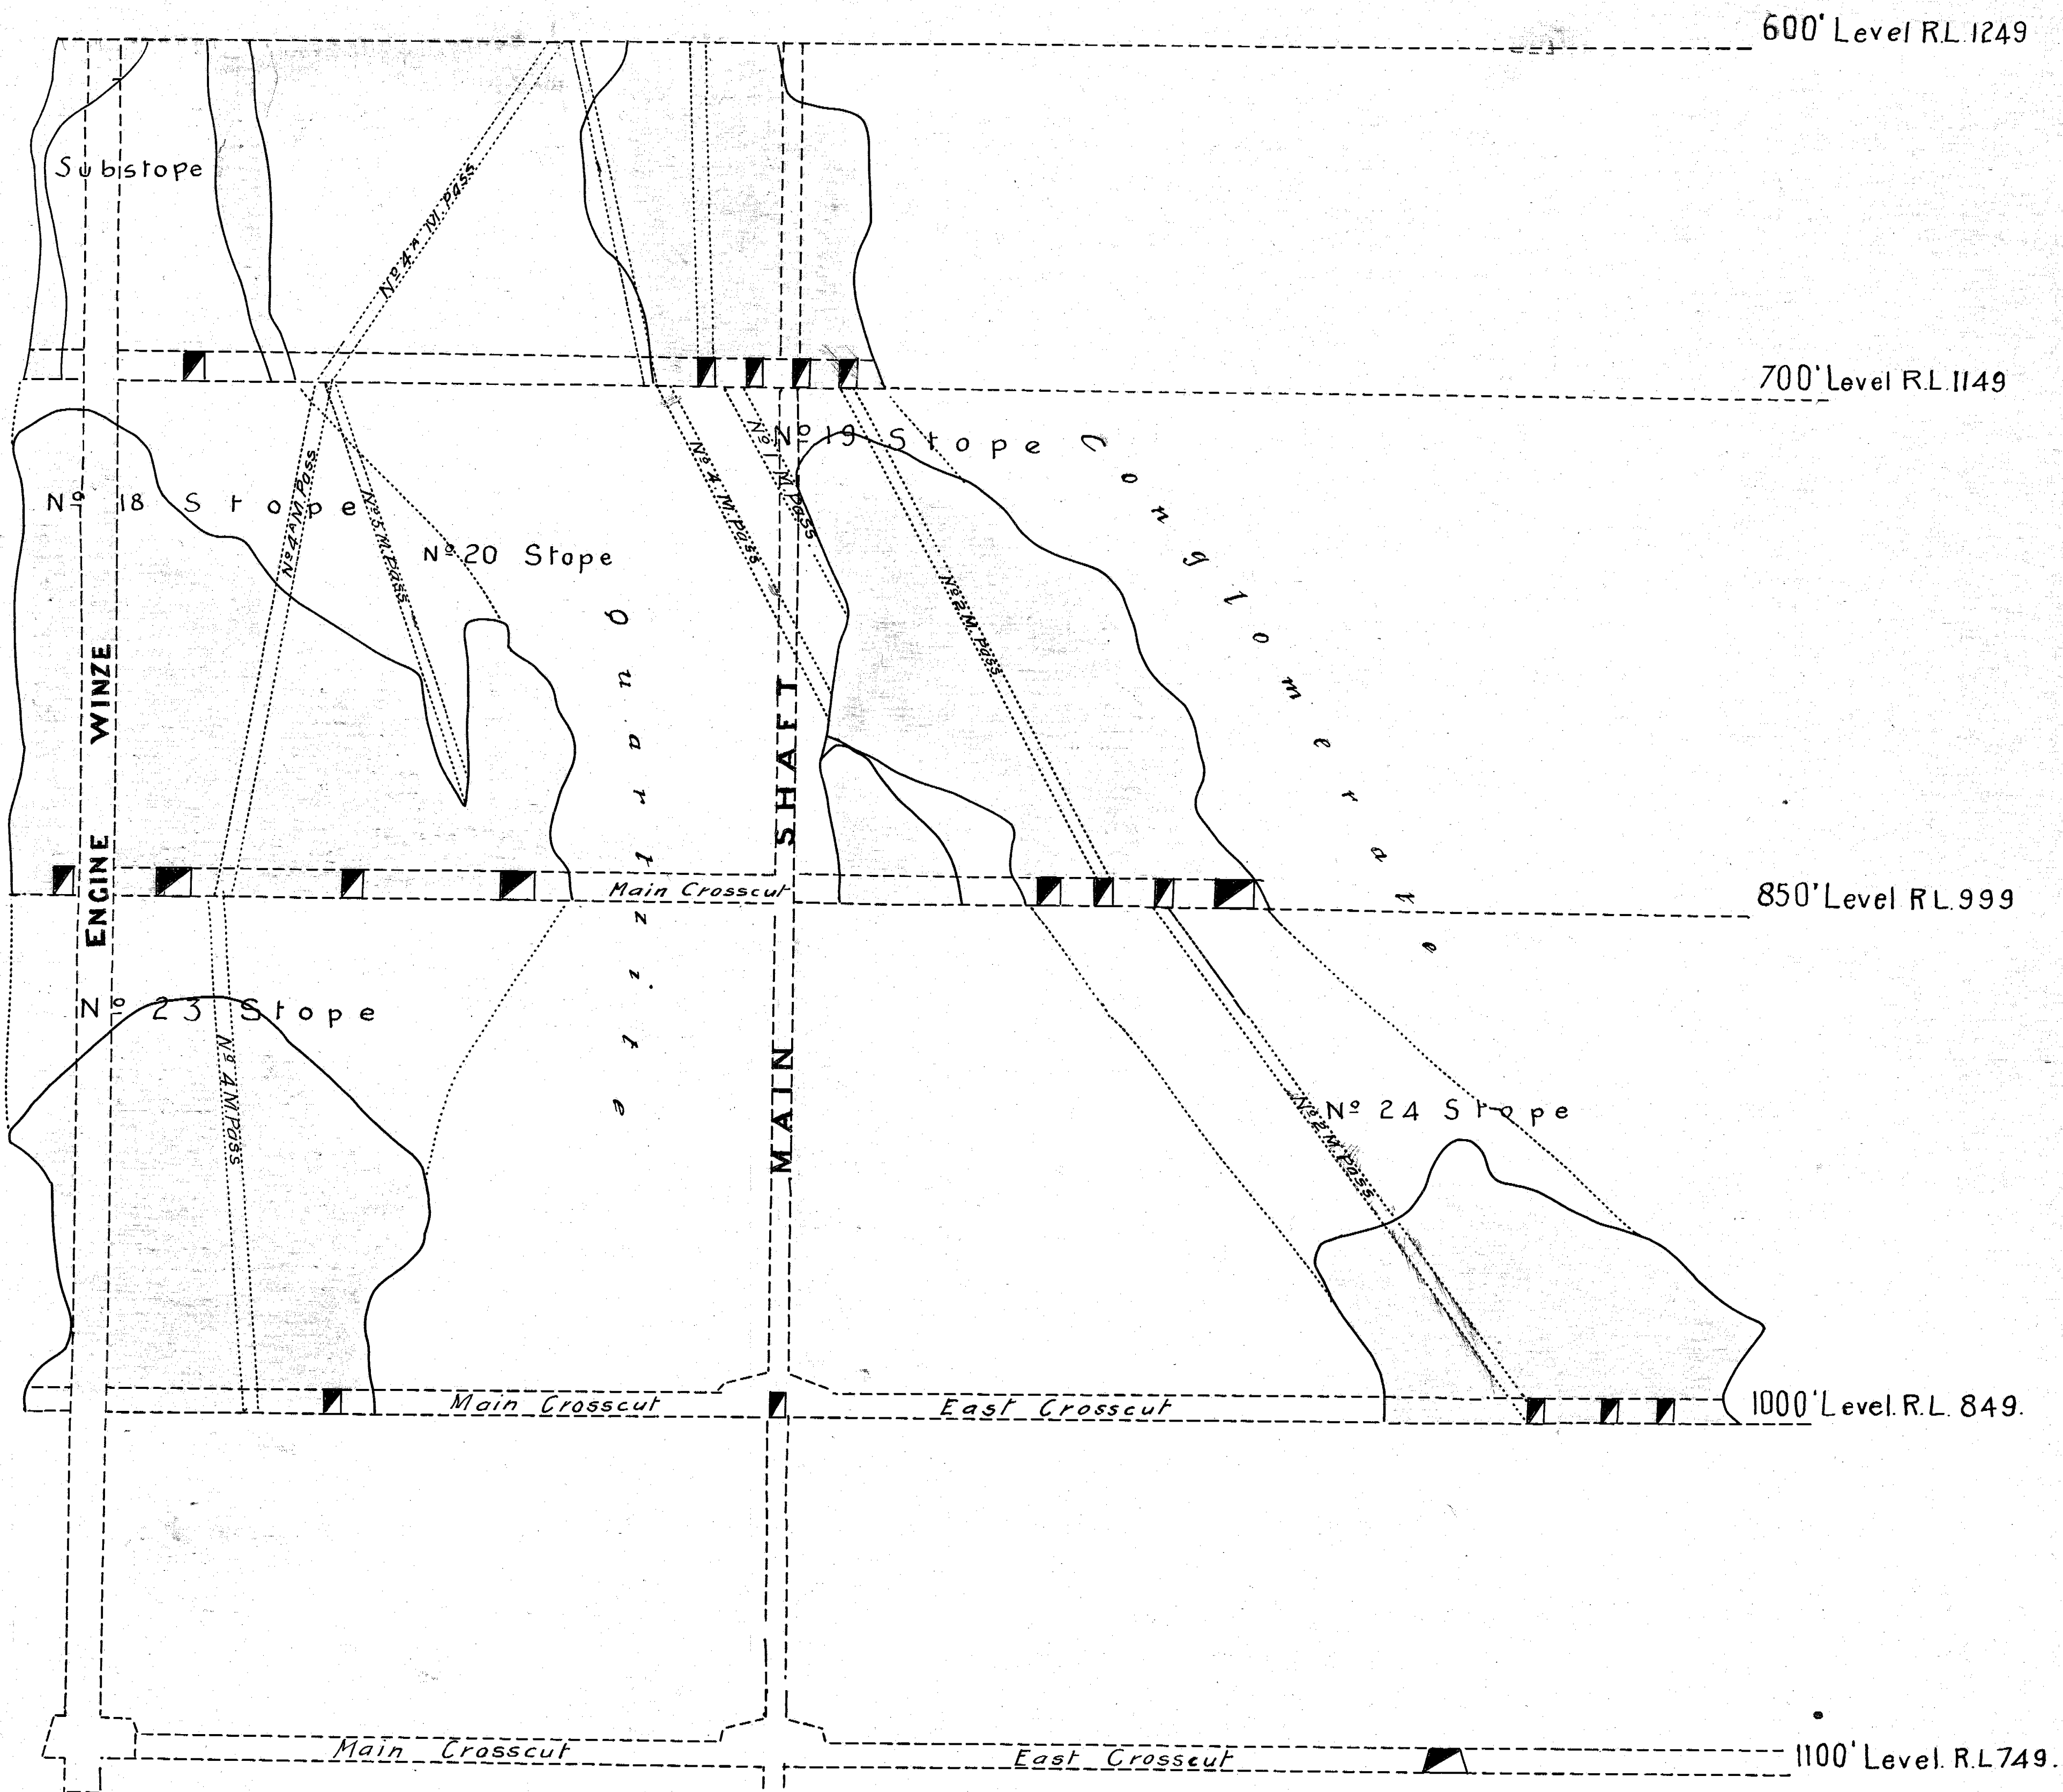

The Mount Lyell Mining & Railway Co. Ltd.

Mine Department.

NORTH LYELL MINE
Section on Line BB looking North.

Brought up to Dec 31st 1916

Scale 1" = 30'.

Robt. Sticht, General Manager
per J. H. [Signature] Engineer-in-Charge