


5 cm

218-152

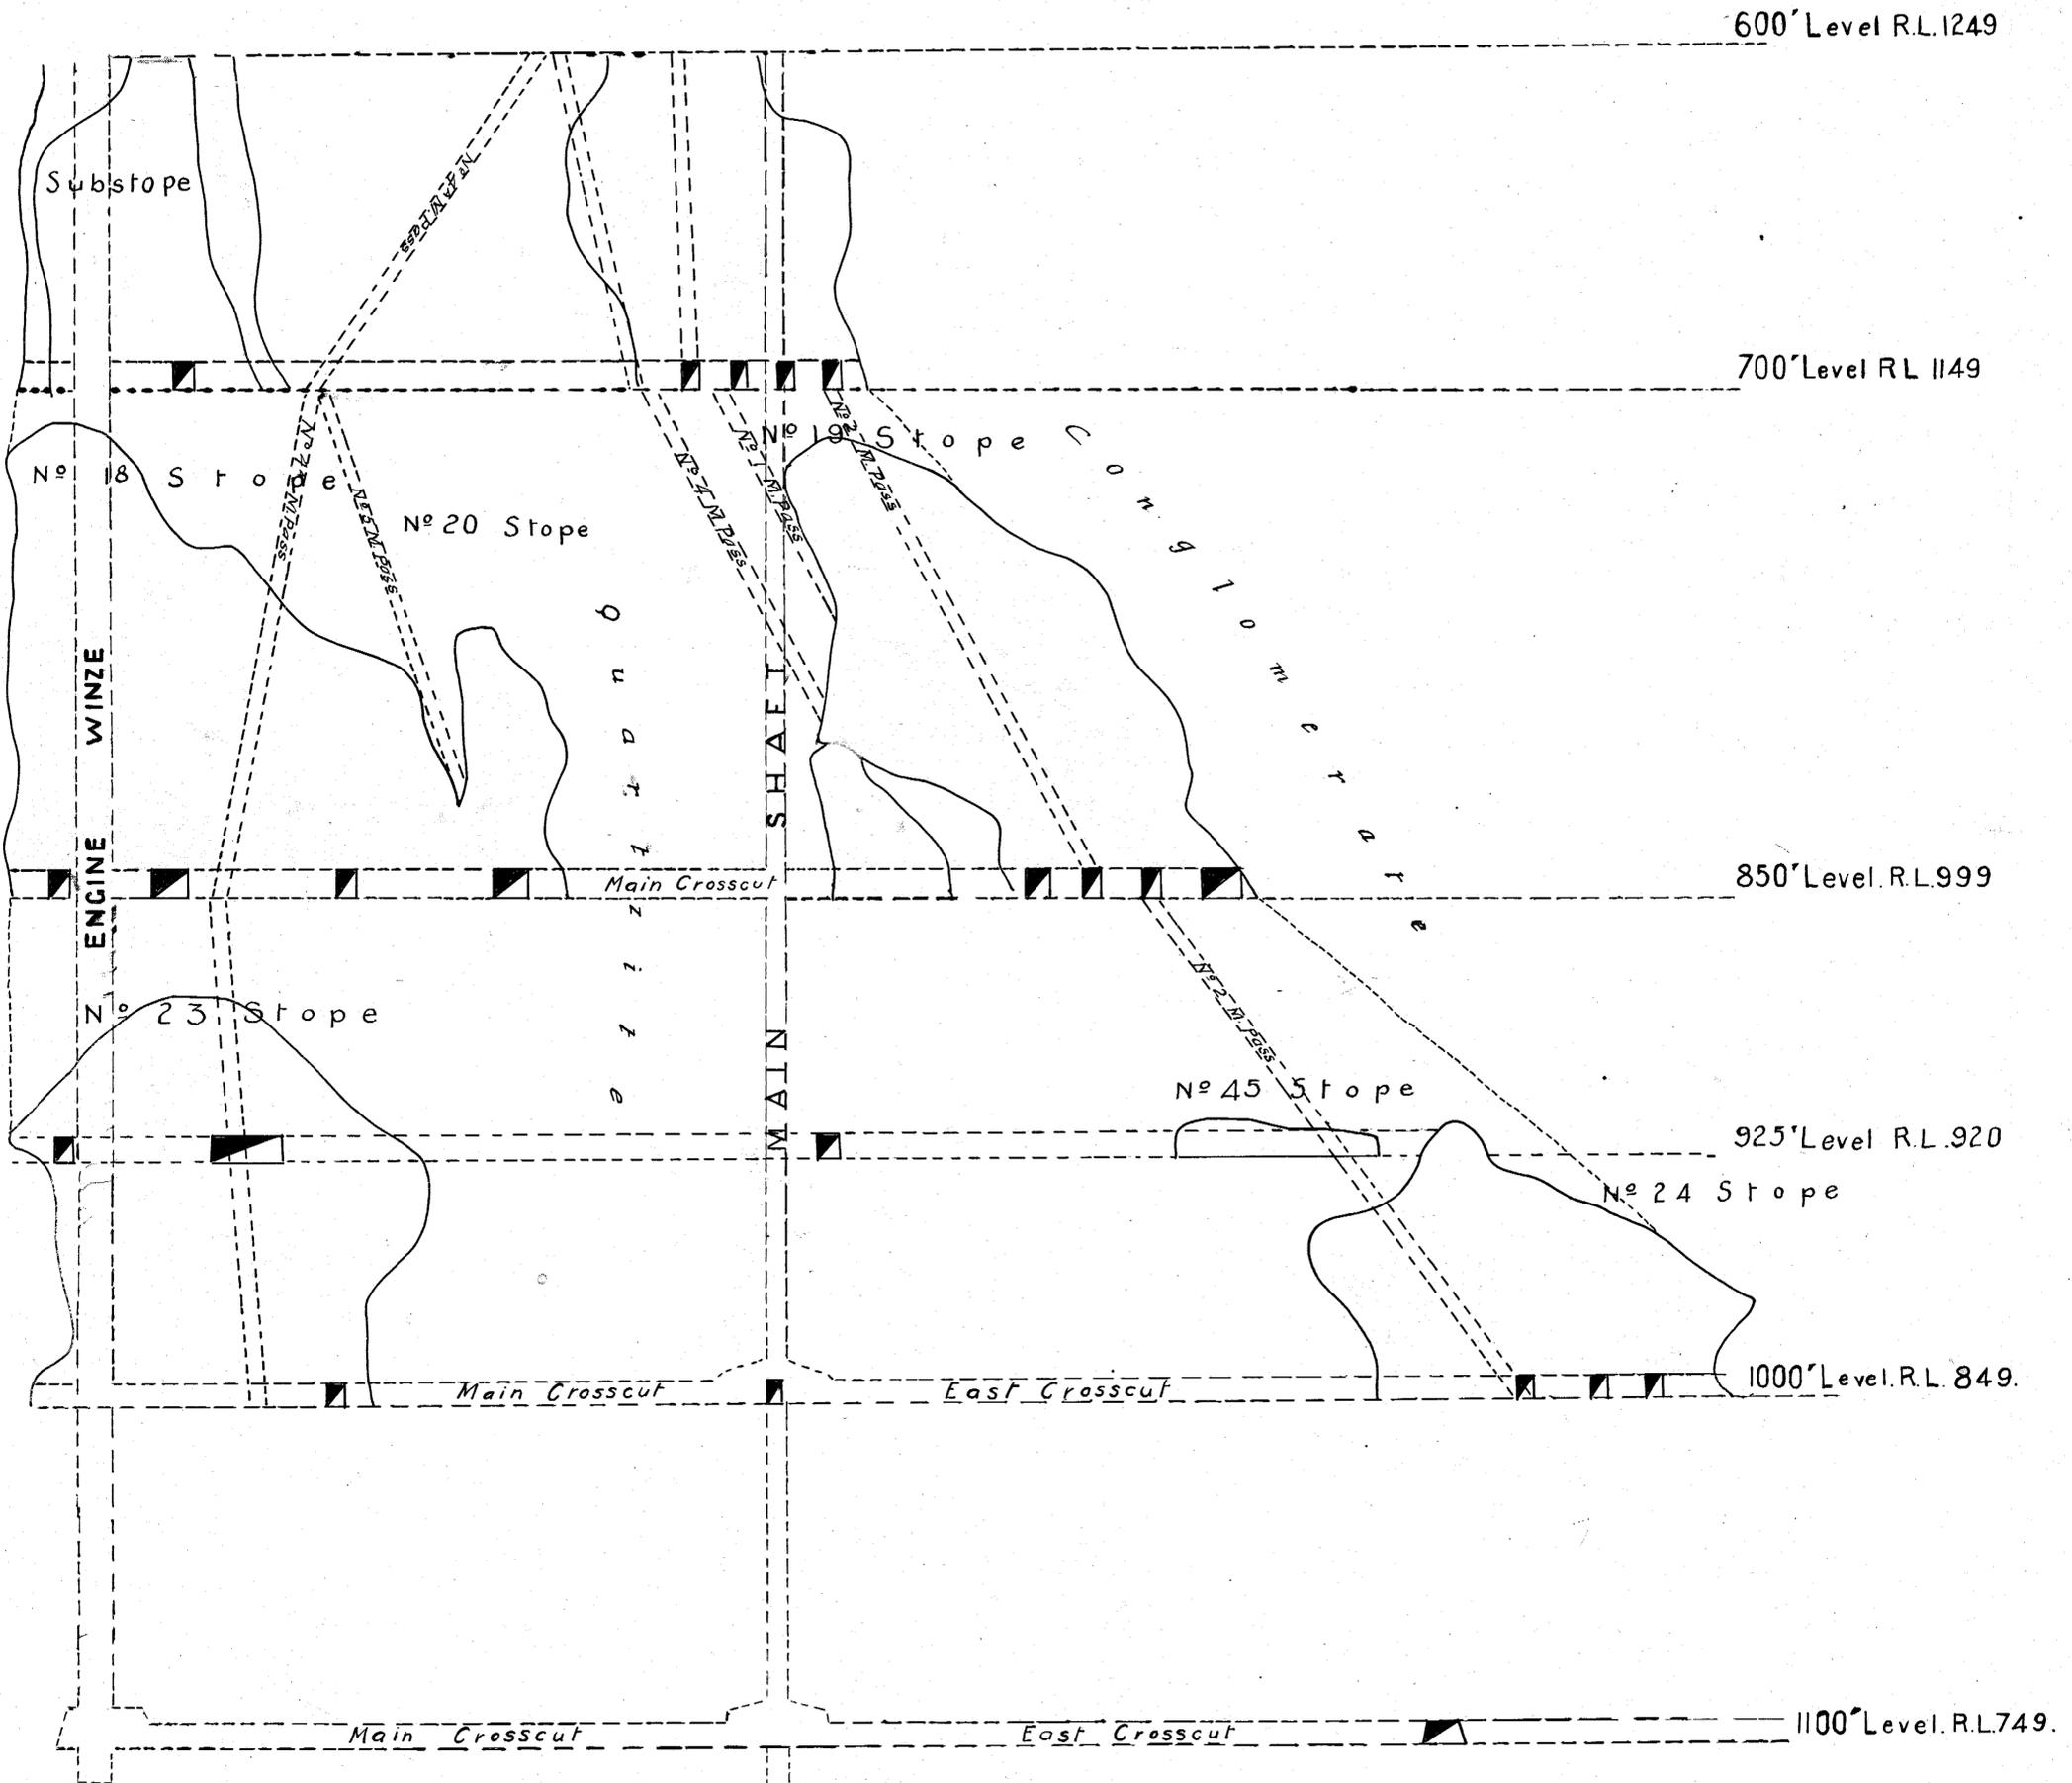

The Mount Lyell Mining & Railway Co Ltd

Mine Department.

NORTH LYELL MINE.
Section on Line BB looking North.

Brought up to Dec 31st 1917

Scale 1" = 30'

Robert Smith General Manager.
Richard ... Engineer-in-Charge.