


151


5m

218-153


218-153

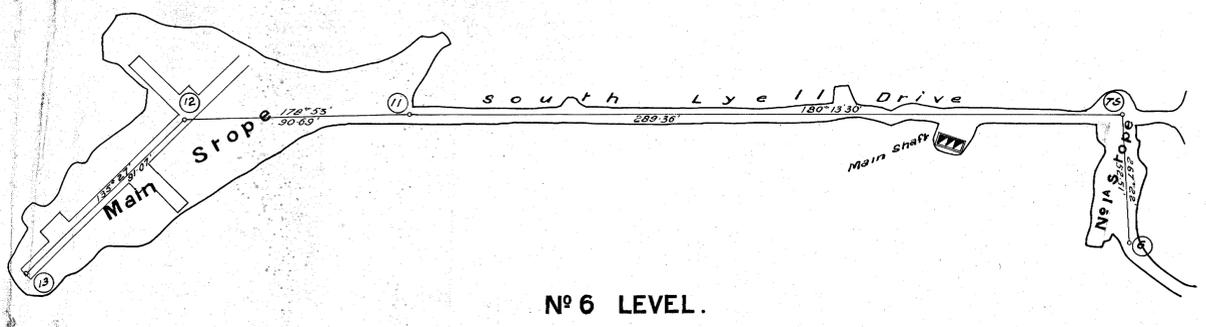


No 6 LEVEL.

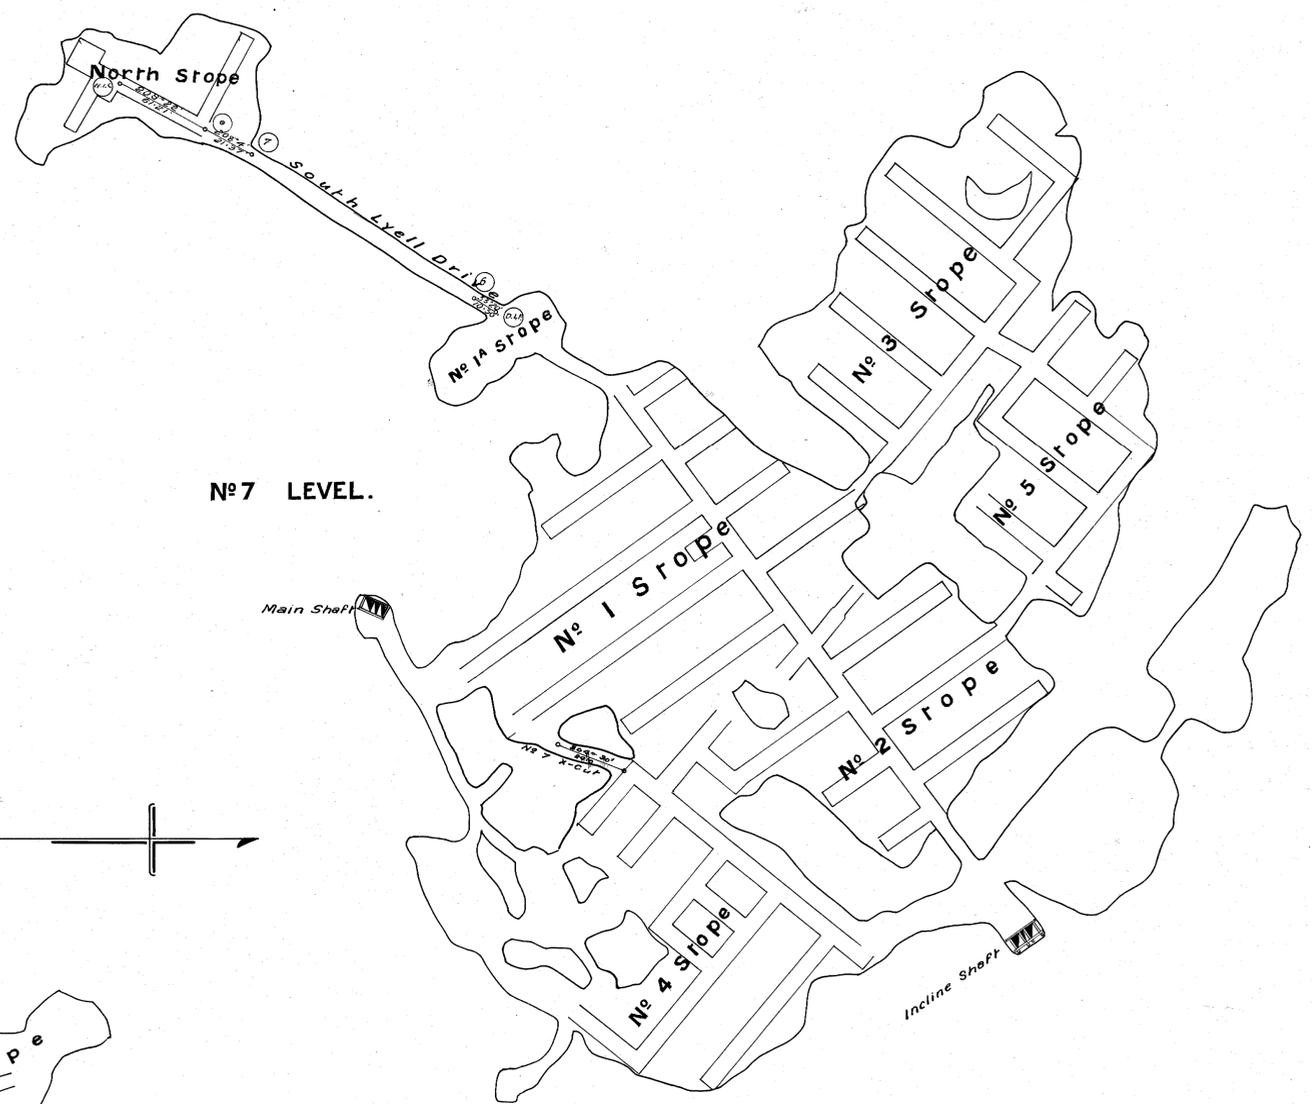


No 7 LEVEL.

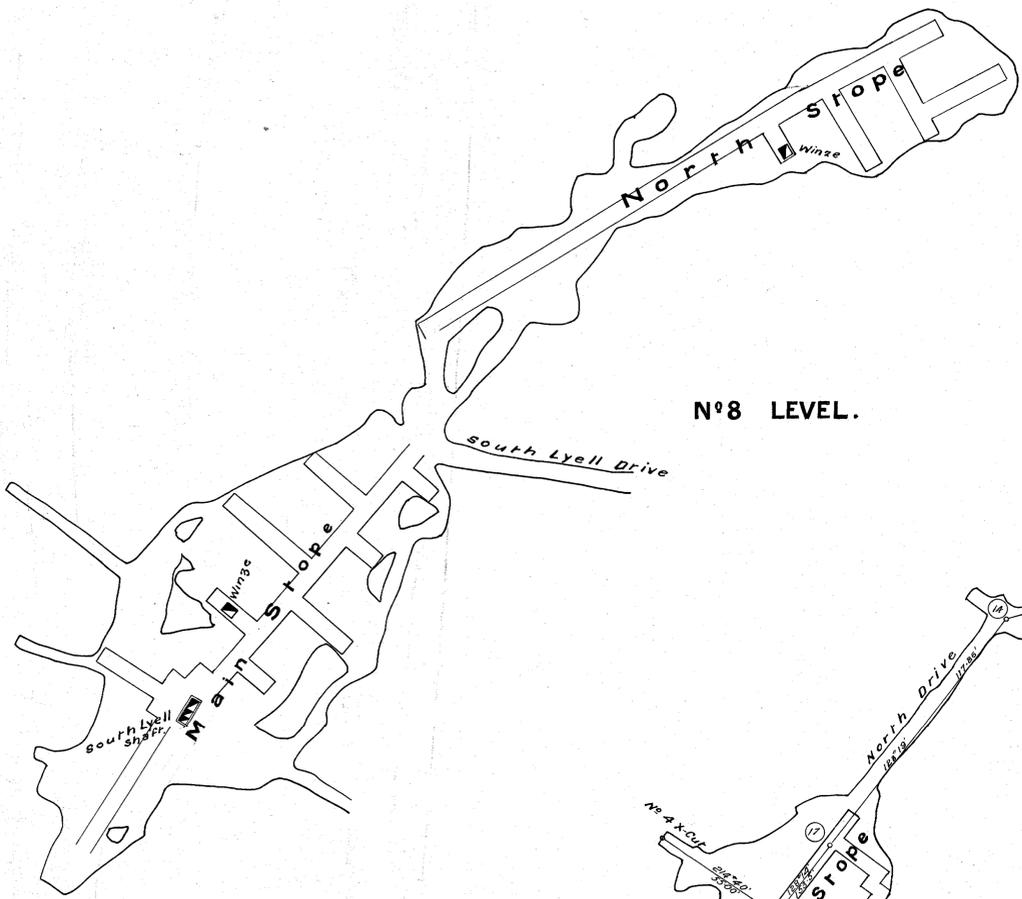

No 8 LEVEL.

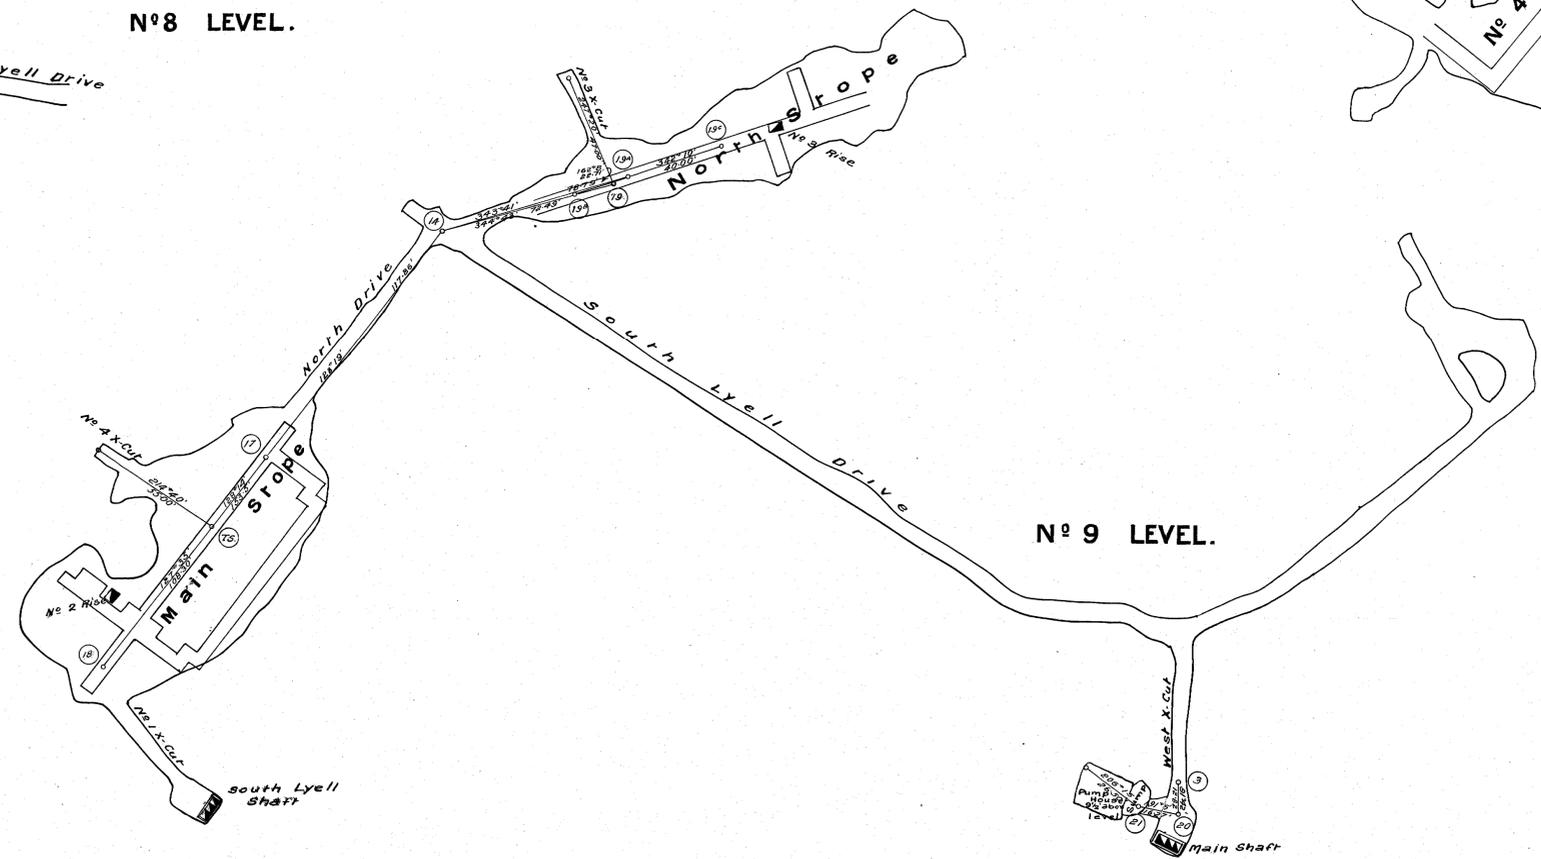

No 9 LEVEL.

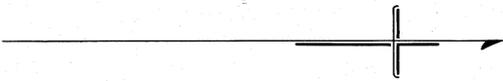

The Mount Lyell Mining & Railway Co., Ltd.

Mine Department.  
MOUNT LYELL MINE

UNDERGROUND WORKINGS 1917.  
SCALE: 1 INCH = 30 FEET.

*Robert Smith* General Manager  
*A. H. Murray* Engineer-in-Charge