


218-154

218-154

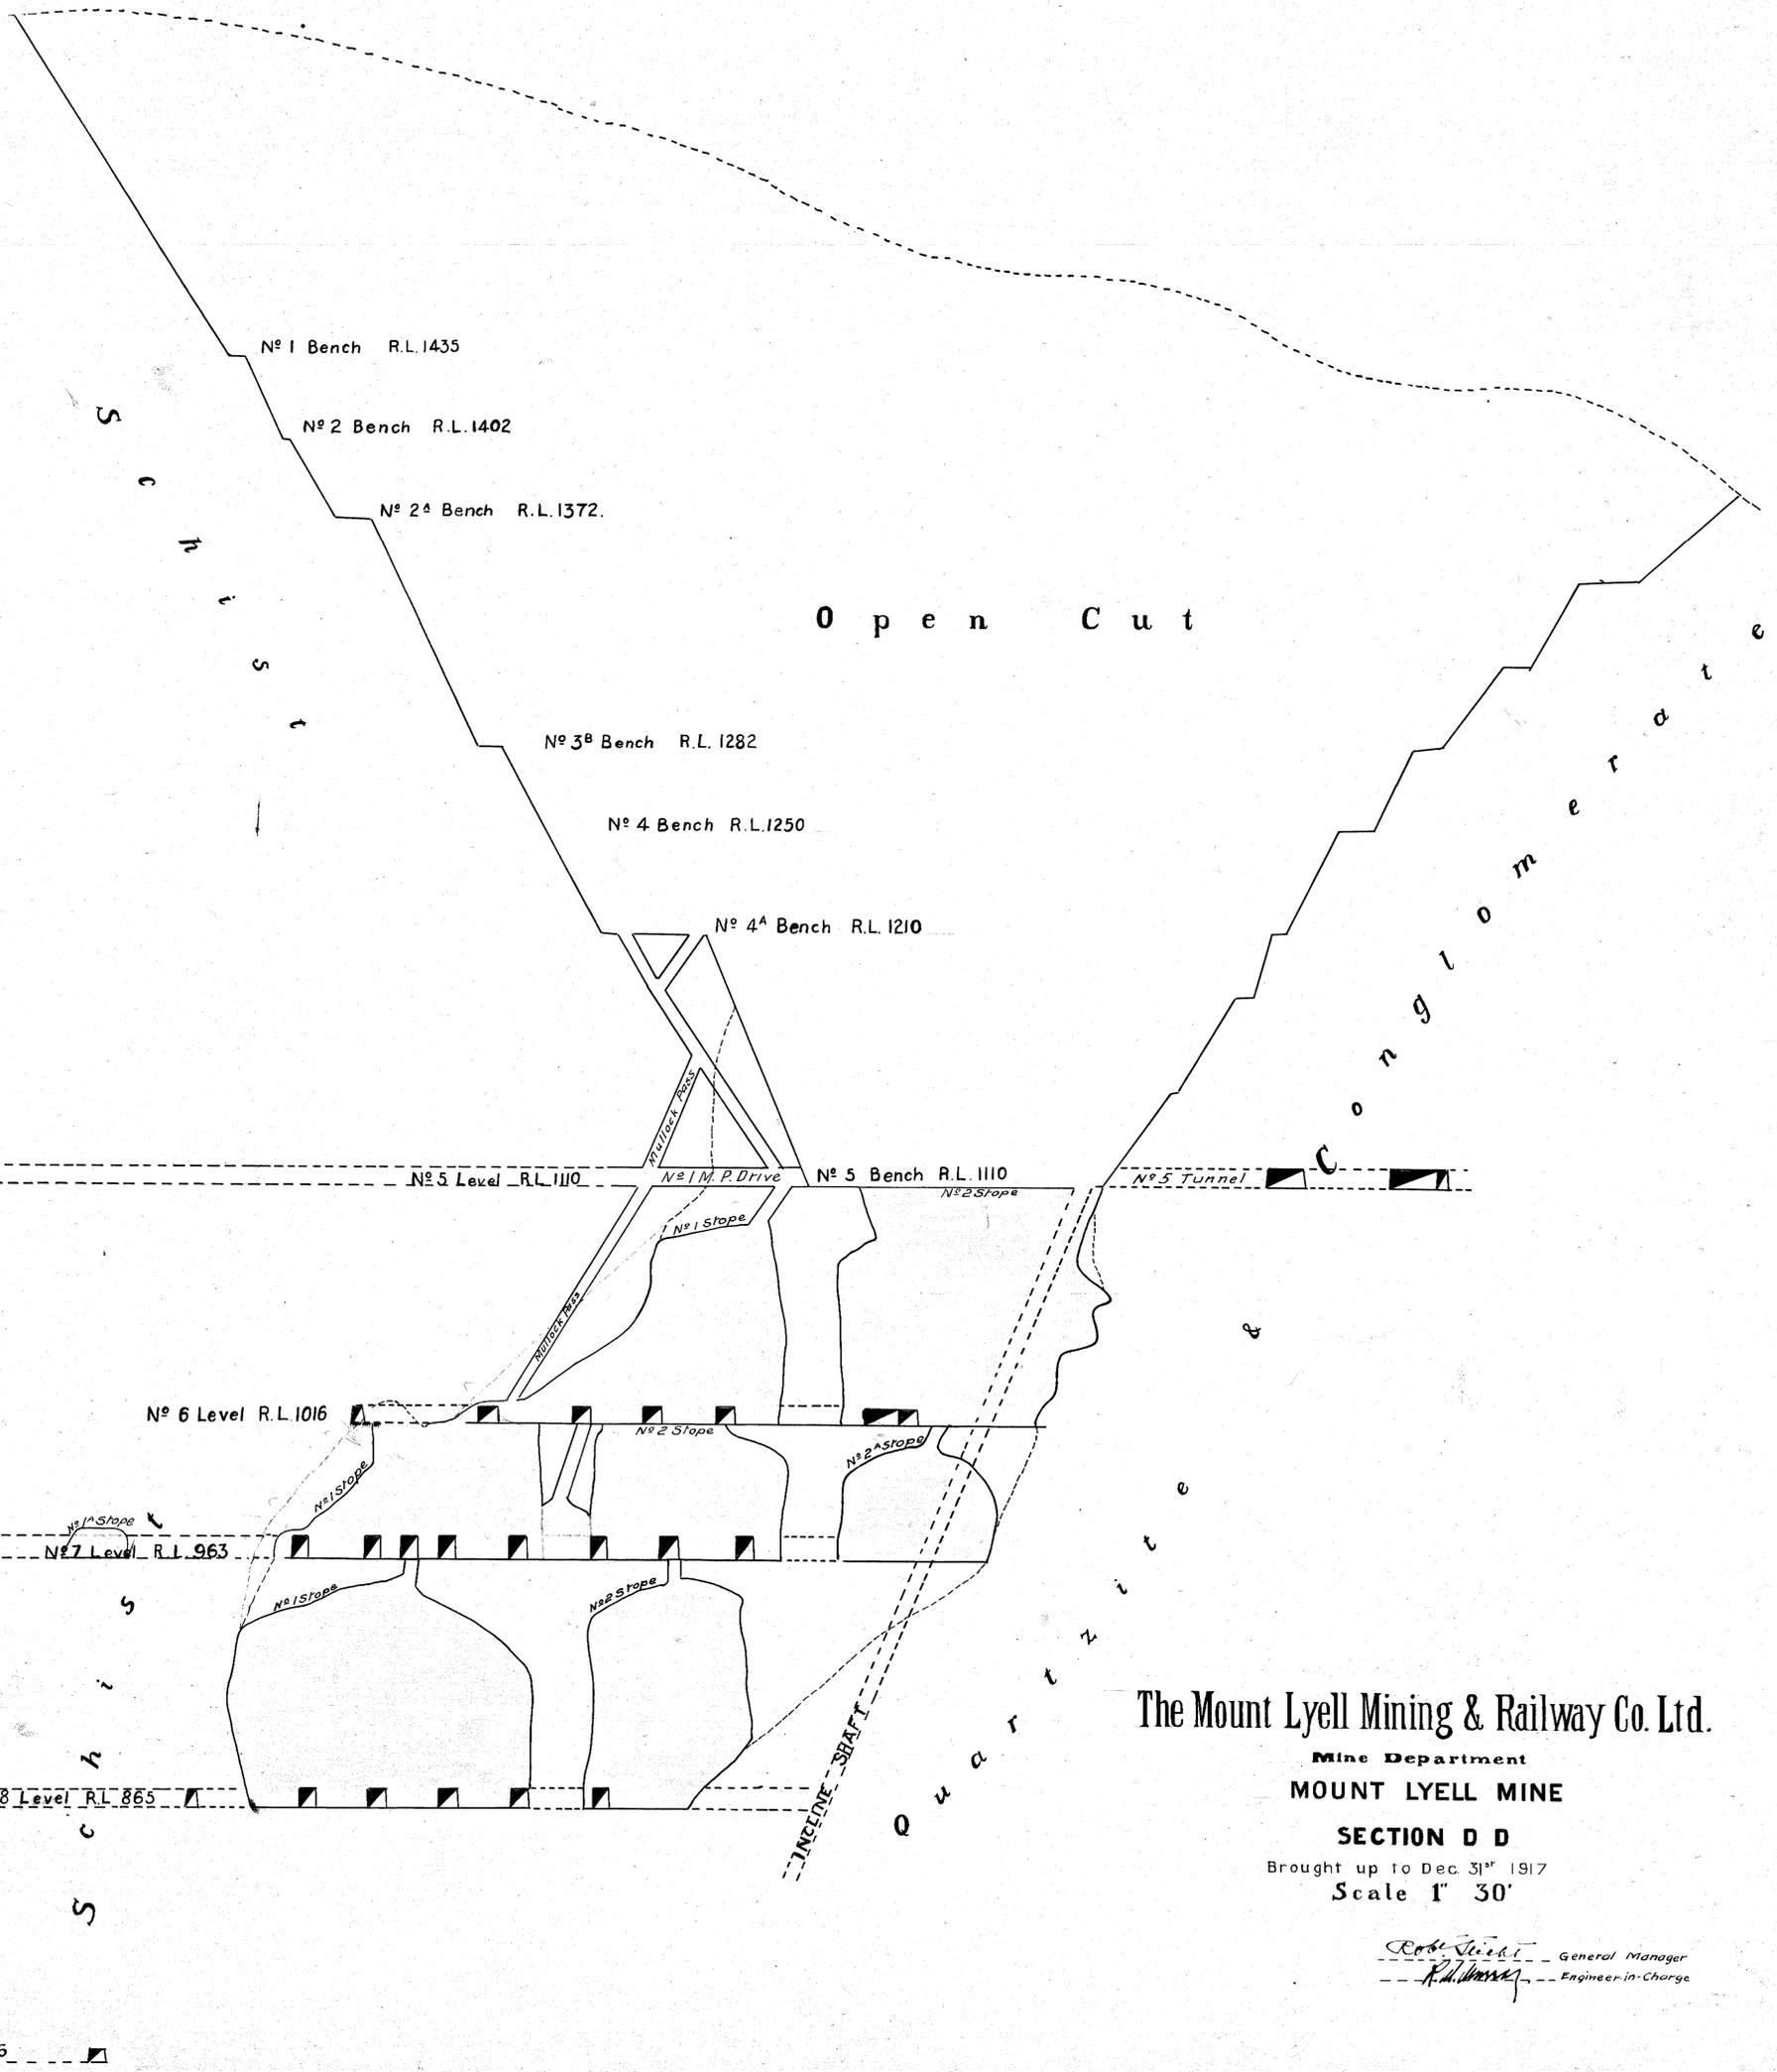

The Mount Lyell Mining & Railway Co. Ltd.

Mine Department  
MOUNT LYELL MINE

SECTION D D

Brought up to Dec 31<sup>st</sup> 1917

Scale 1" = 30'

Robt. Stebbins General Manager  
A.H. Harvey Engineer-in-Charge

