


218/155

218/155

5 cm

South Lyell workings

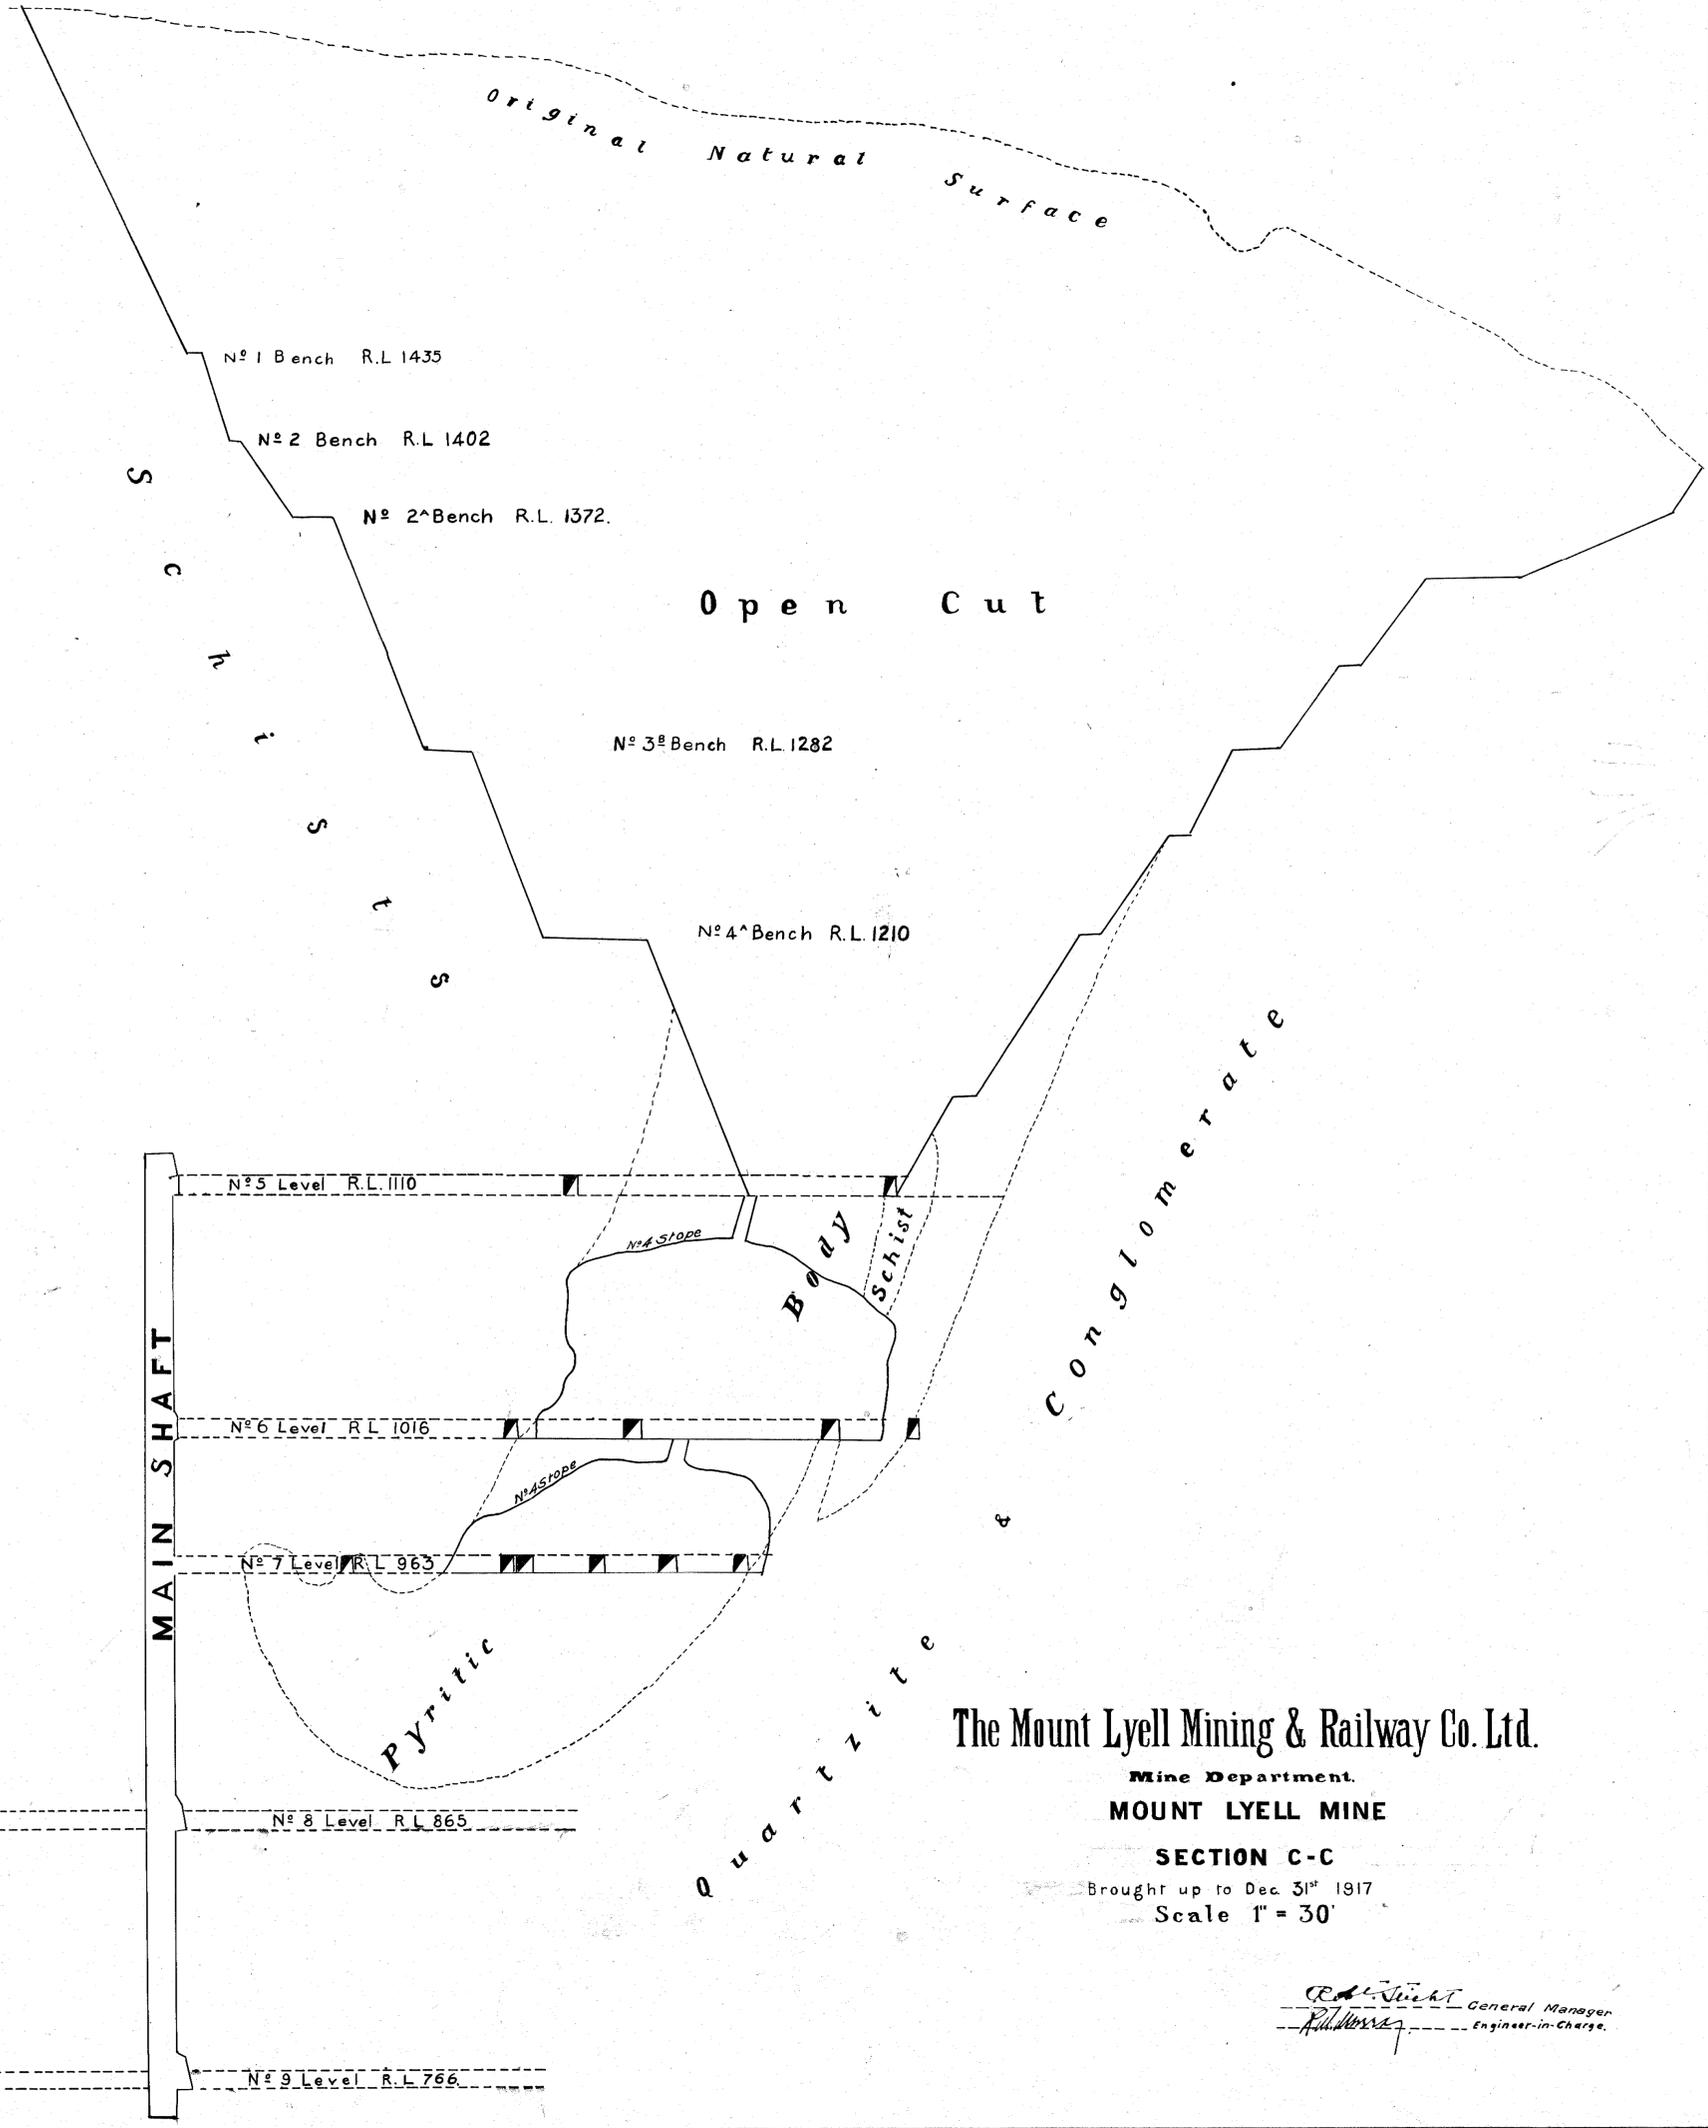

The Mount Lyell Mining & Railway Co. Ltd.

Mine Department
MOUNT LYELL MINE

SECTION C-C

Brought up to Dec 31st 1917

Scale 1" = 30'

R. A. Smith General Manager
R. W. ... Engineer-in-Charge