


5 cm

218756

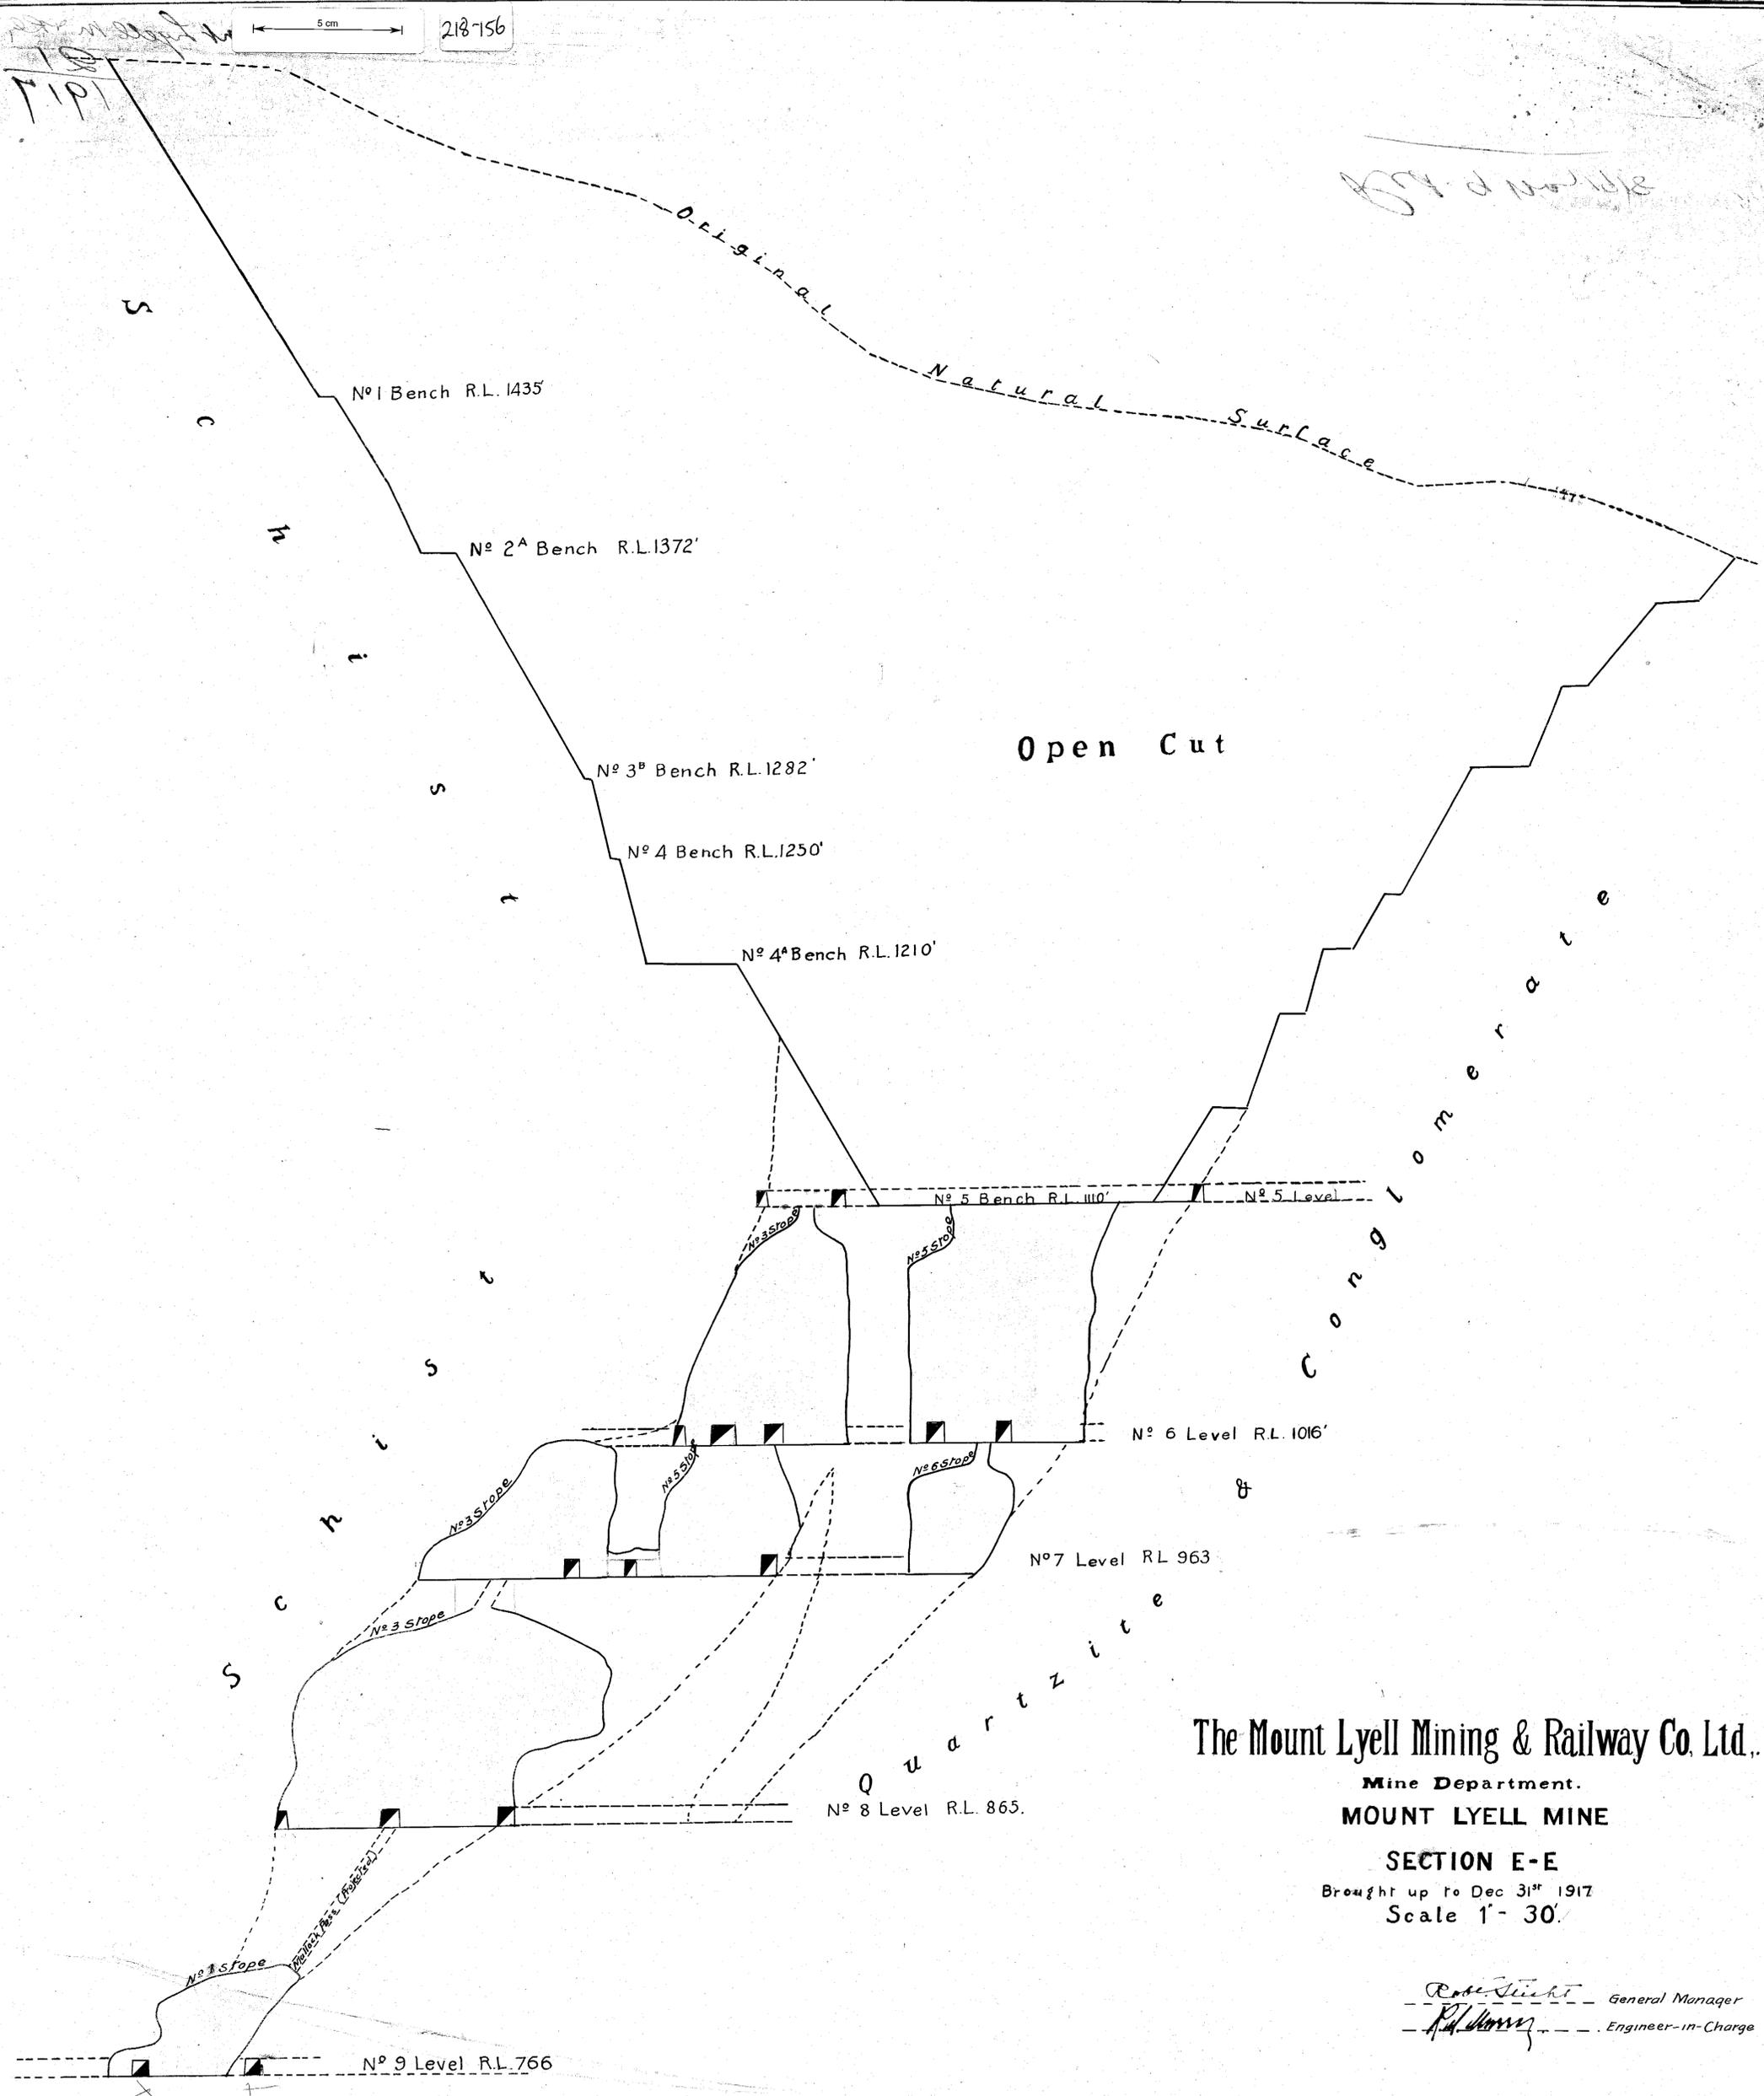

The Mount Lyell Mining & Railway Co. Ltd.

Mine Department.

MOUNT LYELL MINE

SECTION E-E

Brought up to Dec 31st 1917

Scale 1" = 30'

Robert Smith General Manager

R. J. Harvey Engineer-in-Charge