


218
-163

291

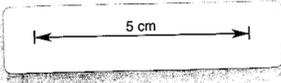

The Mount Lyell Mining & Railway Co. Ltd.


Sheet No. 1.

Mine Department.

Field Notes of Underground Workings to 31.12.14.

Instrument used 5" Theodolite.

General Manager
Engineer-in-Charge

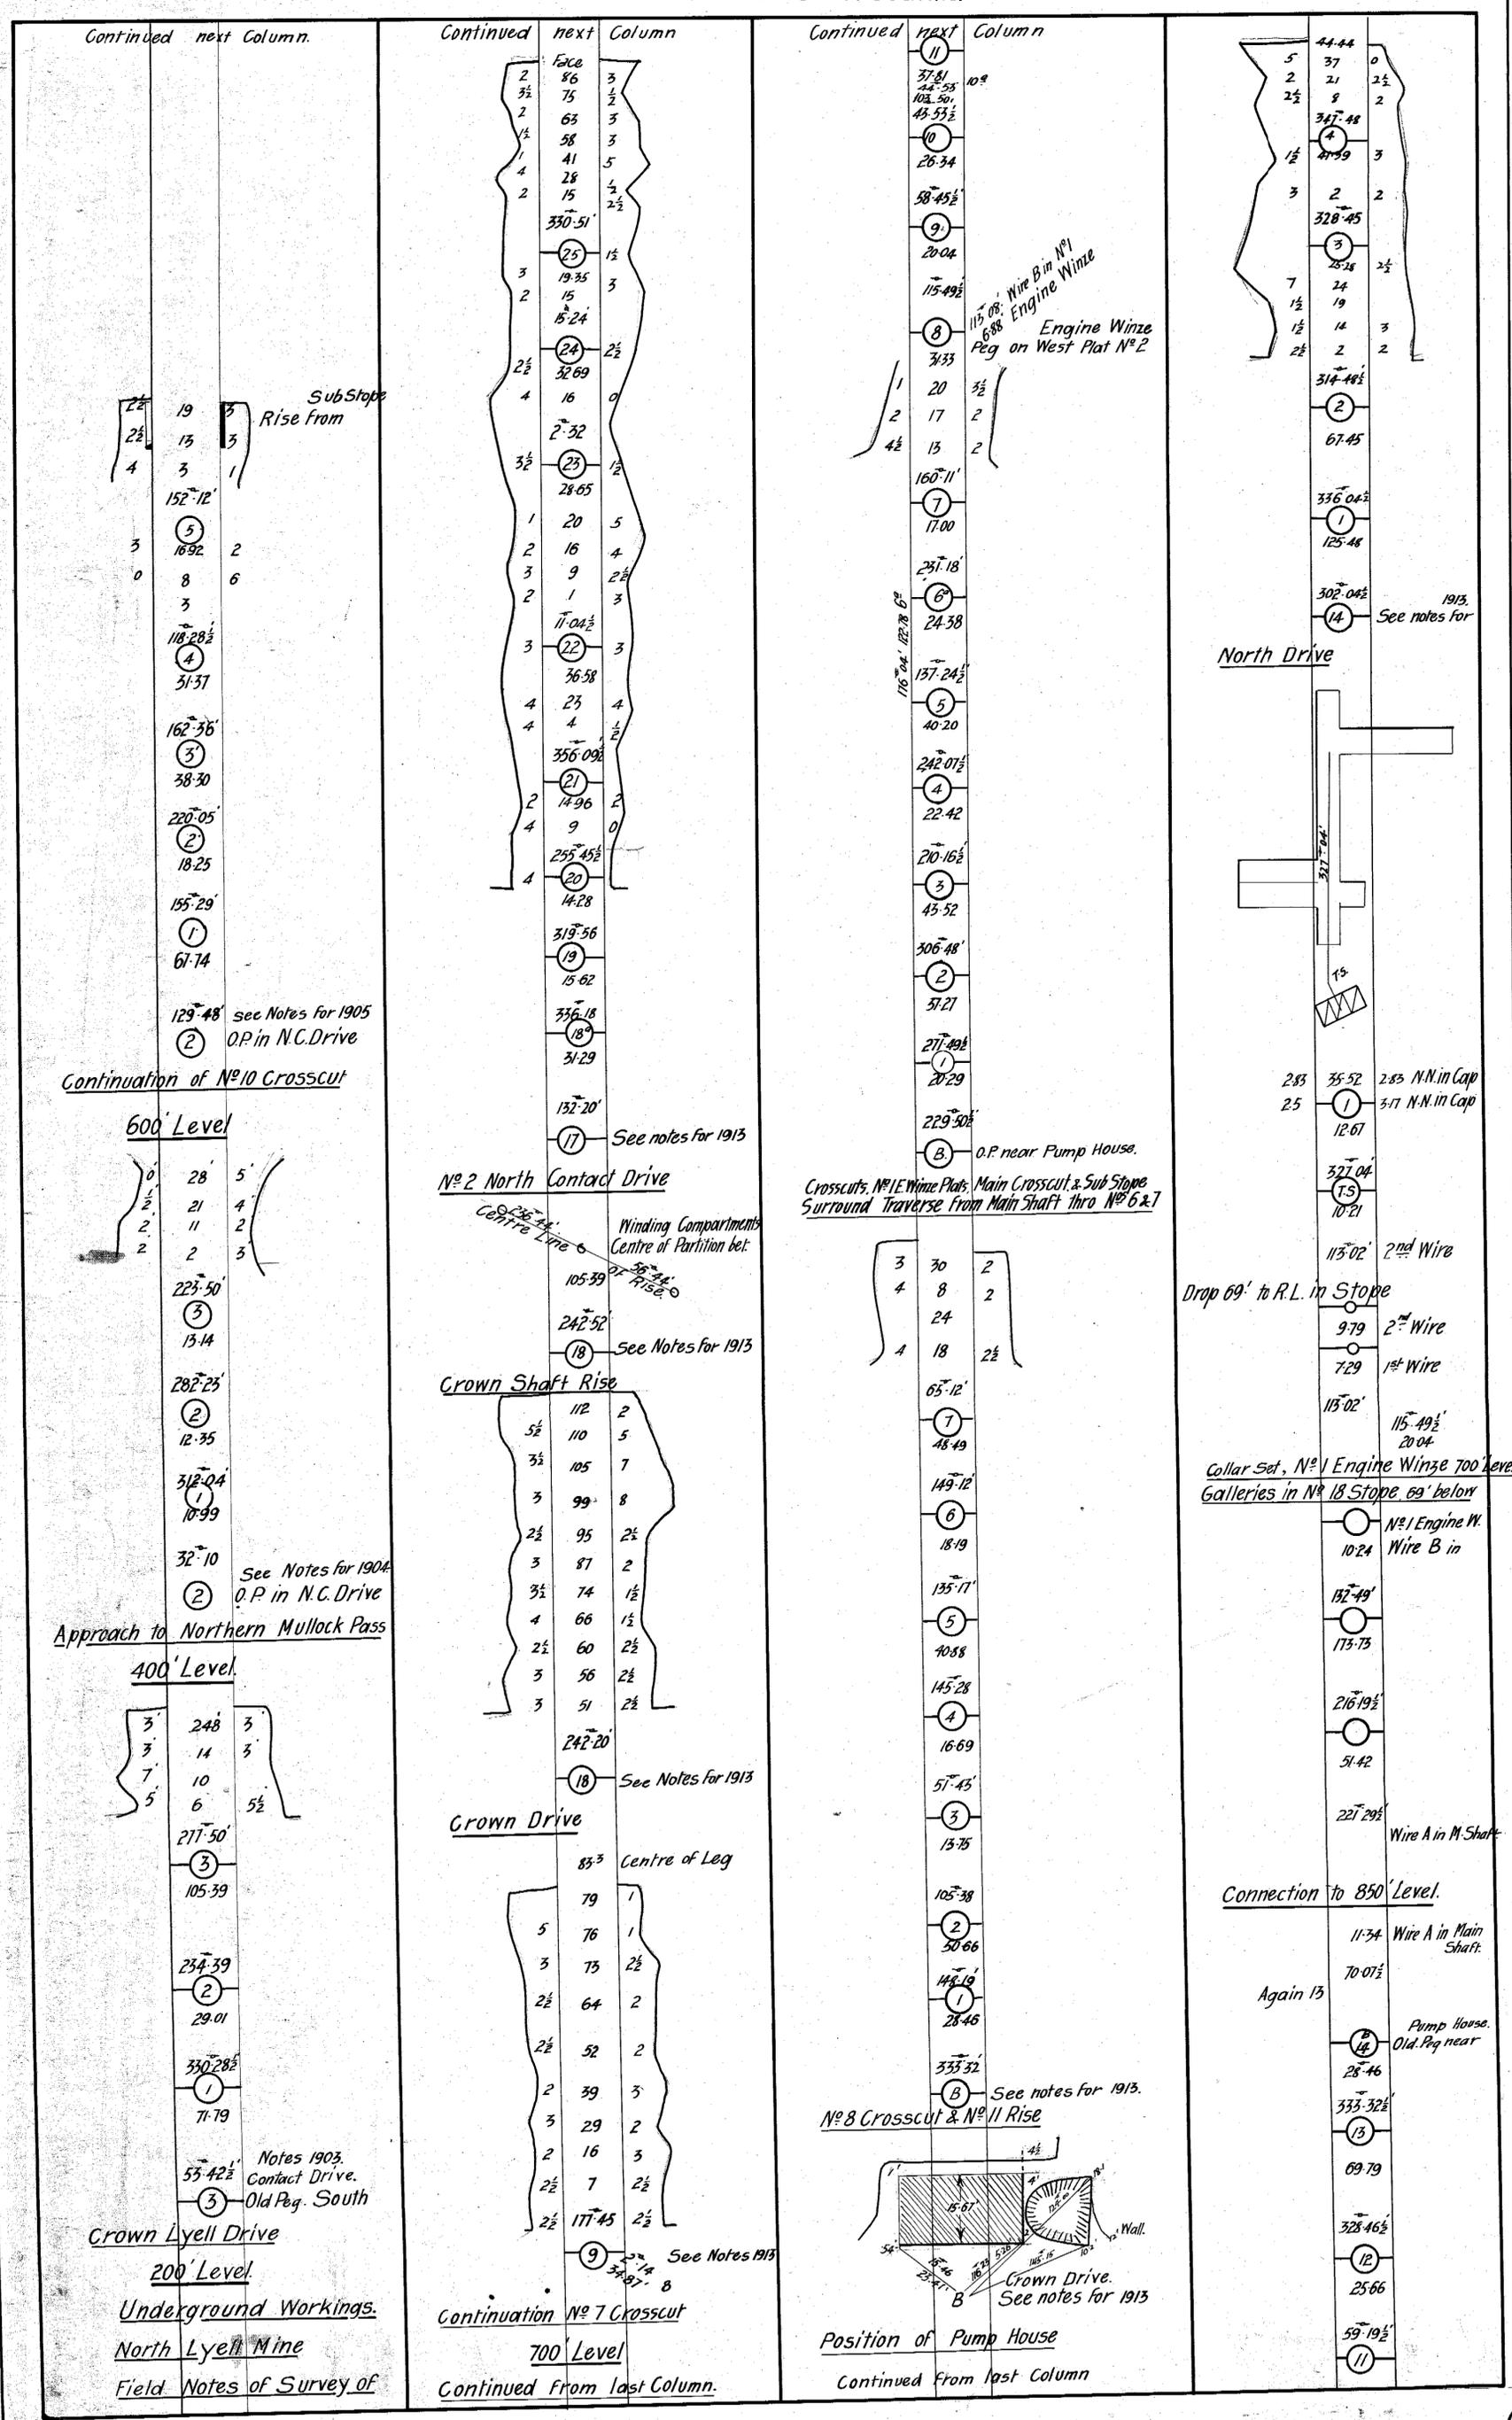

153