

# The Mount Lyell Mining & Railway Co., Ltd.


SHEET No. 1.

Mine Department.

Field Notes of Underground Workings up to 31.12.11.

Instrument used 5" Theodolite.

General Manager, *Robert Smith*  
Engineer-in-Charge, *William Murray*

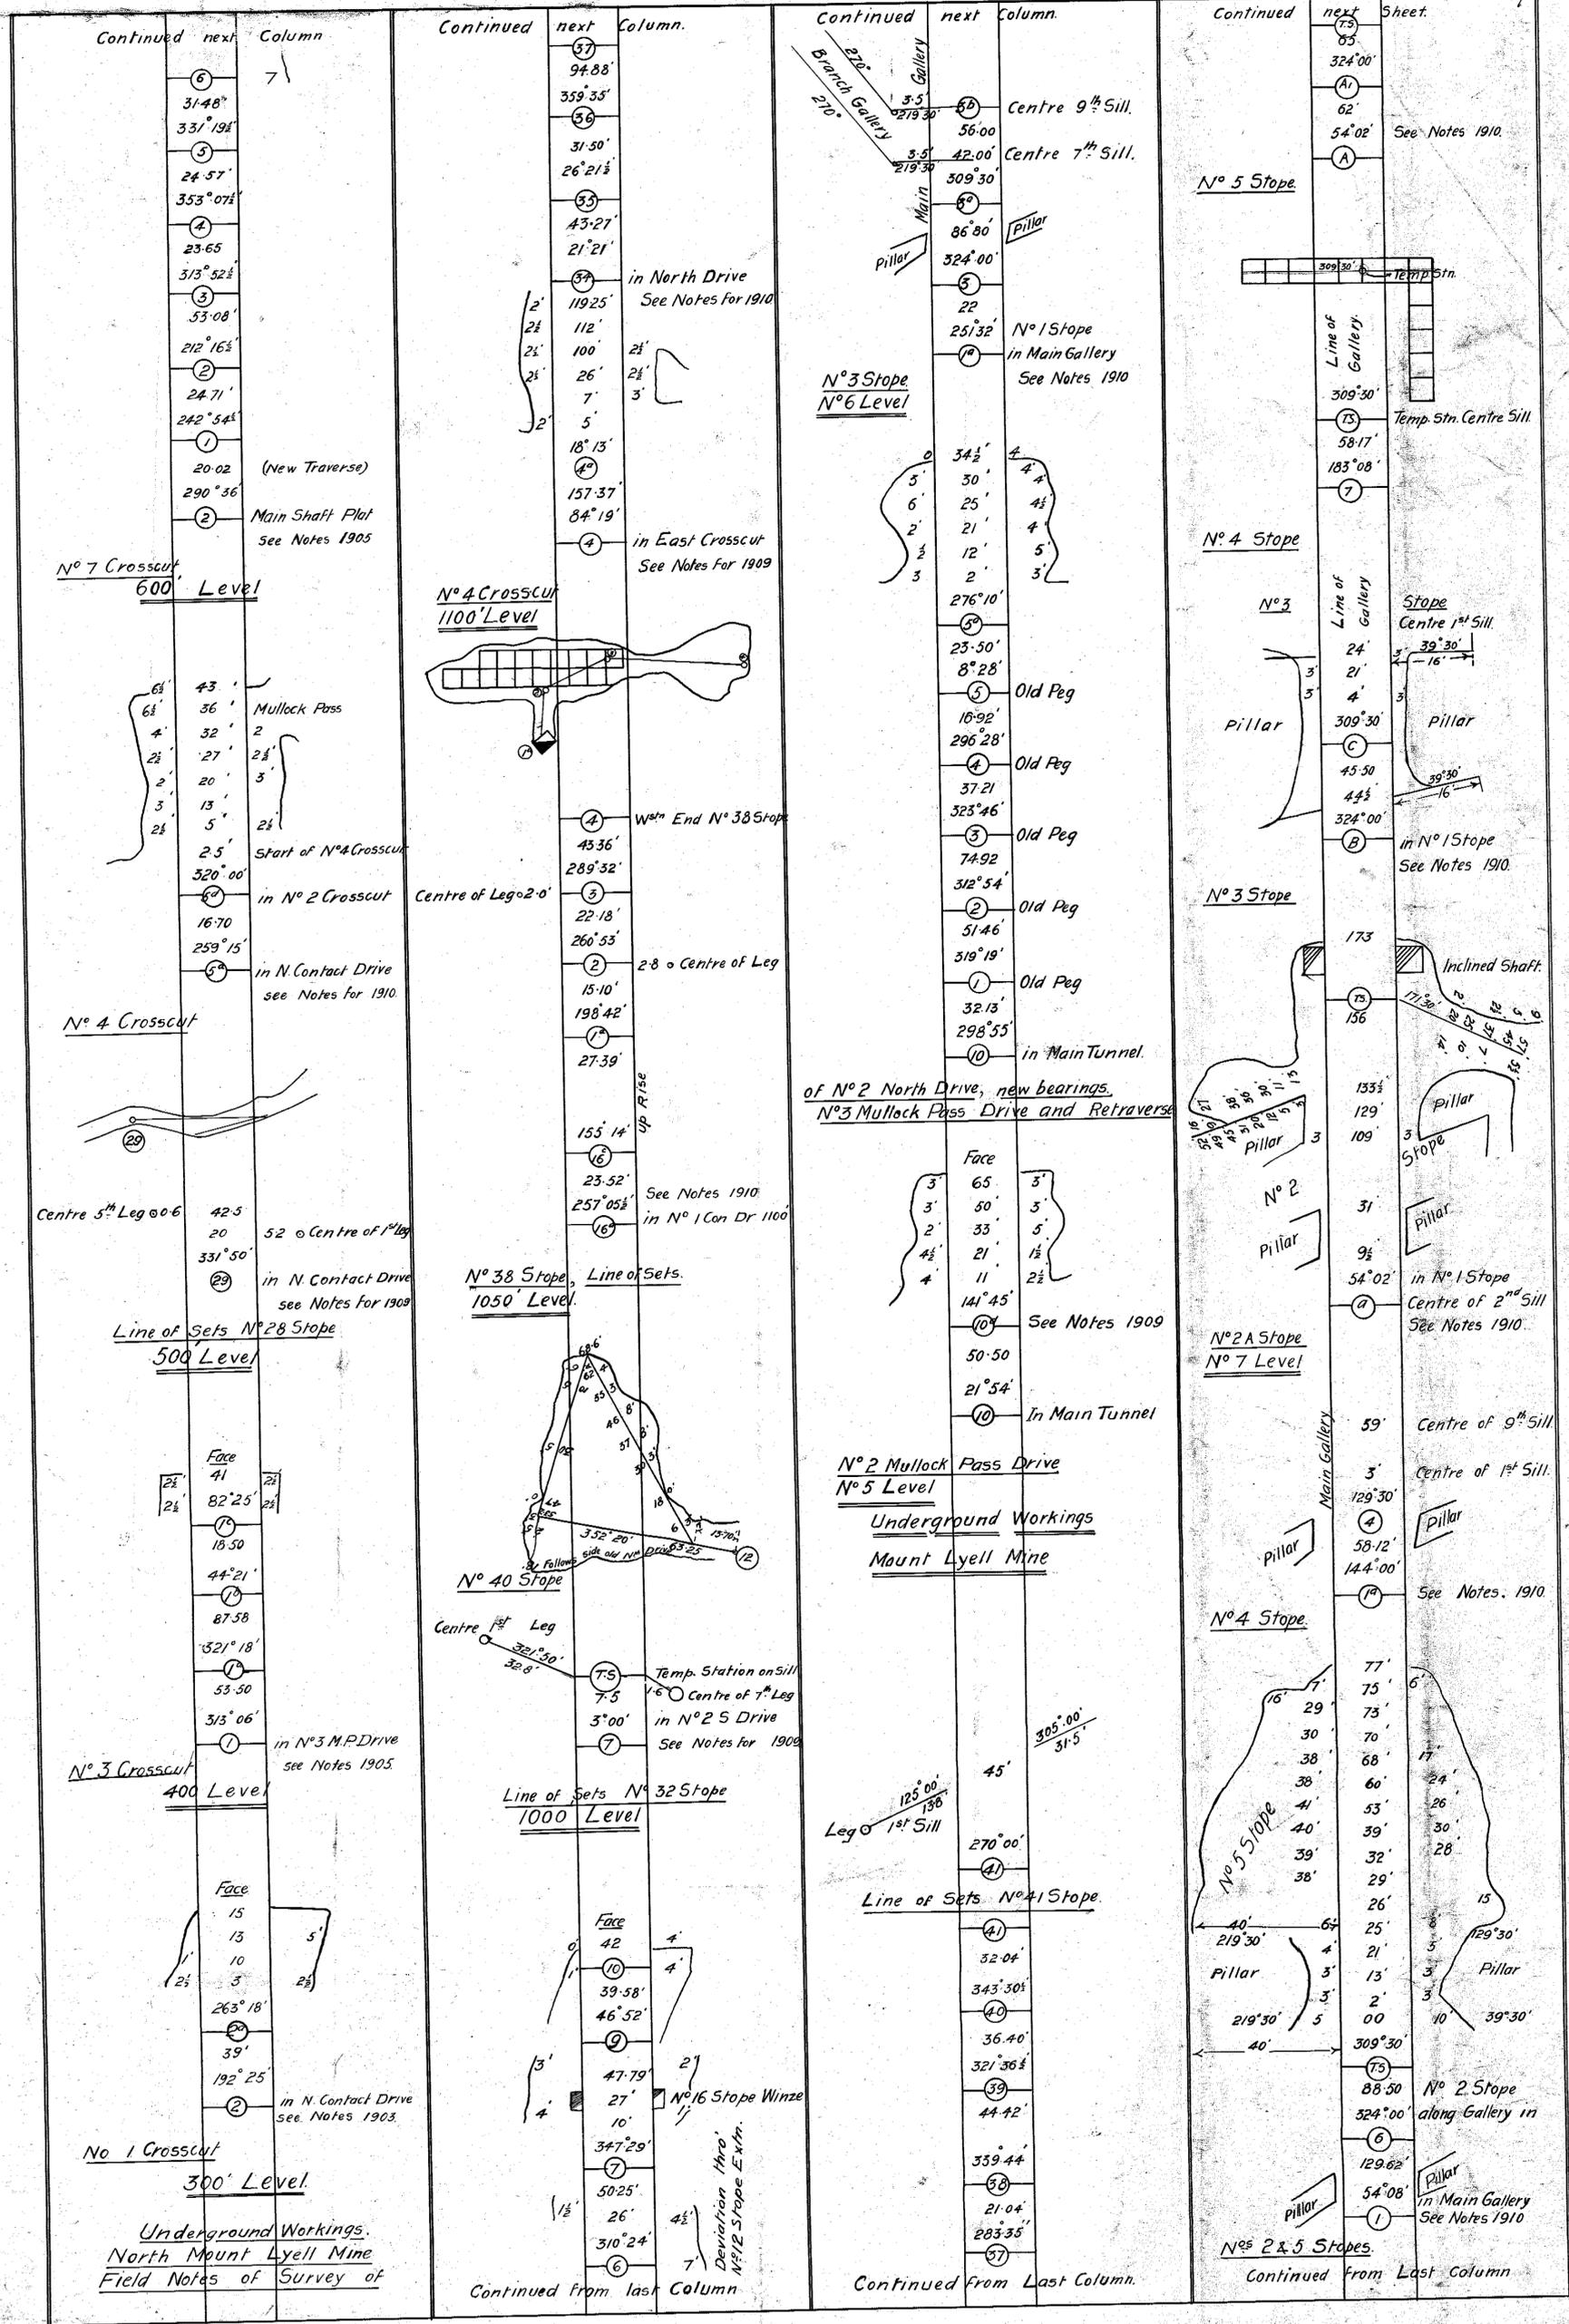

Underground Workings,  
North Mount Lyell Mine  
Field Notes of Survey of

Continued from last Column.

Continued from Last Column.

Continued from Last Column