

# The Mount Lyell Mining & Railway Co., Ltd.

SHEET No 5













Mine Department.

20-11-04

Field Notes of Underground Workings up to Dec 31st 1903

Instrument used - 5" Theodolite

Genl. Manager *R. J. ...*  
Engineer in Charge *H. J. ...*

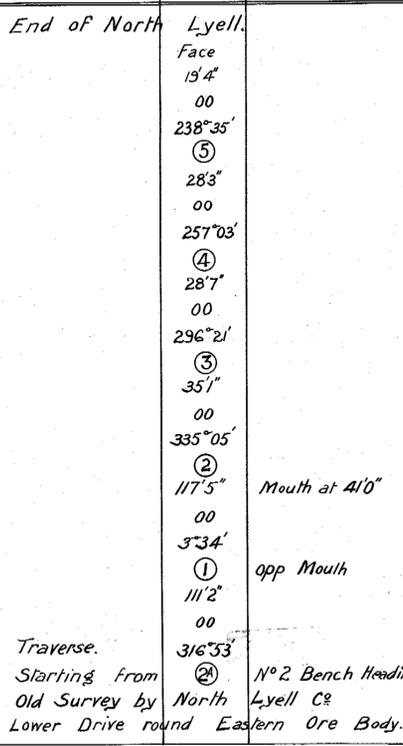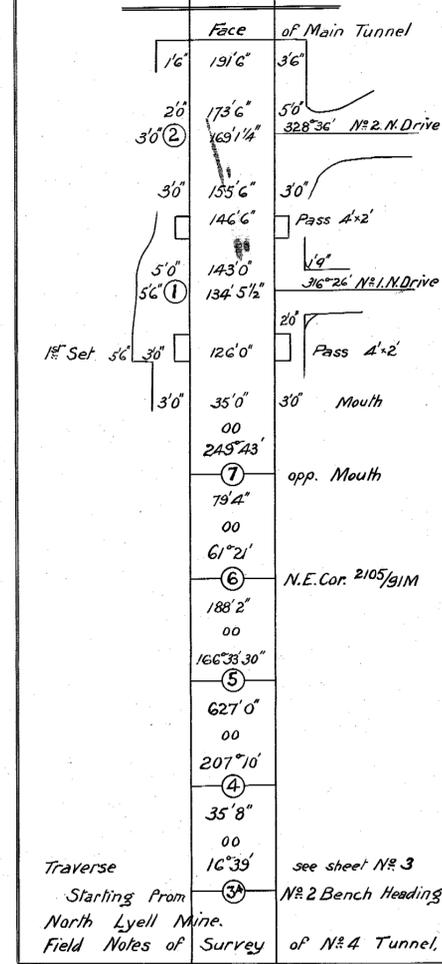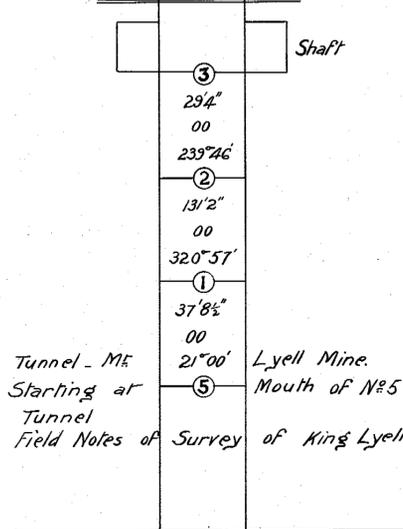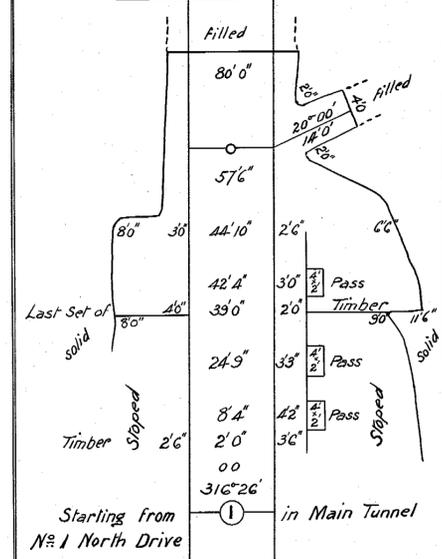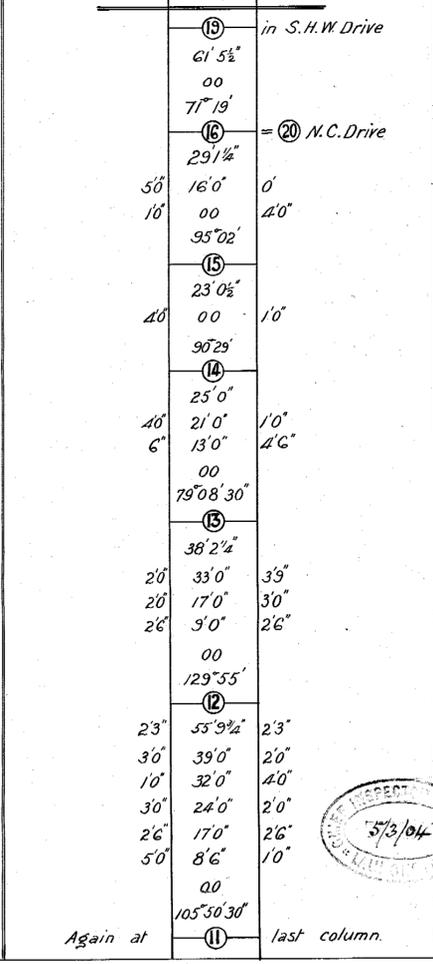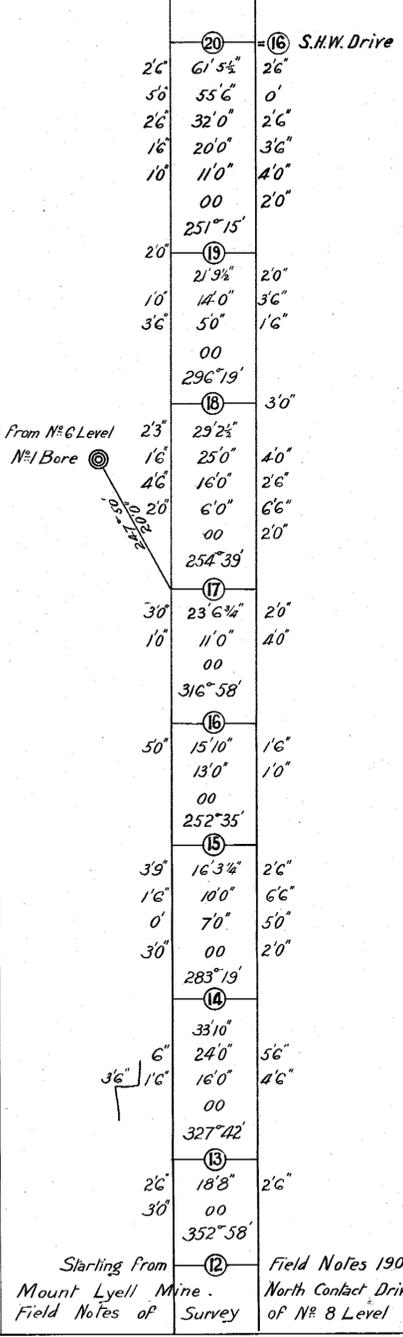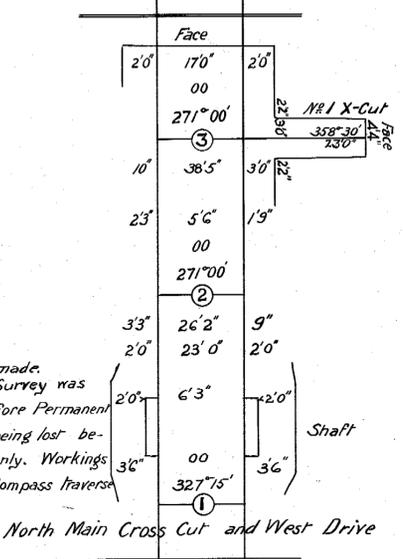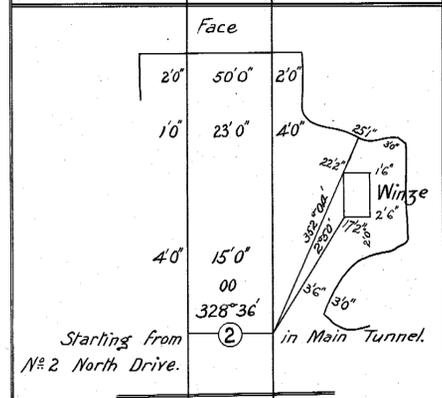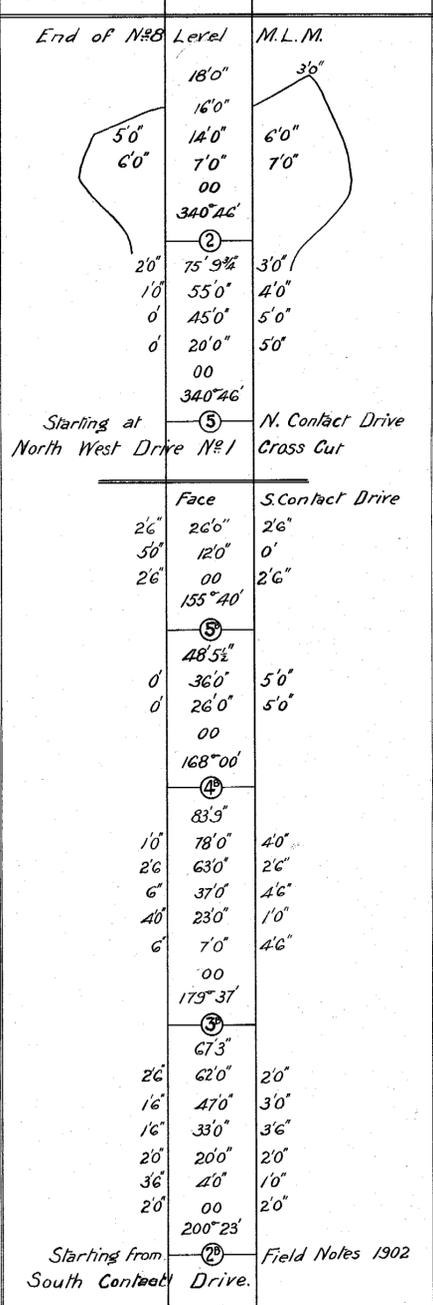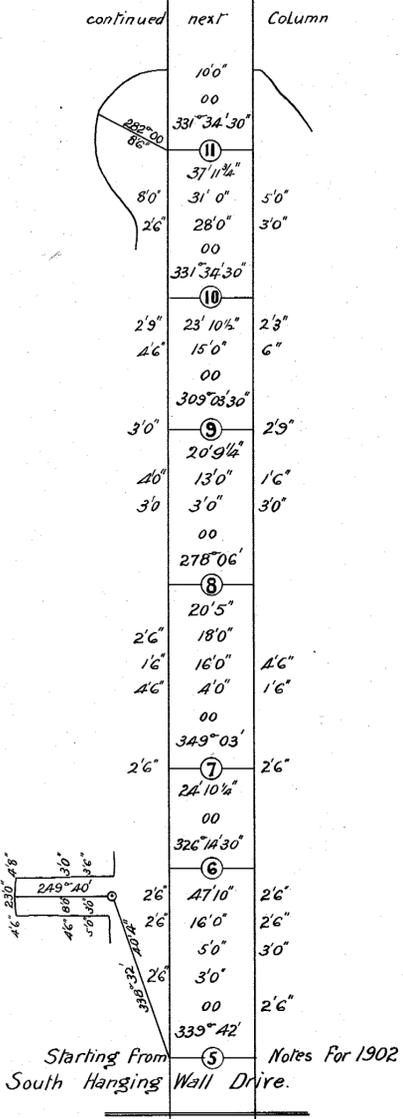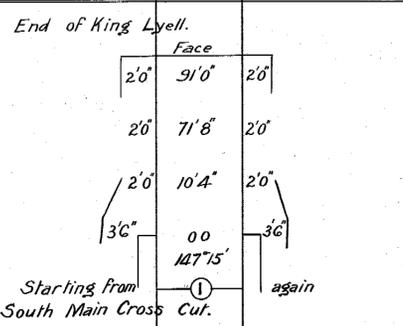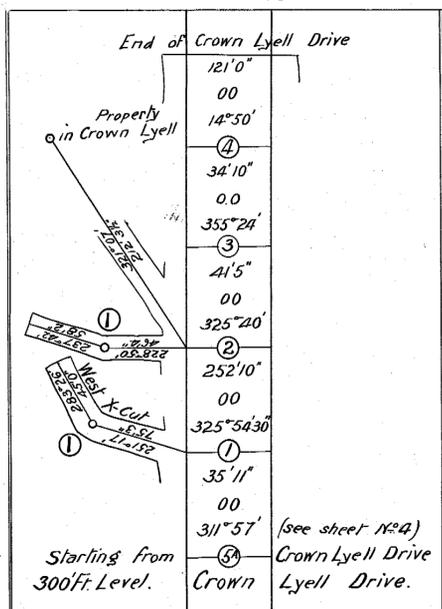

5/3/04