


The Mount Lyell Mining & Railway Co., Ltd.

Mine Department.

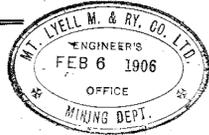


SHEET No. 1

Field Notes of Underground Workings up to Dec 31st 1905.

Instrument used - 5" Theodolite

Genl. Manager *Robt. Hunt*
Engineer-in-Charge *W. J. Hutchins*

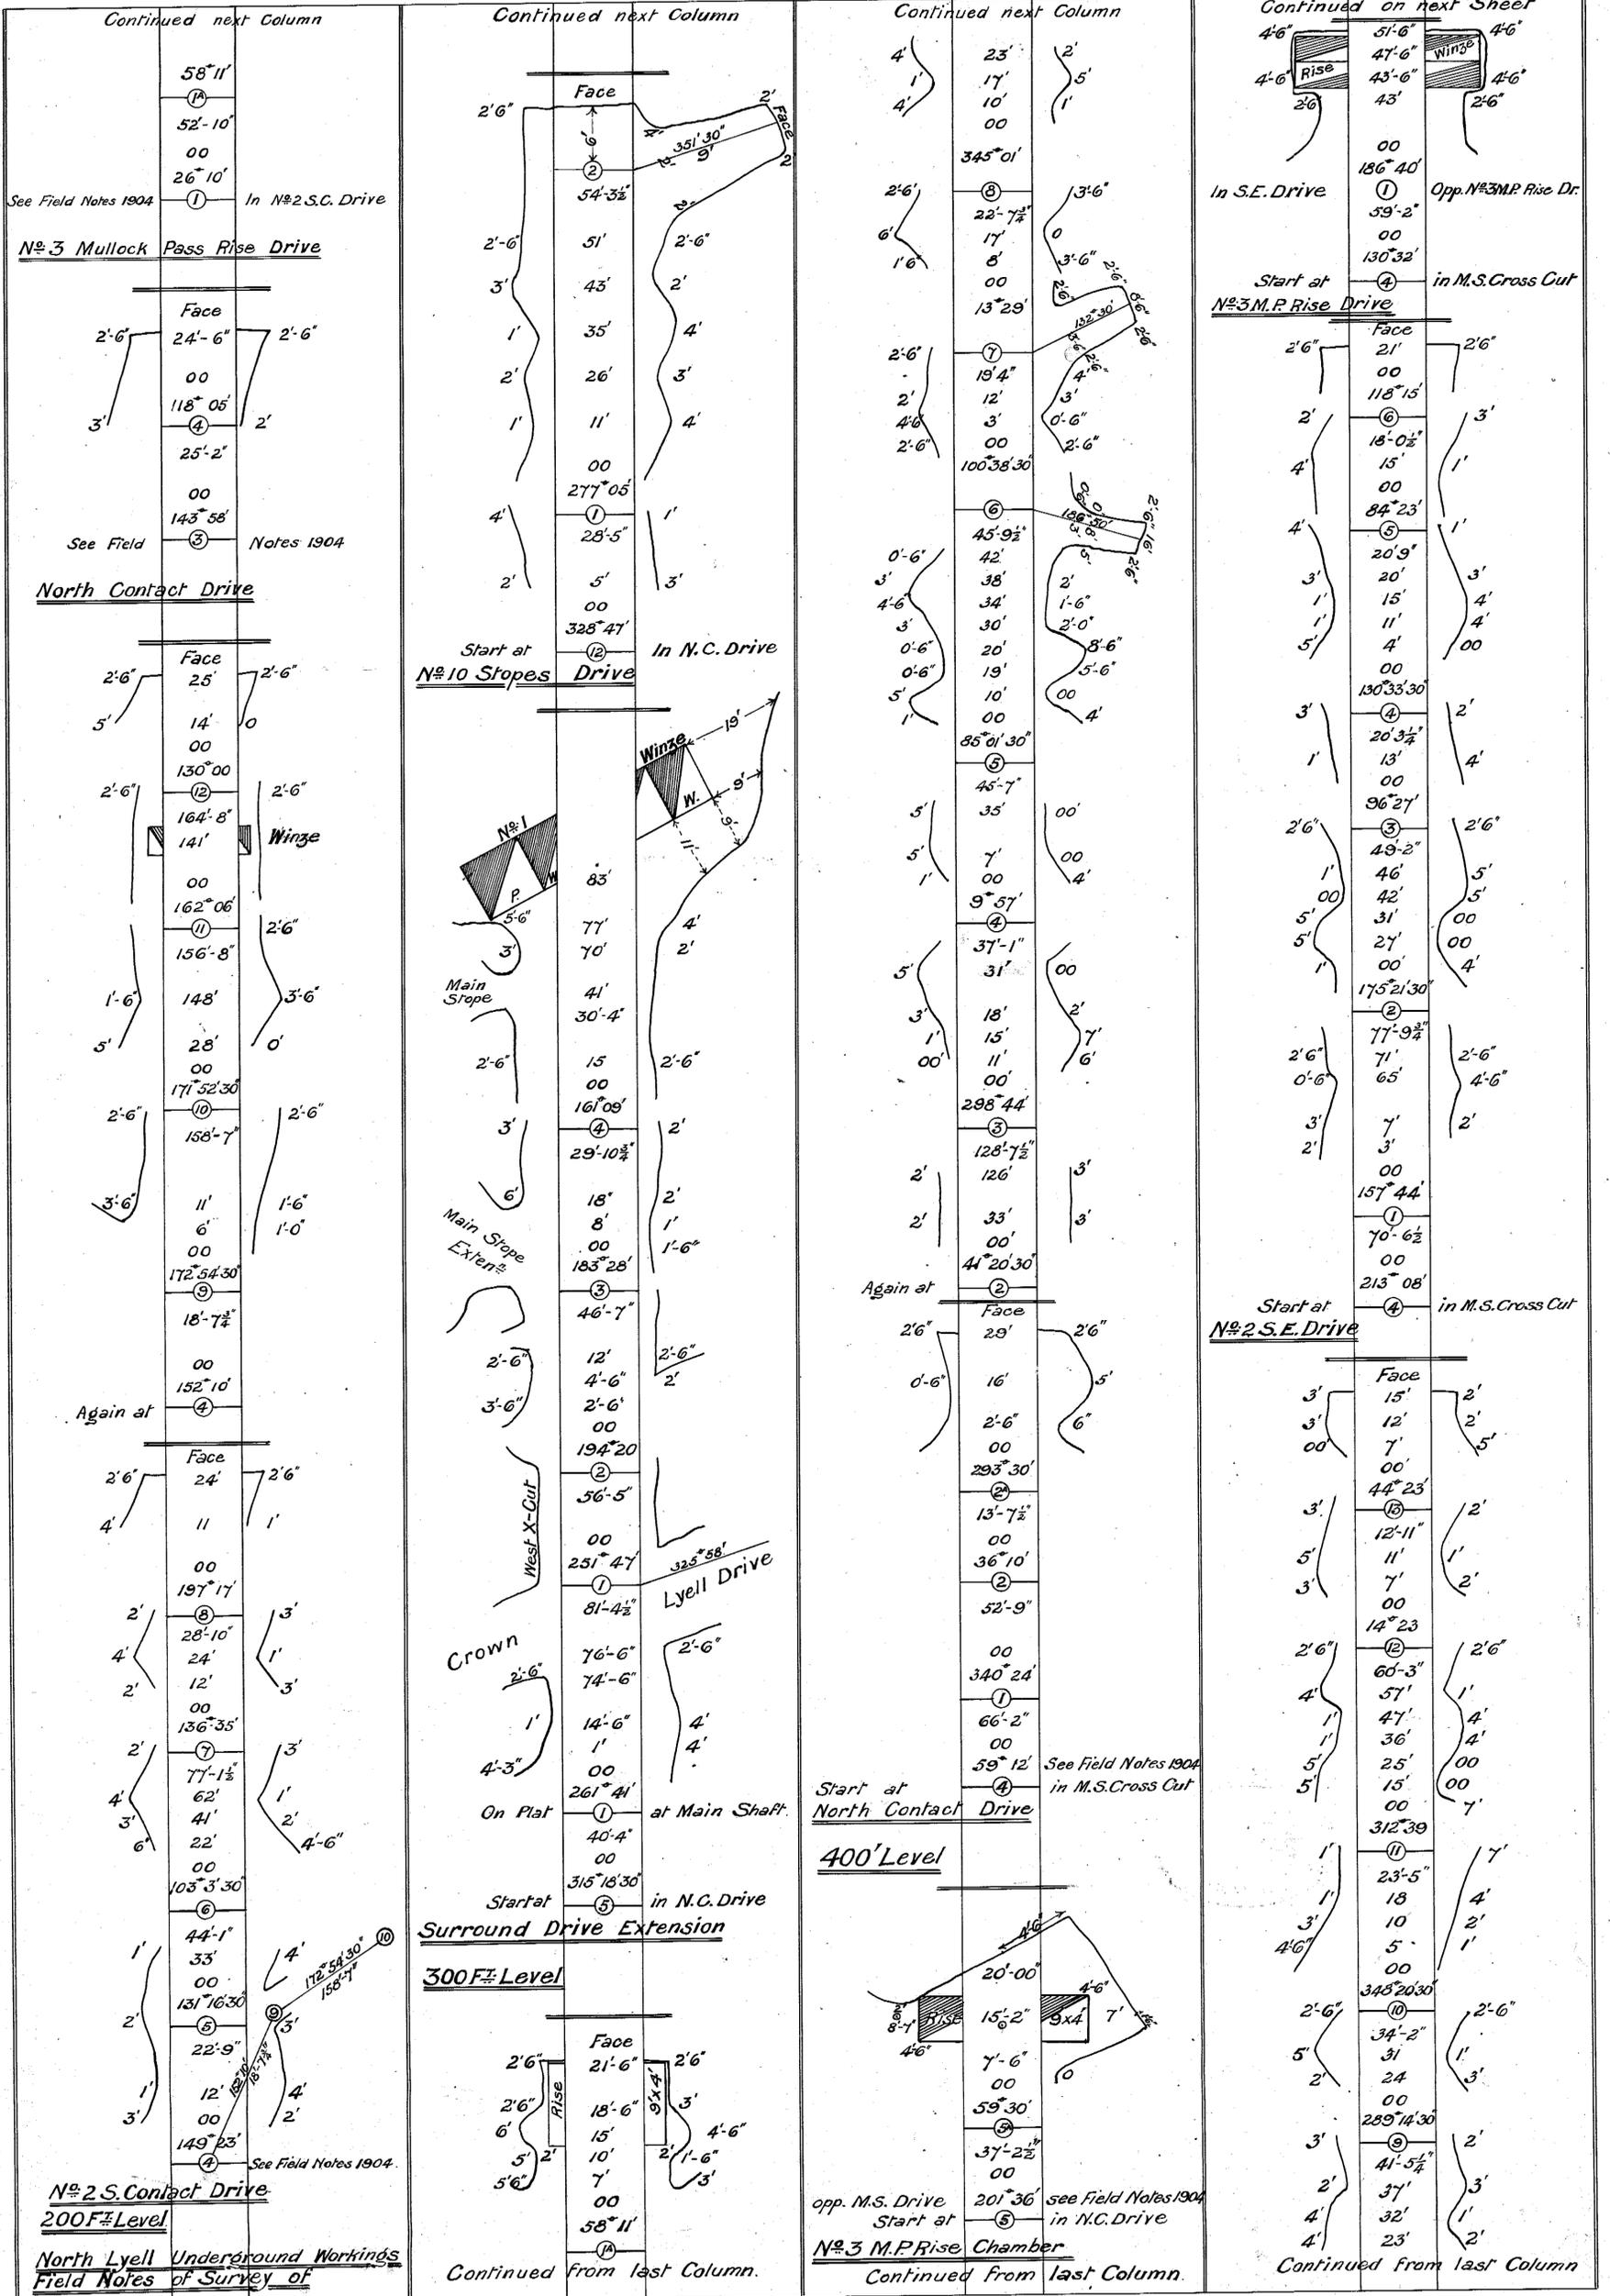

201104 2004/7 11/16