


PLAN

Shewing work done by the
EAST TASMANIA C.M.C^o

During the year 1898
Scale 25 ft to one inch

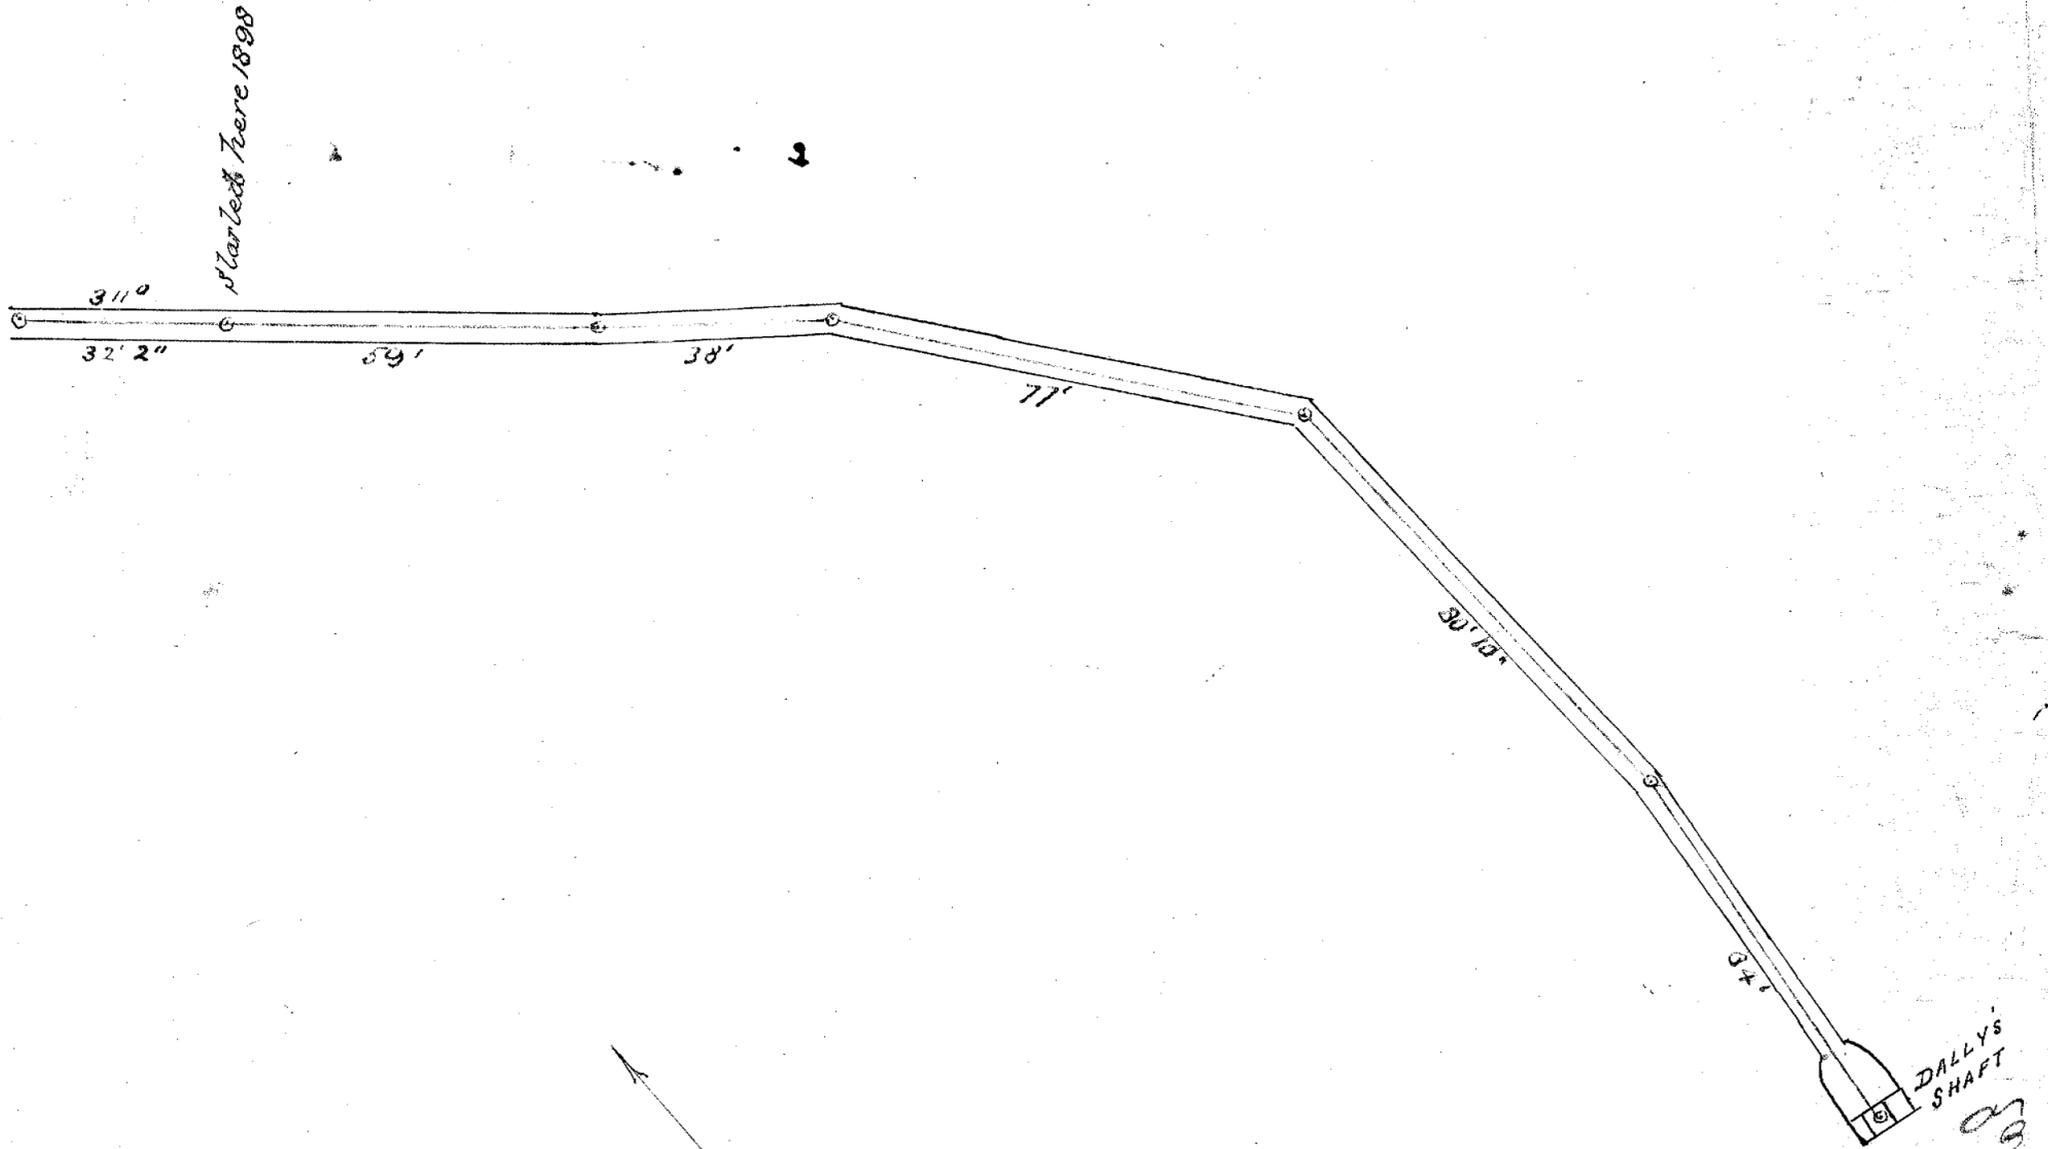

Certified correct for 1898
C. Binley Waterman.
Cuth. Surveys

5 cm

219-01

219-01