


PLAN

Shewing work done by the
EAST TASMANIA G.M.C.

1897

Scale 25ft to one inch.

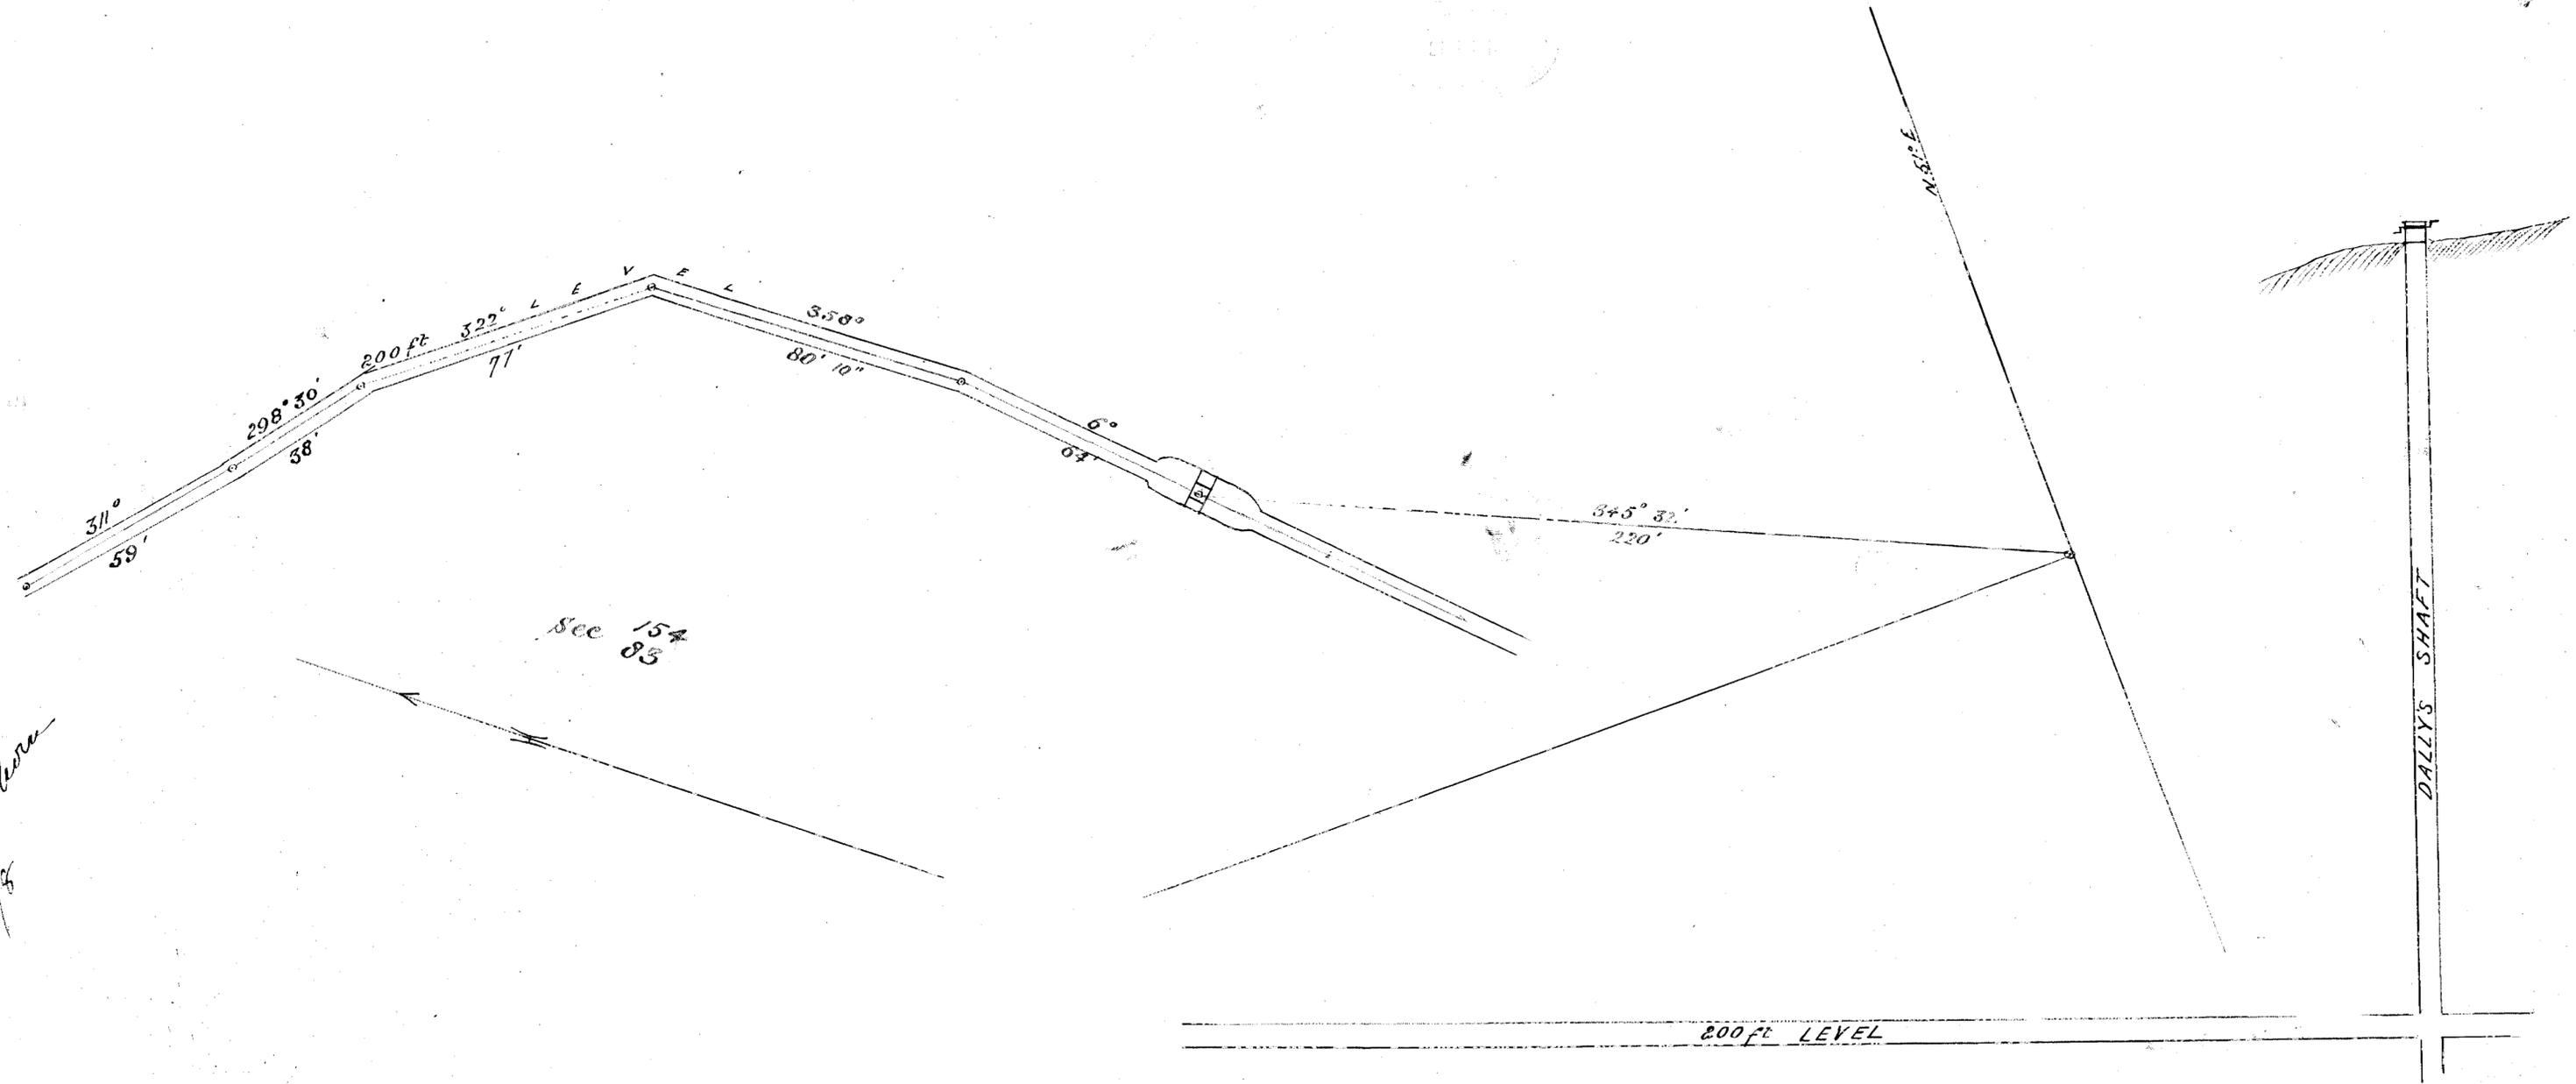

219-83

219-83

5 cm

*Corrected sheet.
C. Binns
25/1/98*

Sec 154
85

200 FT LEVEL

DALLYS SHAFT