


5 cm

1981

220-02

COUNTY OF DEVON
Beaconsfield Goldfield
Scale 25 ft. to an inch

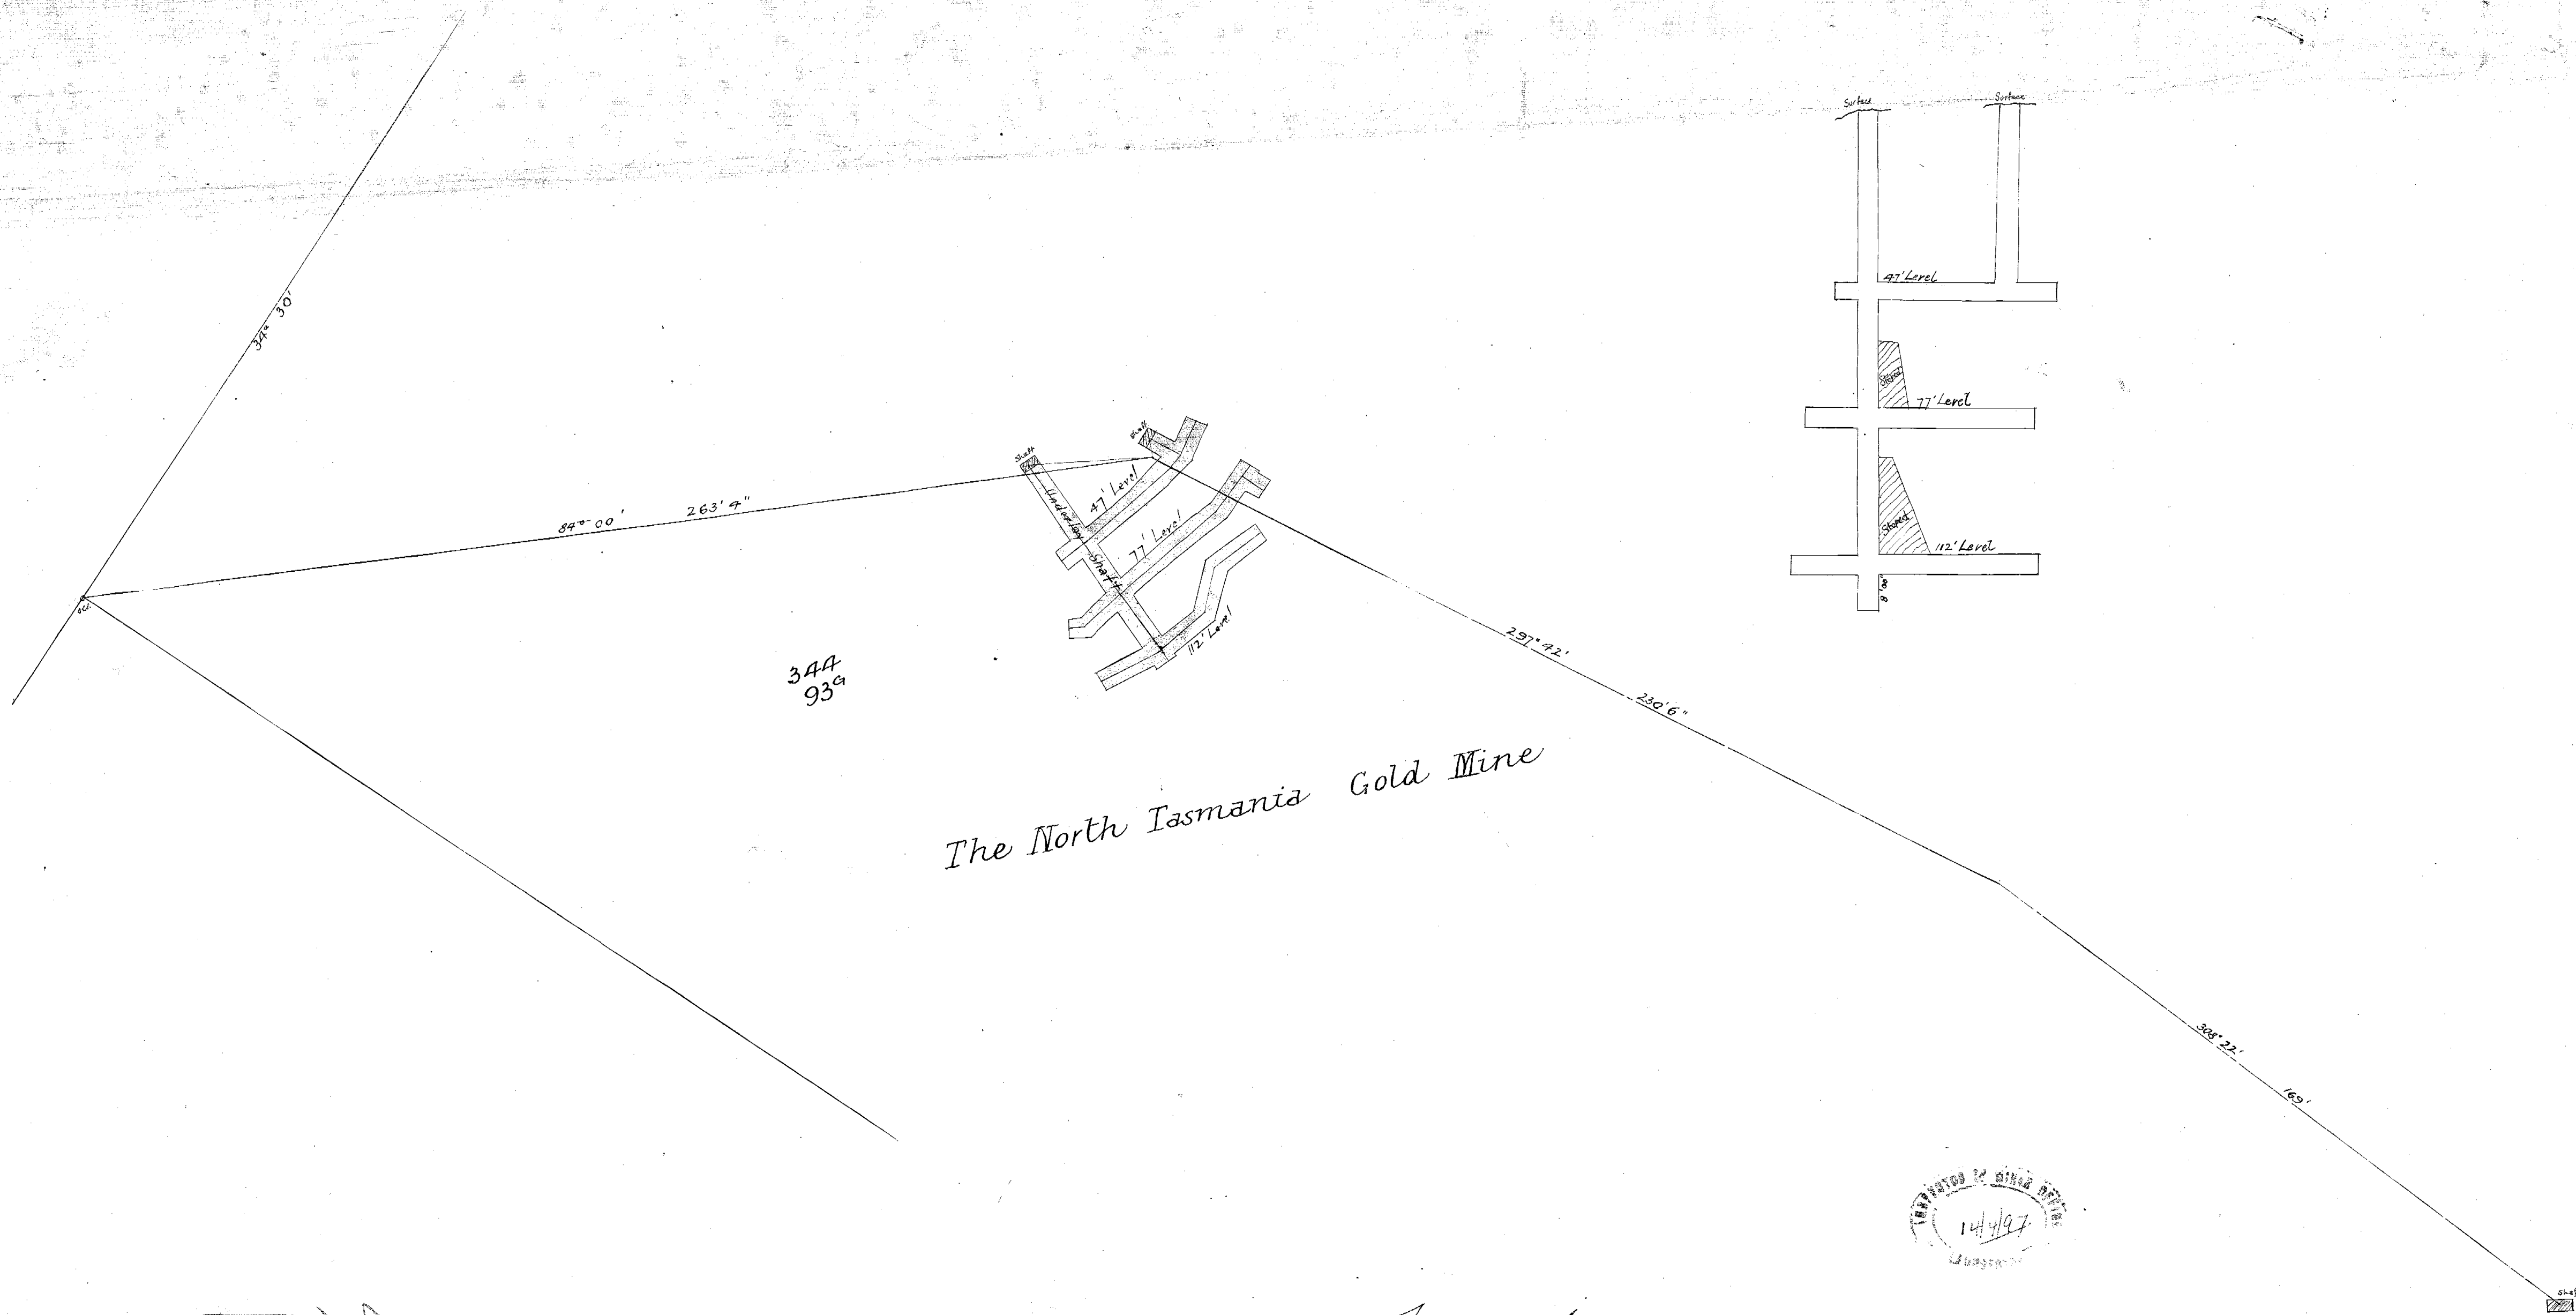

The North Tasmania Gold Mine

DIAGRAM N

Theophilus work
Jas. A. Smith
May 12
Feb. 1897

14/4/97